


SURVEY FOR: SPRING VALLEY HOMES
LOCATION: STONE SCHOOL ROAD


HANSEN

"RECERTIFICATION"
PLAT OF SURVEY

DESCRIPTION: LOT 7 GREYSTONE ESTATES, BEING A PART OF THE SOUTHEAST 1/4 AND SOUTH-WEST 1/4 OF THE NORTHWEST 1/4 AND PART OF THE NORTHEAST AND NORTHWEST 1/4 OF THE SOUTHWEST 1/4 OF SECTION 14, TOWN 4 NORTH, RANGE 18 EAST, IN THE TOWN OF TROY, WALWORTH COUNTY, WISCONSIN.

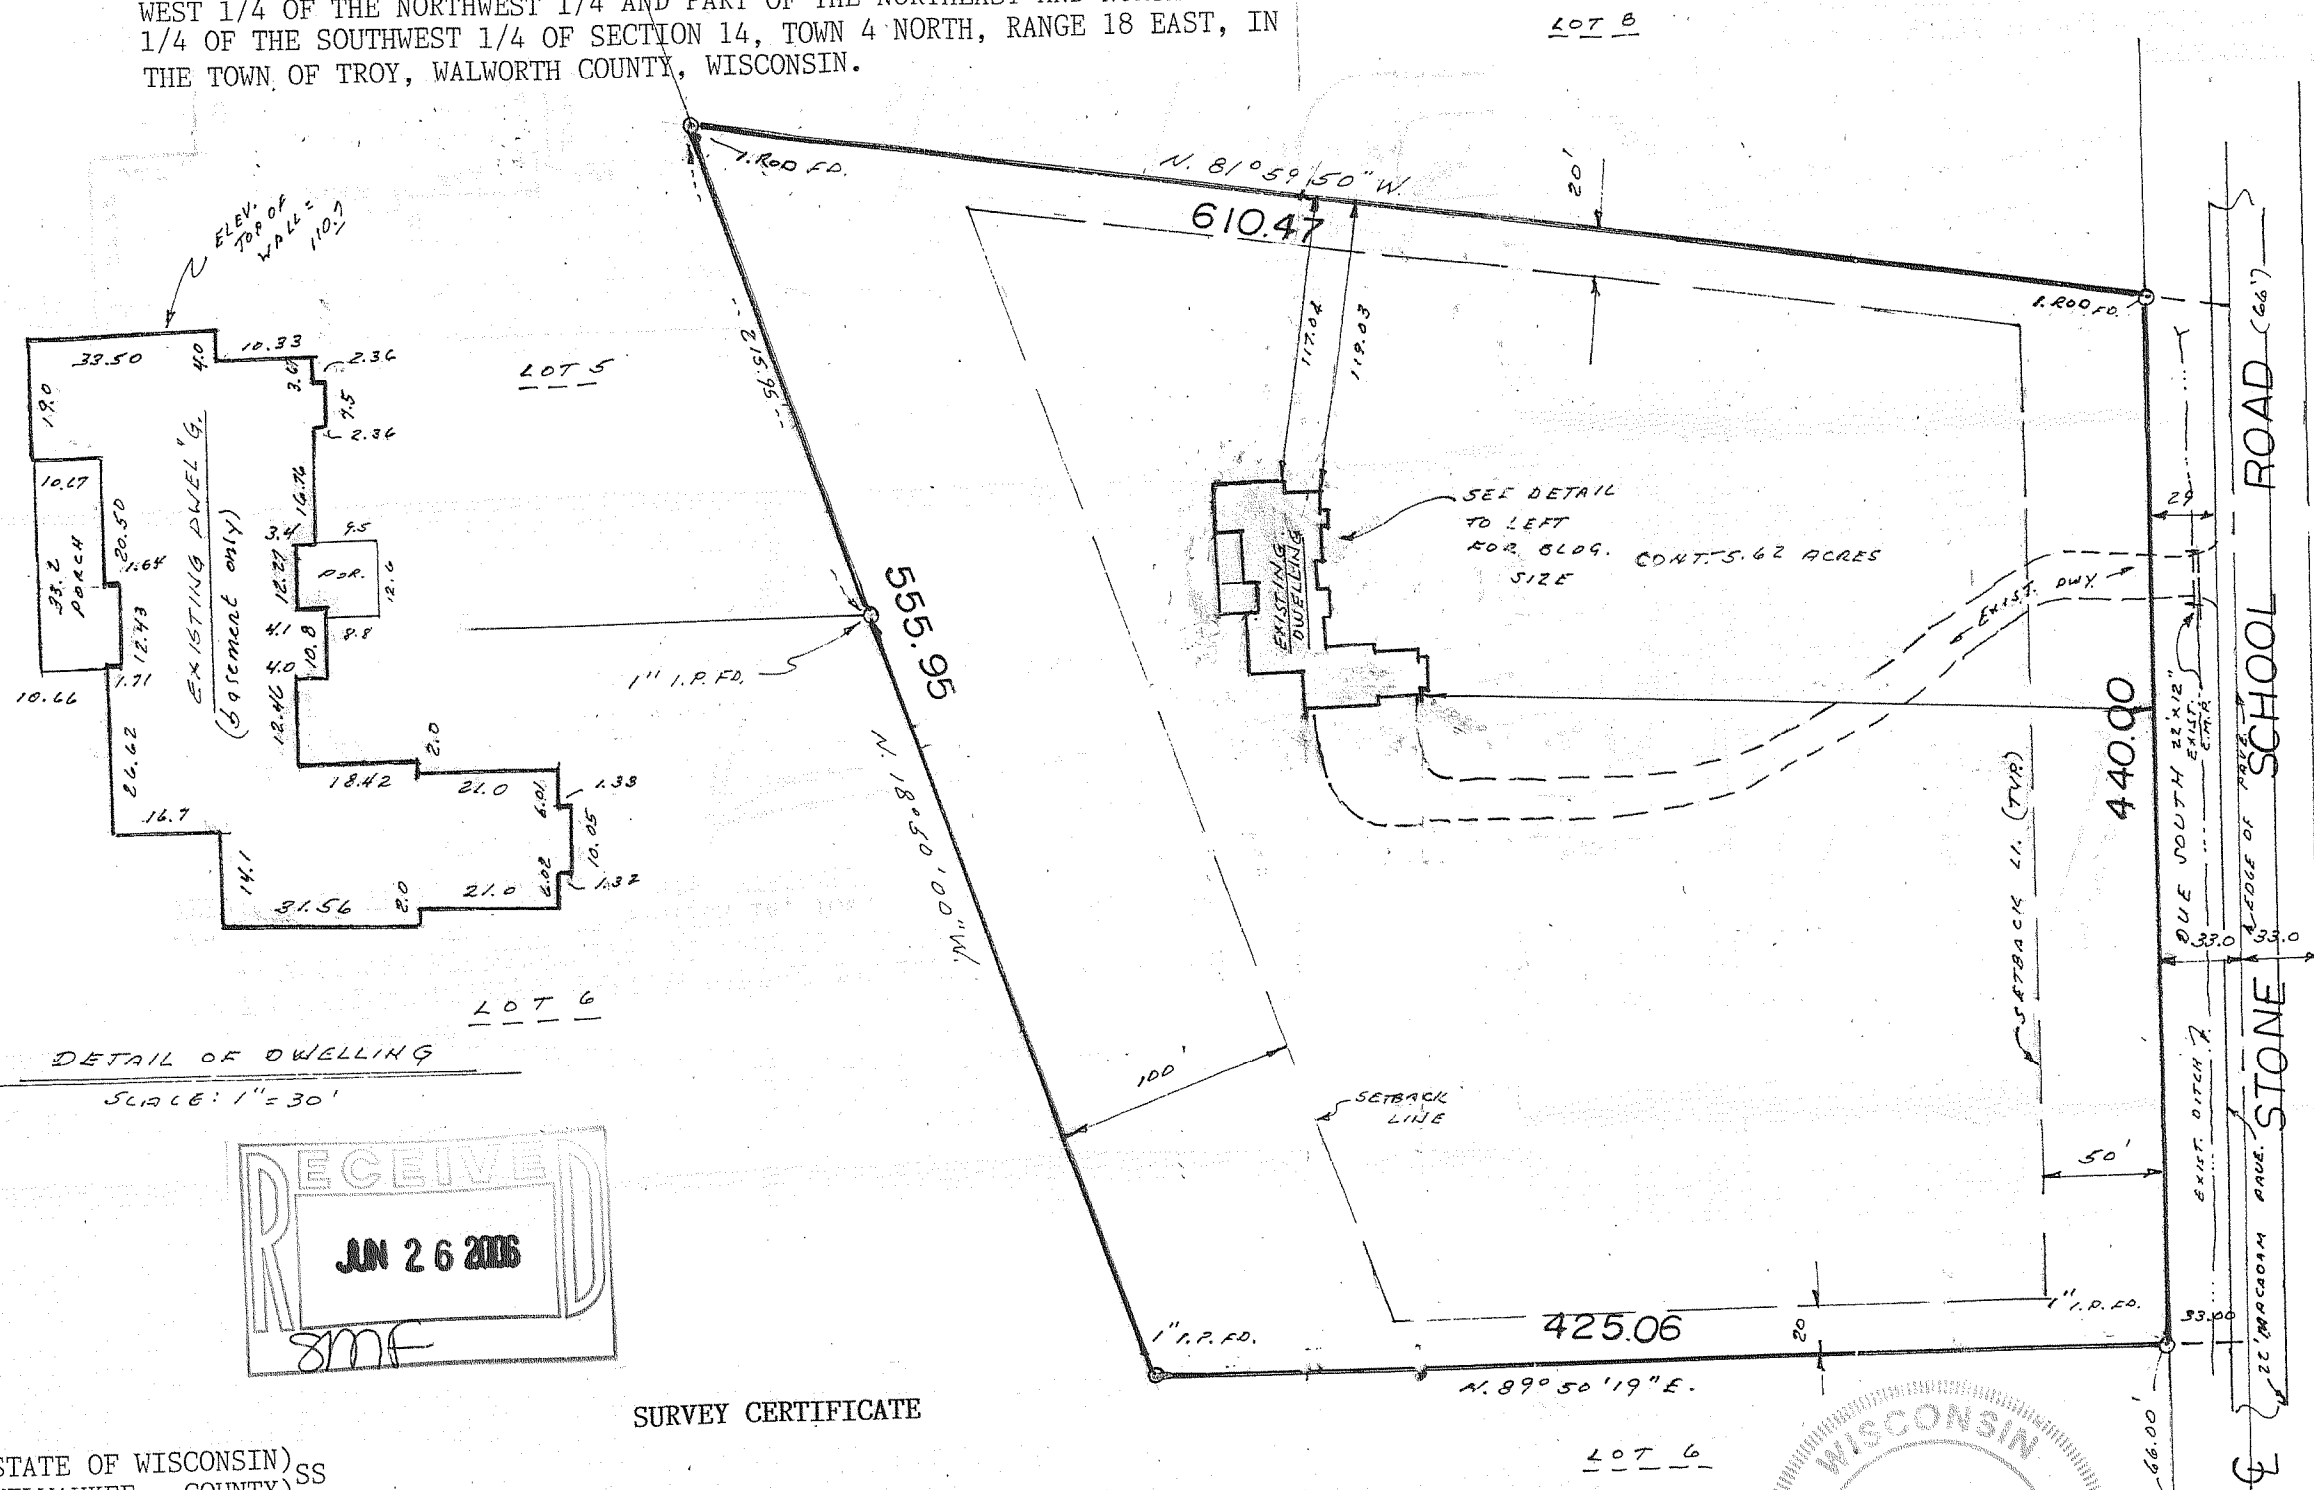

SURVEY CERTIFICATE

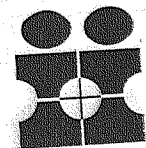

INTERLINE SURVEY
SERVICES, INC.
10521 W. FOREST HOME AVE. STE. 2
HALES CORNERS, WI 53130
PHONE 425-2060

JOB NO. 30685
DATED: 10/24/0