
PLAT OF SURVEY

ERSV ENGINEERING, INC.

Engineers Land Surveyors Environmental Scientists
112 S. MAIN STREET. JEFFERSON. WISCONSIN 53549 (920)674-3411

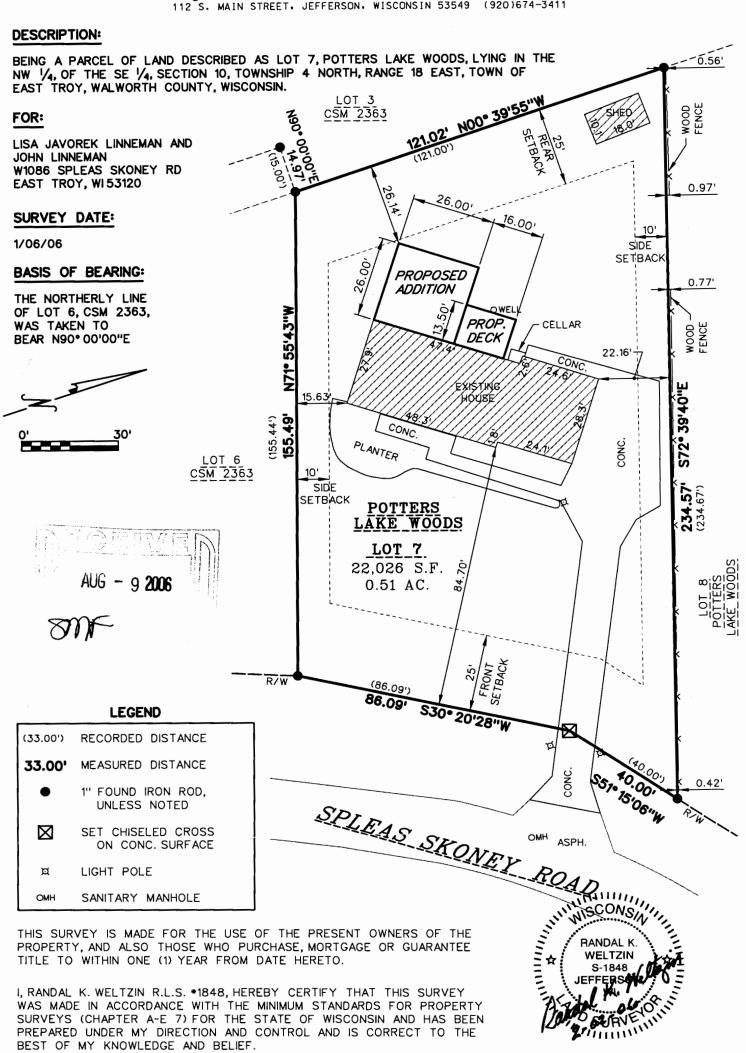

RSV JOB•: 06-500 LINNEMAN PLOT DATE: 01 FEB 106 FILE NAME: z:\cadd 2006\06500 linneman\06500plat.dan

- 1941

PP1 -7