



LOT 1, BLOCK 17, MIRAMAR ADDITION NO. 1, being a Subdivision of part of the Northwest $\frac{1}{4}$ and part of the Southwest $\frac{1}{4}$ of the Northeast $\frac{1}{4}$ of Section 10, Town 4 North, Range 18 East, Town of East Troy, Walworth County, Wisconsin.

Survey address: N9146 Elm Street

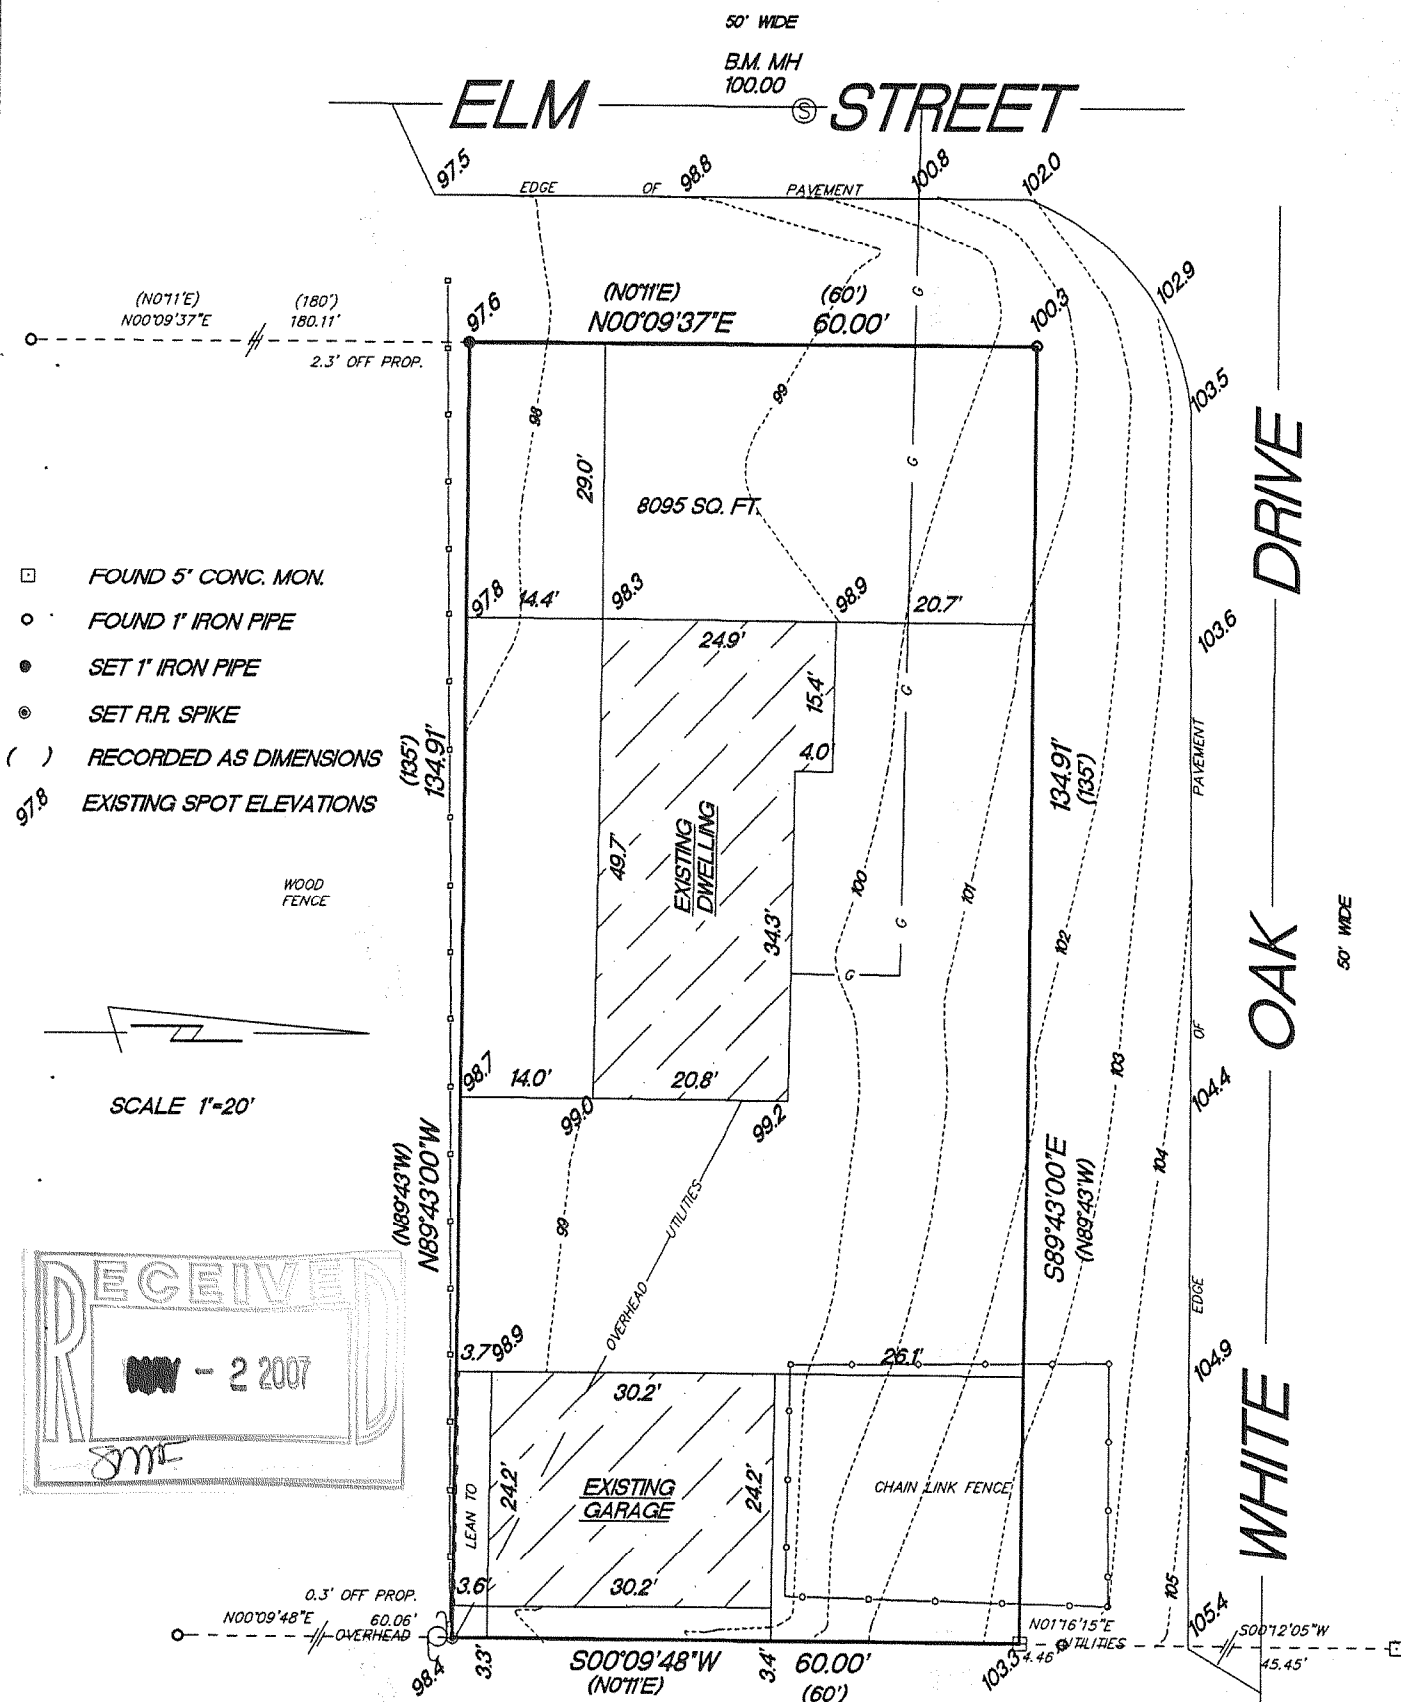

"This survey is made for the use of the present owners of the property, and also those who purchase, mortgage or guarantee the title thereto within one year from date hereof."

Terrance E. Pisarek R.L.S.

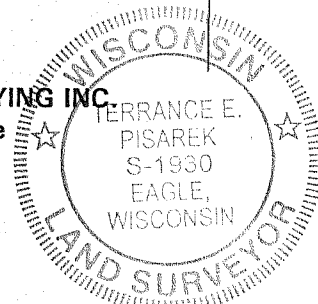

THIS IS NOT AN ORIGINAL SURVEY UNLESS THE SEAL IS RED.

DATE

FIELD WORK BY

DRAWN BY

JOB NUMBER

PMIRI - 1

418-2011