


CS006-8711

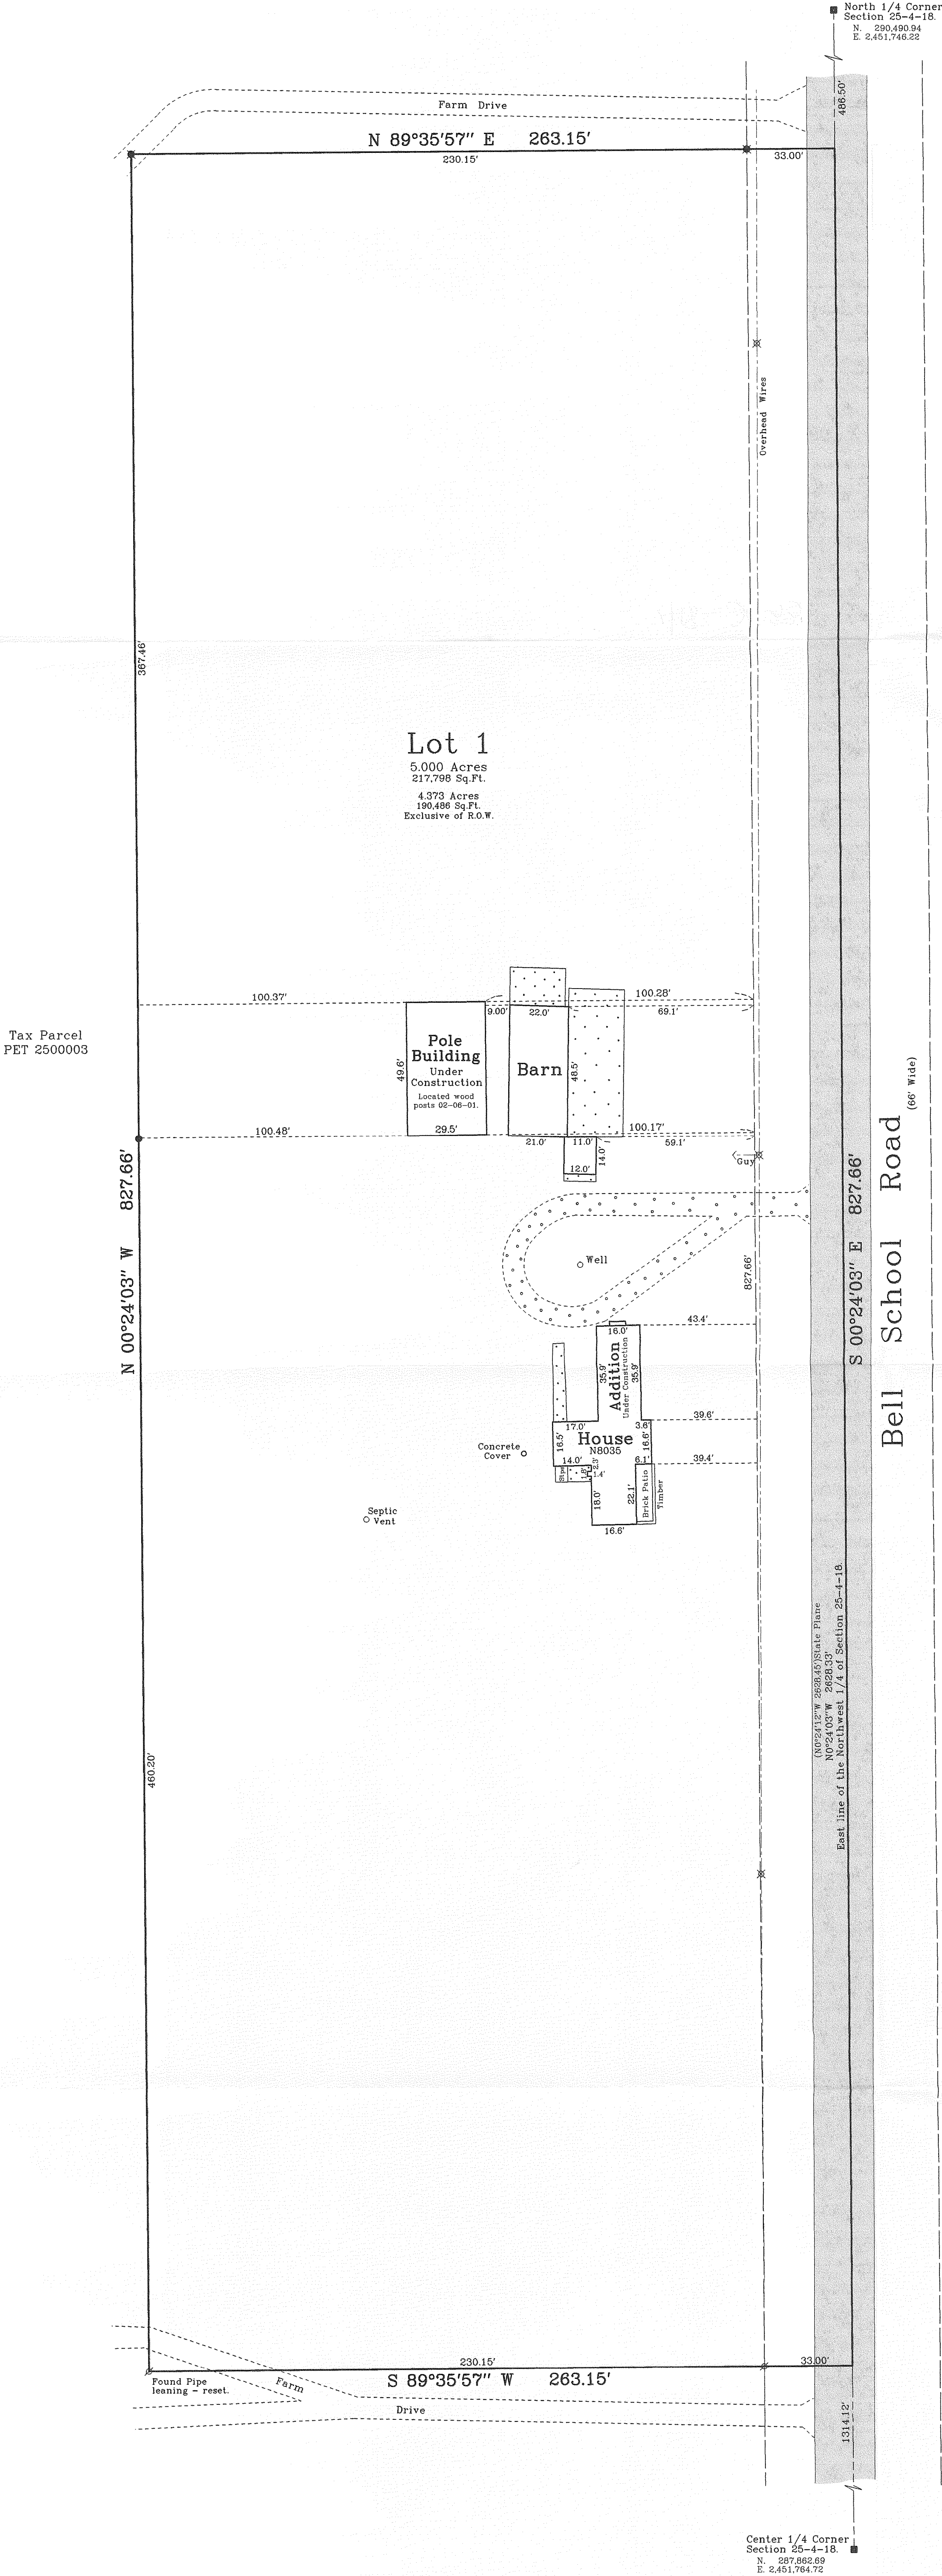


Plat of Survey



of

Lot 1 of Certified Survey Map No. 1287,
recorded in Vol. 6 of Certified Survey Maps of Walworth County on
Page 74 as Document No. 92412 and located in the Northwest 1/4
of Section 25, Town 4 North, Range 18 East, Town of East Troy,
Walworth County, Wisconsin.

Surveyed for: **Mario Reyes**
N8035 Bell School Road
East Troy, Wisconsin. 53120

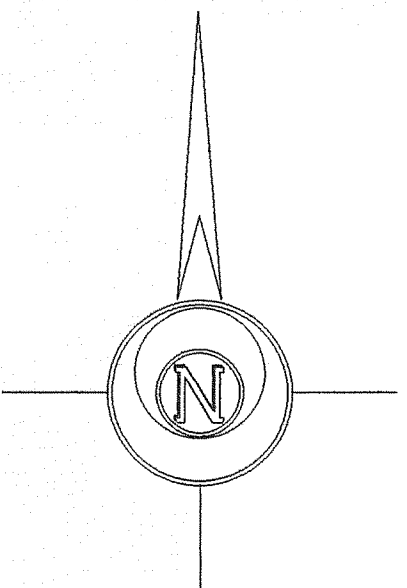

Bearings referenced to CSM. 1287.

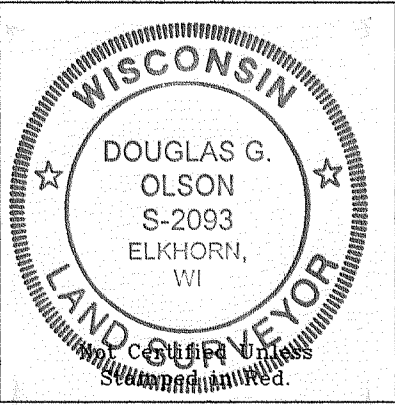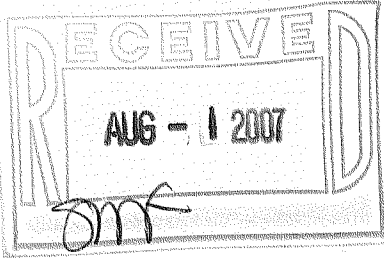

Notes: 1) This survey plat is not
certified unless signed
and sealed in red ink.
2) This survey is subject to Wisconsin lien laws.
This Plat of Survey is the notice of intent
to file lien. Lien waiver required.

Copyright c 2007 by Jensen & Olson Land Surveying, LLC.
All rights reserved. No part of this survey plat may be reproduced
or transmitted in any form by any means - graphic, electronic, or
mechanical, including photocopying, tracing, or information storage
and retrieval systems - without permission in writing from Douglas
G. Olson, Jensen & Olson Land Surveying, LLC.

I, Douglas G. Olson, Wisconsin Registered Land Surveyor,
do hereby certify that this survey was performed by me or under my
direction in full compliance with the owner's/agent's instructions
and Chapter A-E 7 of the Wisconsin Administrative Code "Minimum
Standards for Property Surveys", and that this map is an accurate
representation thereof to the best of my knowledge and belief.

Douglas G. Olson
Wisconsin Registered Land Surveyor - 2093

2007.040

Sheet 1 of 1 Sheets.

Job Reference Number
2007.040

Legend

- Found County Monument
- Found Iron Pipe
- Set Iron Rod, 5/4" dia.
- Found Iron Rod
- Recorded Information
- Utility Pole
- Concrete Surface
- Asphalt Surface
- Gravel Surface




Jensen & Olson Land Surveying, LLC

45 South Wisconsin Street P.O. Box 322
Elkhorn, Wisconsin. 53121
Telephone: (262) 723-3434
Facsimile: (262) 723-8044

Scale in Feet

1" = 30'

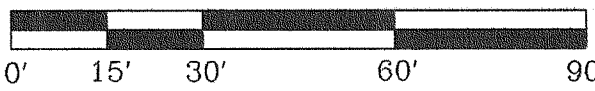

Survey date: February 6, 2001.
Revisions: No. 1 - House Addition

PA1287-1

418-2033