

PREPARED FOR
BECKY TAYLOR
W984 WHITE OAK DR.
EAST TROY WI 53120


PLAT OF SURVEY

-OF-

LOTS 11 AND 12 IN BLOCK 11 OF MIRAMAR SUBDIVISION
LOCATED IN SECTIONS 10 AND 11, TOWNSHIP 4 NORTH,
RANGE 18 EAST, IN TOWN OF EAST TROY, WALWORTH
COUNTY, WISCONSIN.


KROTT SURVEYING INC.

N3705 WILLOW BEND LANE
LAKE GENEVA WI. 53147
PHONE # (262)248-3697
FAX # (262)249-0639

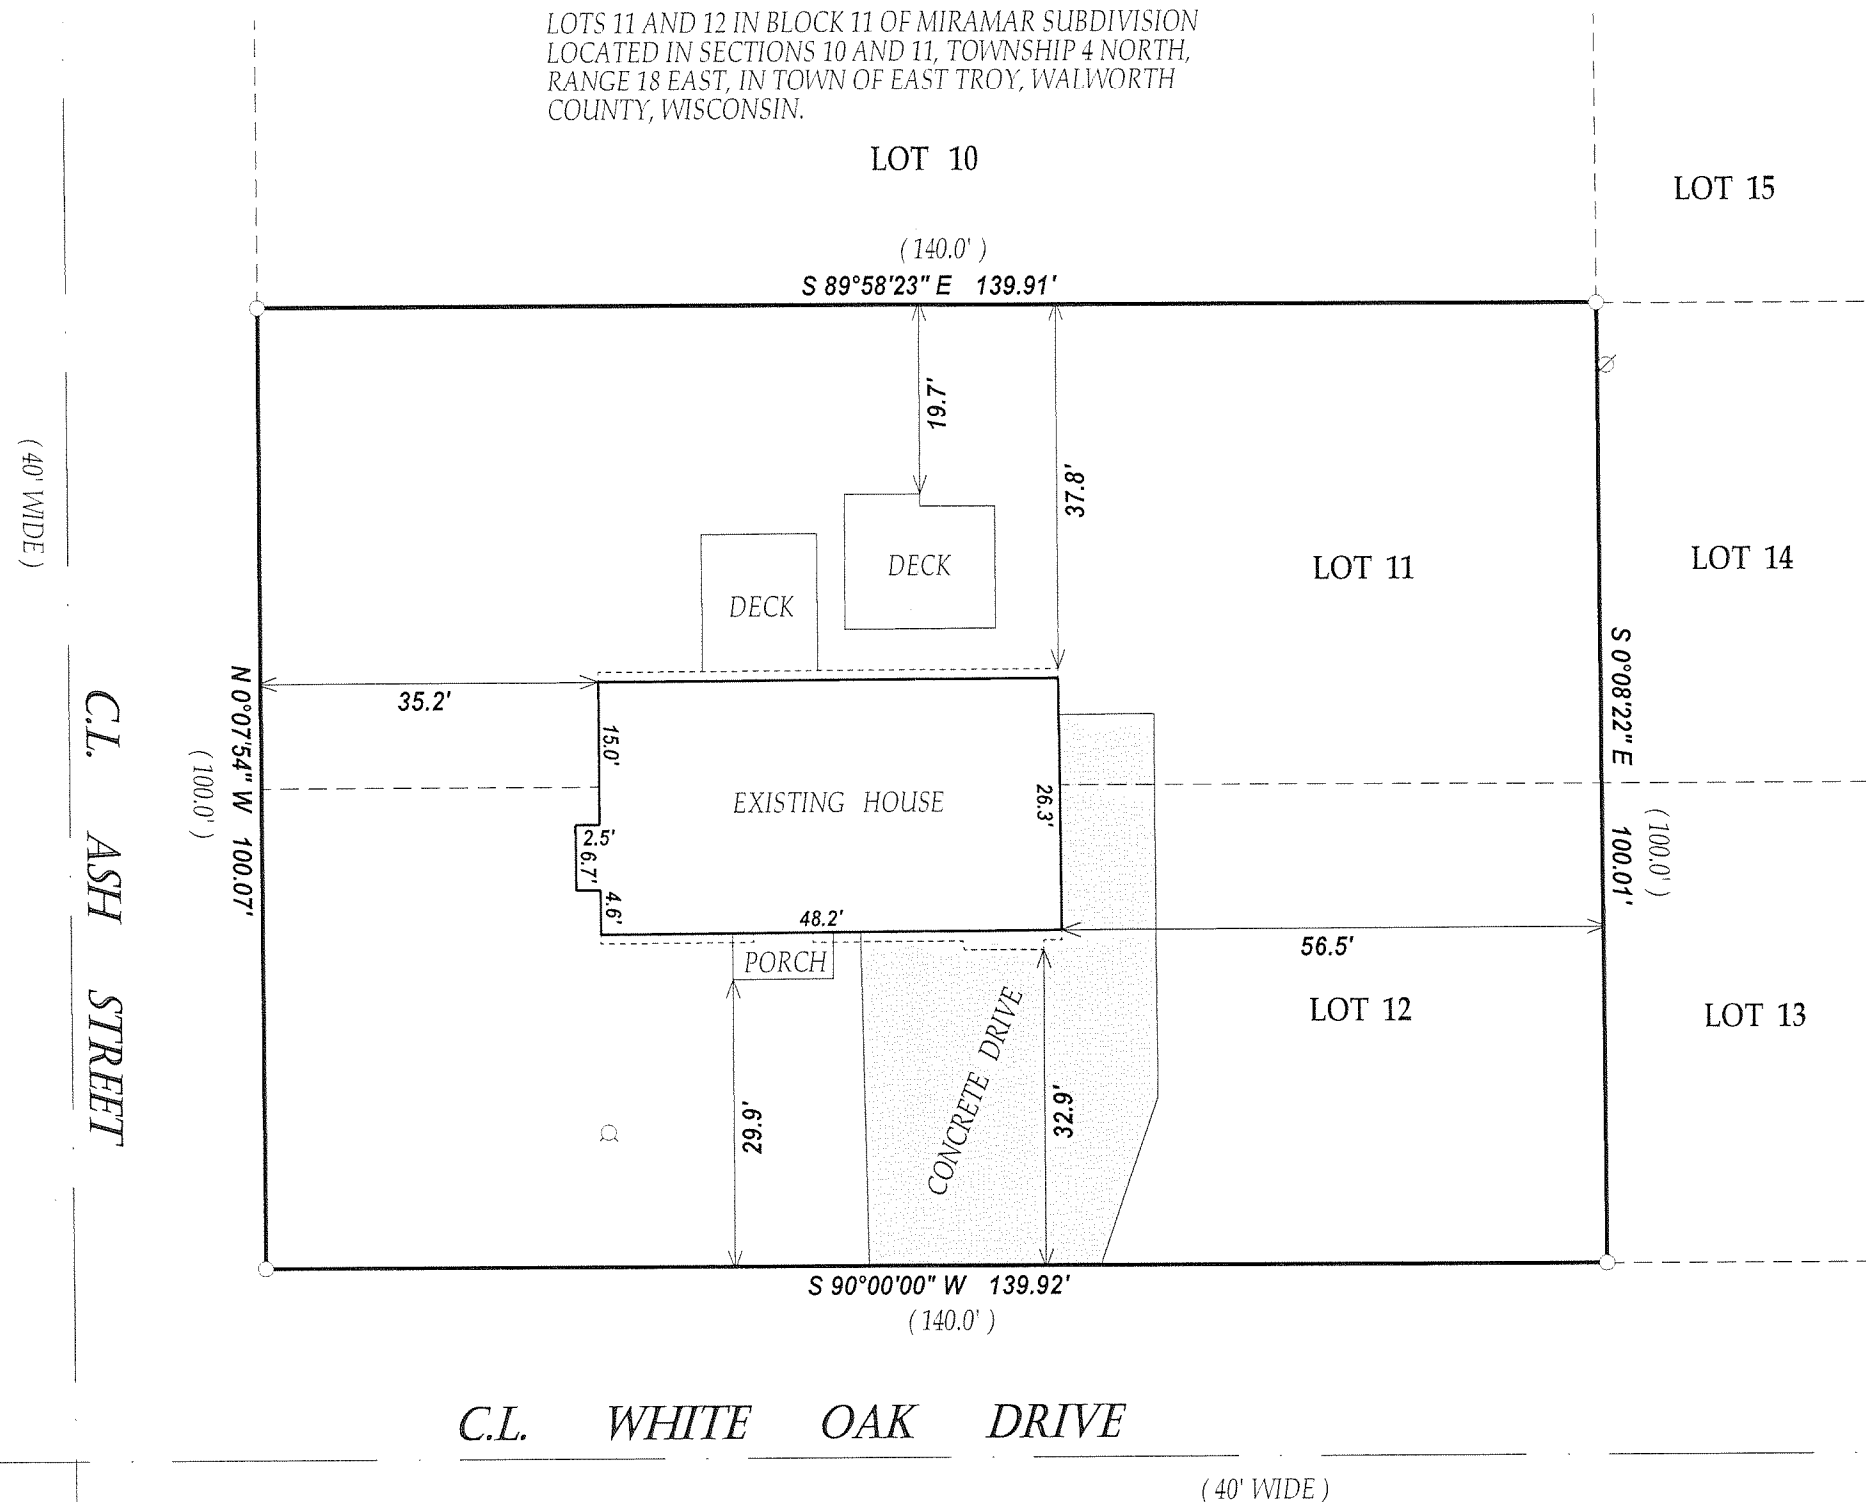

DEC - 1 2008

SMF

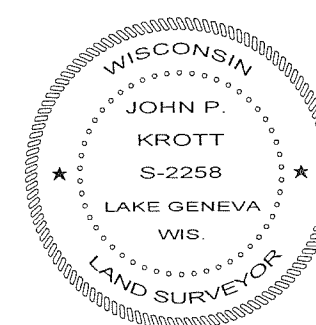

418-2136