

PLAT OF SURVEY
-OF-
-OF BARN AND SHED LOCATION AS SHOWN-
-FOR-



LOT 1 OF CERTIFIED SURVEY MAP NO. 500, AS RECORDED IN THE OFFICE OF THE REGISTER OF DEEDS IN AND FOR WALWORTH COUNTY, WISCONSIN, IN VOLUME 2 OF CERTIFIED SURVEY MAPS ON PAGE 330. SAID LAND BEING A PART OF THE NORTHEAST 1/4 OF THE SOUTHWEST 1/4 OF SECTION 31, TOWN 4 NORTH, RANGE 18 EAST, TOWN OF EAST TROY, WALWORTH COUNTY, WISCONSIN.

SURVEY FOR: RICHARD YOUNG

SURVEY ADDRESS: W2370 SWOBODA RD.




SWABODA (66' WIDE) **ROAD**

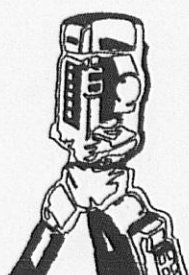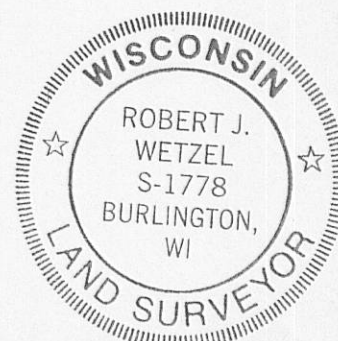

B.W. SURVEYING, INC.

LAND SURVEYS
 MAPPING AND PLANNING
 412 N. PINE STREET
 BURLINGTON, WI 53105
 (262)-767-0225

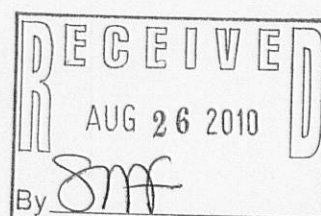

THIS IS NOT AN ORIGINAL PRINT
 UNLESS THIS SEAL IS RED.

Robert J. Wetzel
 ROBERT J. WETZEL S-1778

1/18/10
 DATE

8129
 JOB NUMBER