
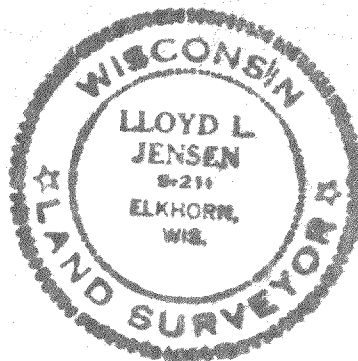


PLAT OF SURVEY

OF
PART OF LOT 9 OF ROMADKA PARK
IN
SECTION 5, TOWNSHIP 4 NORTH, RANGE 18 EAST,
WALYORTH COUNTY, WISCONSIN

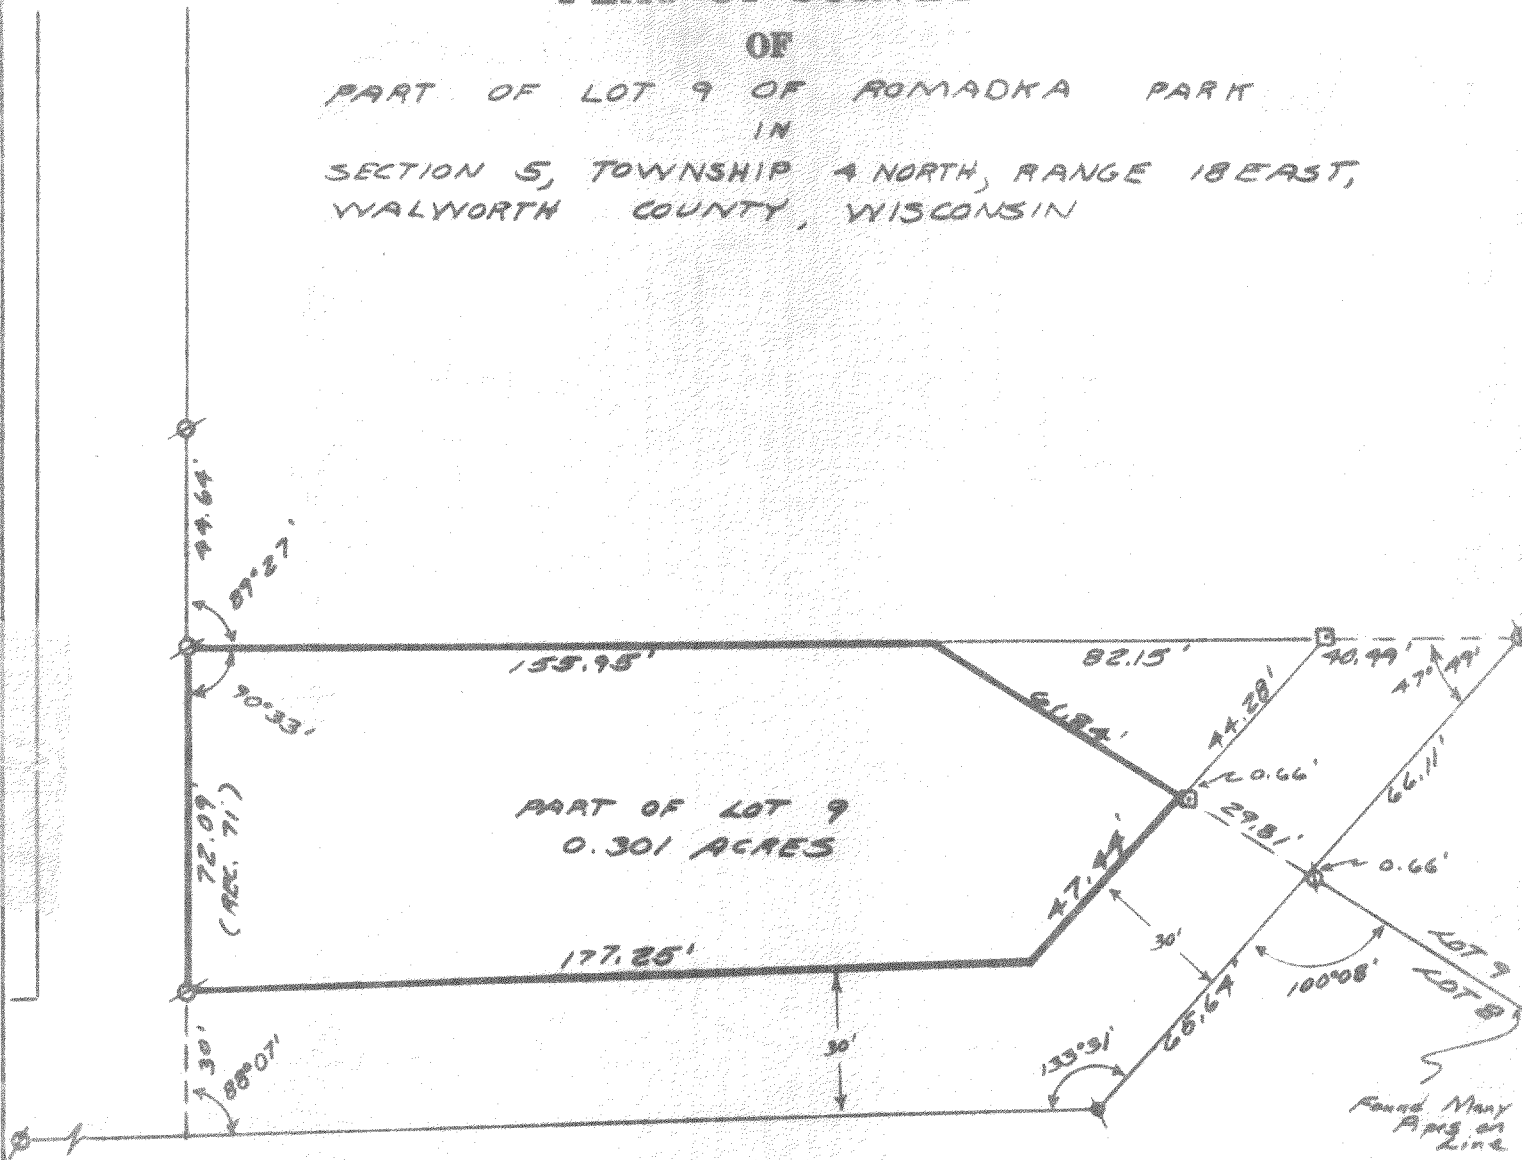

SURVEY AND PLAT BY
JENSEN & JOHNSON, INC.
CIVIL ENGINEERS AND SURVEYORS

Elkhorn, Wisconsin

LEGEND

- ⊗ — Iron Pipe Found
- — Concrete Monument
- Scale 1" = 40'
- — Iron Pipe Set
- — Wood Stake Set
- ⊕ — Iron Rod Found

WE CERTIFY: That we have surveyed the above described property and that the plat shown hereon is an accurate survey and a true representation thereof and correctly shows the exterior boundary lines and all divisions of said property.

Date 24 APRIL 1973

Lloyd L. Jensen
LLOYD L. JENSEN,

Wisconsin Registered Land Surveyor, No. S-211