


RONALD H. ZIMMERMAN
REGISTERED LAND SURVEYOR

PLAT OF SURVEY

FOR

WAUKESHA SAVINGS & LOAN

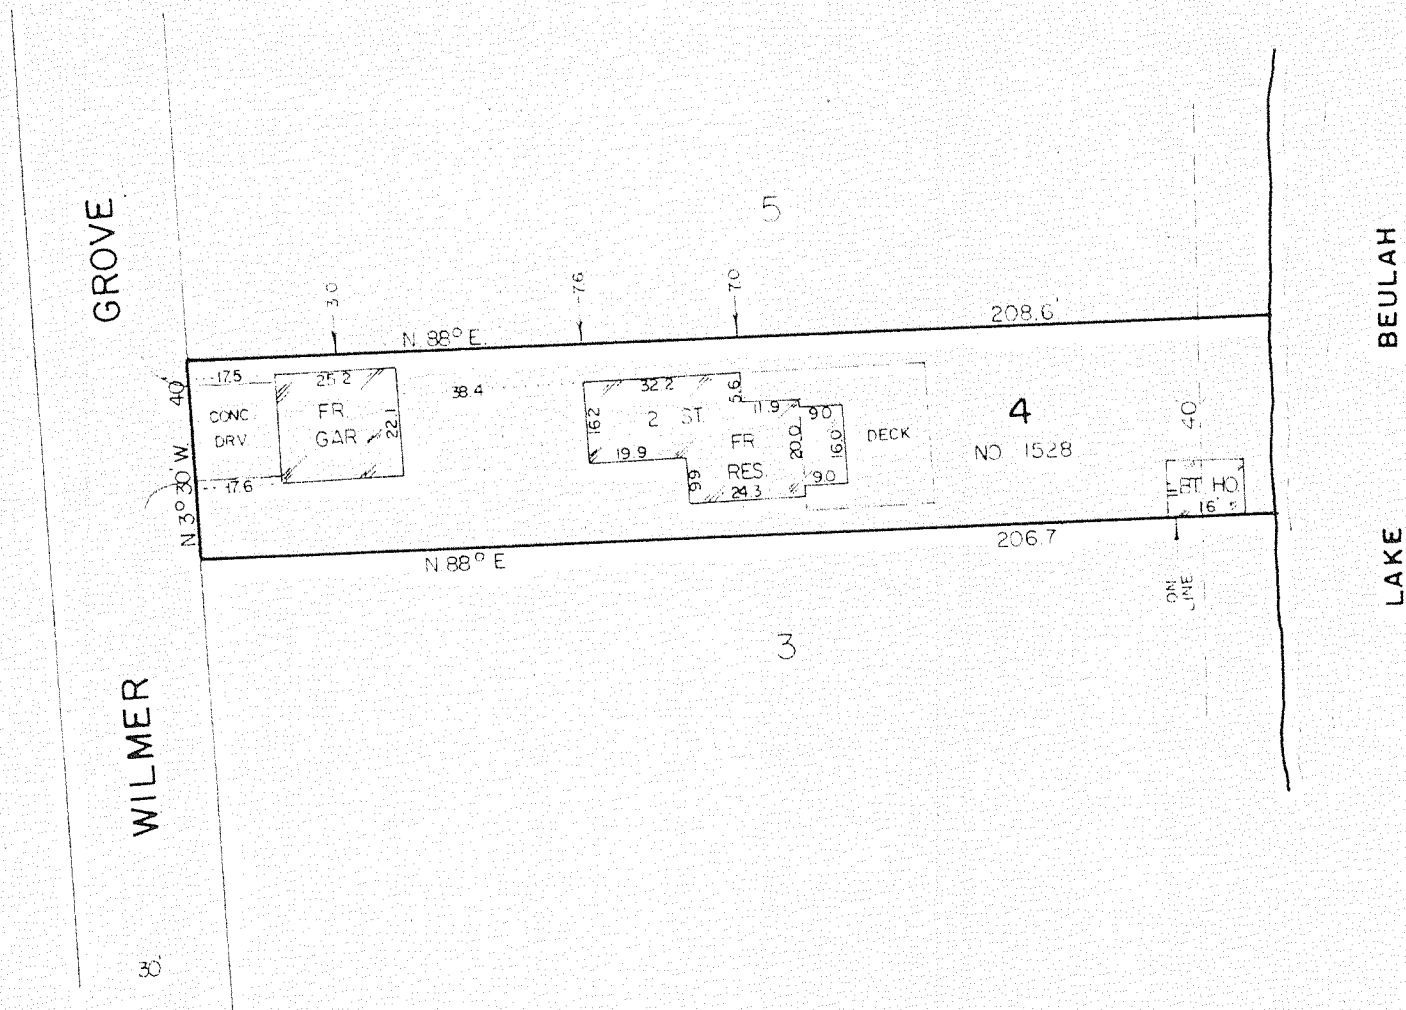

CERTIFICATION


STATE OF WISCONSIN)
COUNTY OF WAUKESHA) SS

I, RONALD H. ZIMMERMAN, REGISTERED LAND SURVEYOR, DO HEREBY CERTIFY THAT I HAVE MADE A SURVEY OF LOT 4, BLK. 1, WILMER GROVE BEACH, TOWN OF EAST TROY, AND THE EXISTING BUILDING AND IMPROVEMENTS LOCATED THEREON AND THAT THE PLAT HERewith DRAWN IS A CORRECT REPRESENTATION OF SAID SURVEY.

DATE APRIL 5, 1974

RONALD H. ZIMMERMAN

S - 868

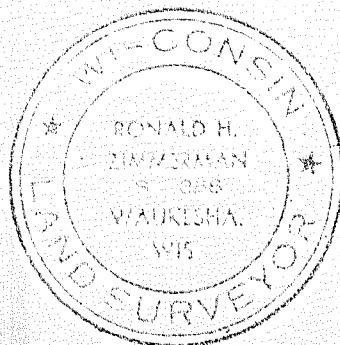

P.W.W.-4

418-295