



ROAD
TOWNLINE

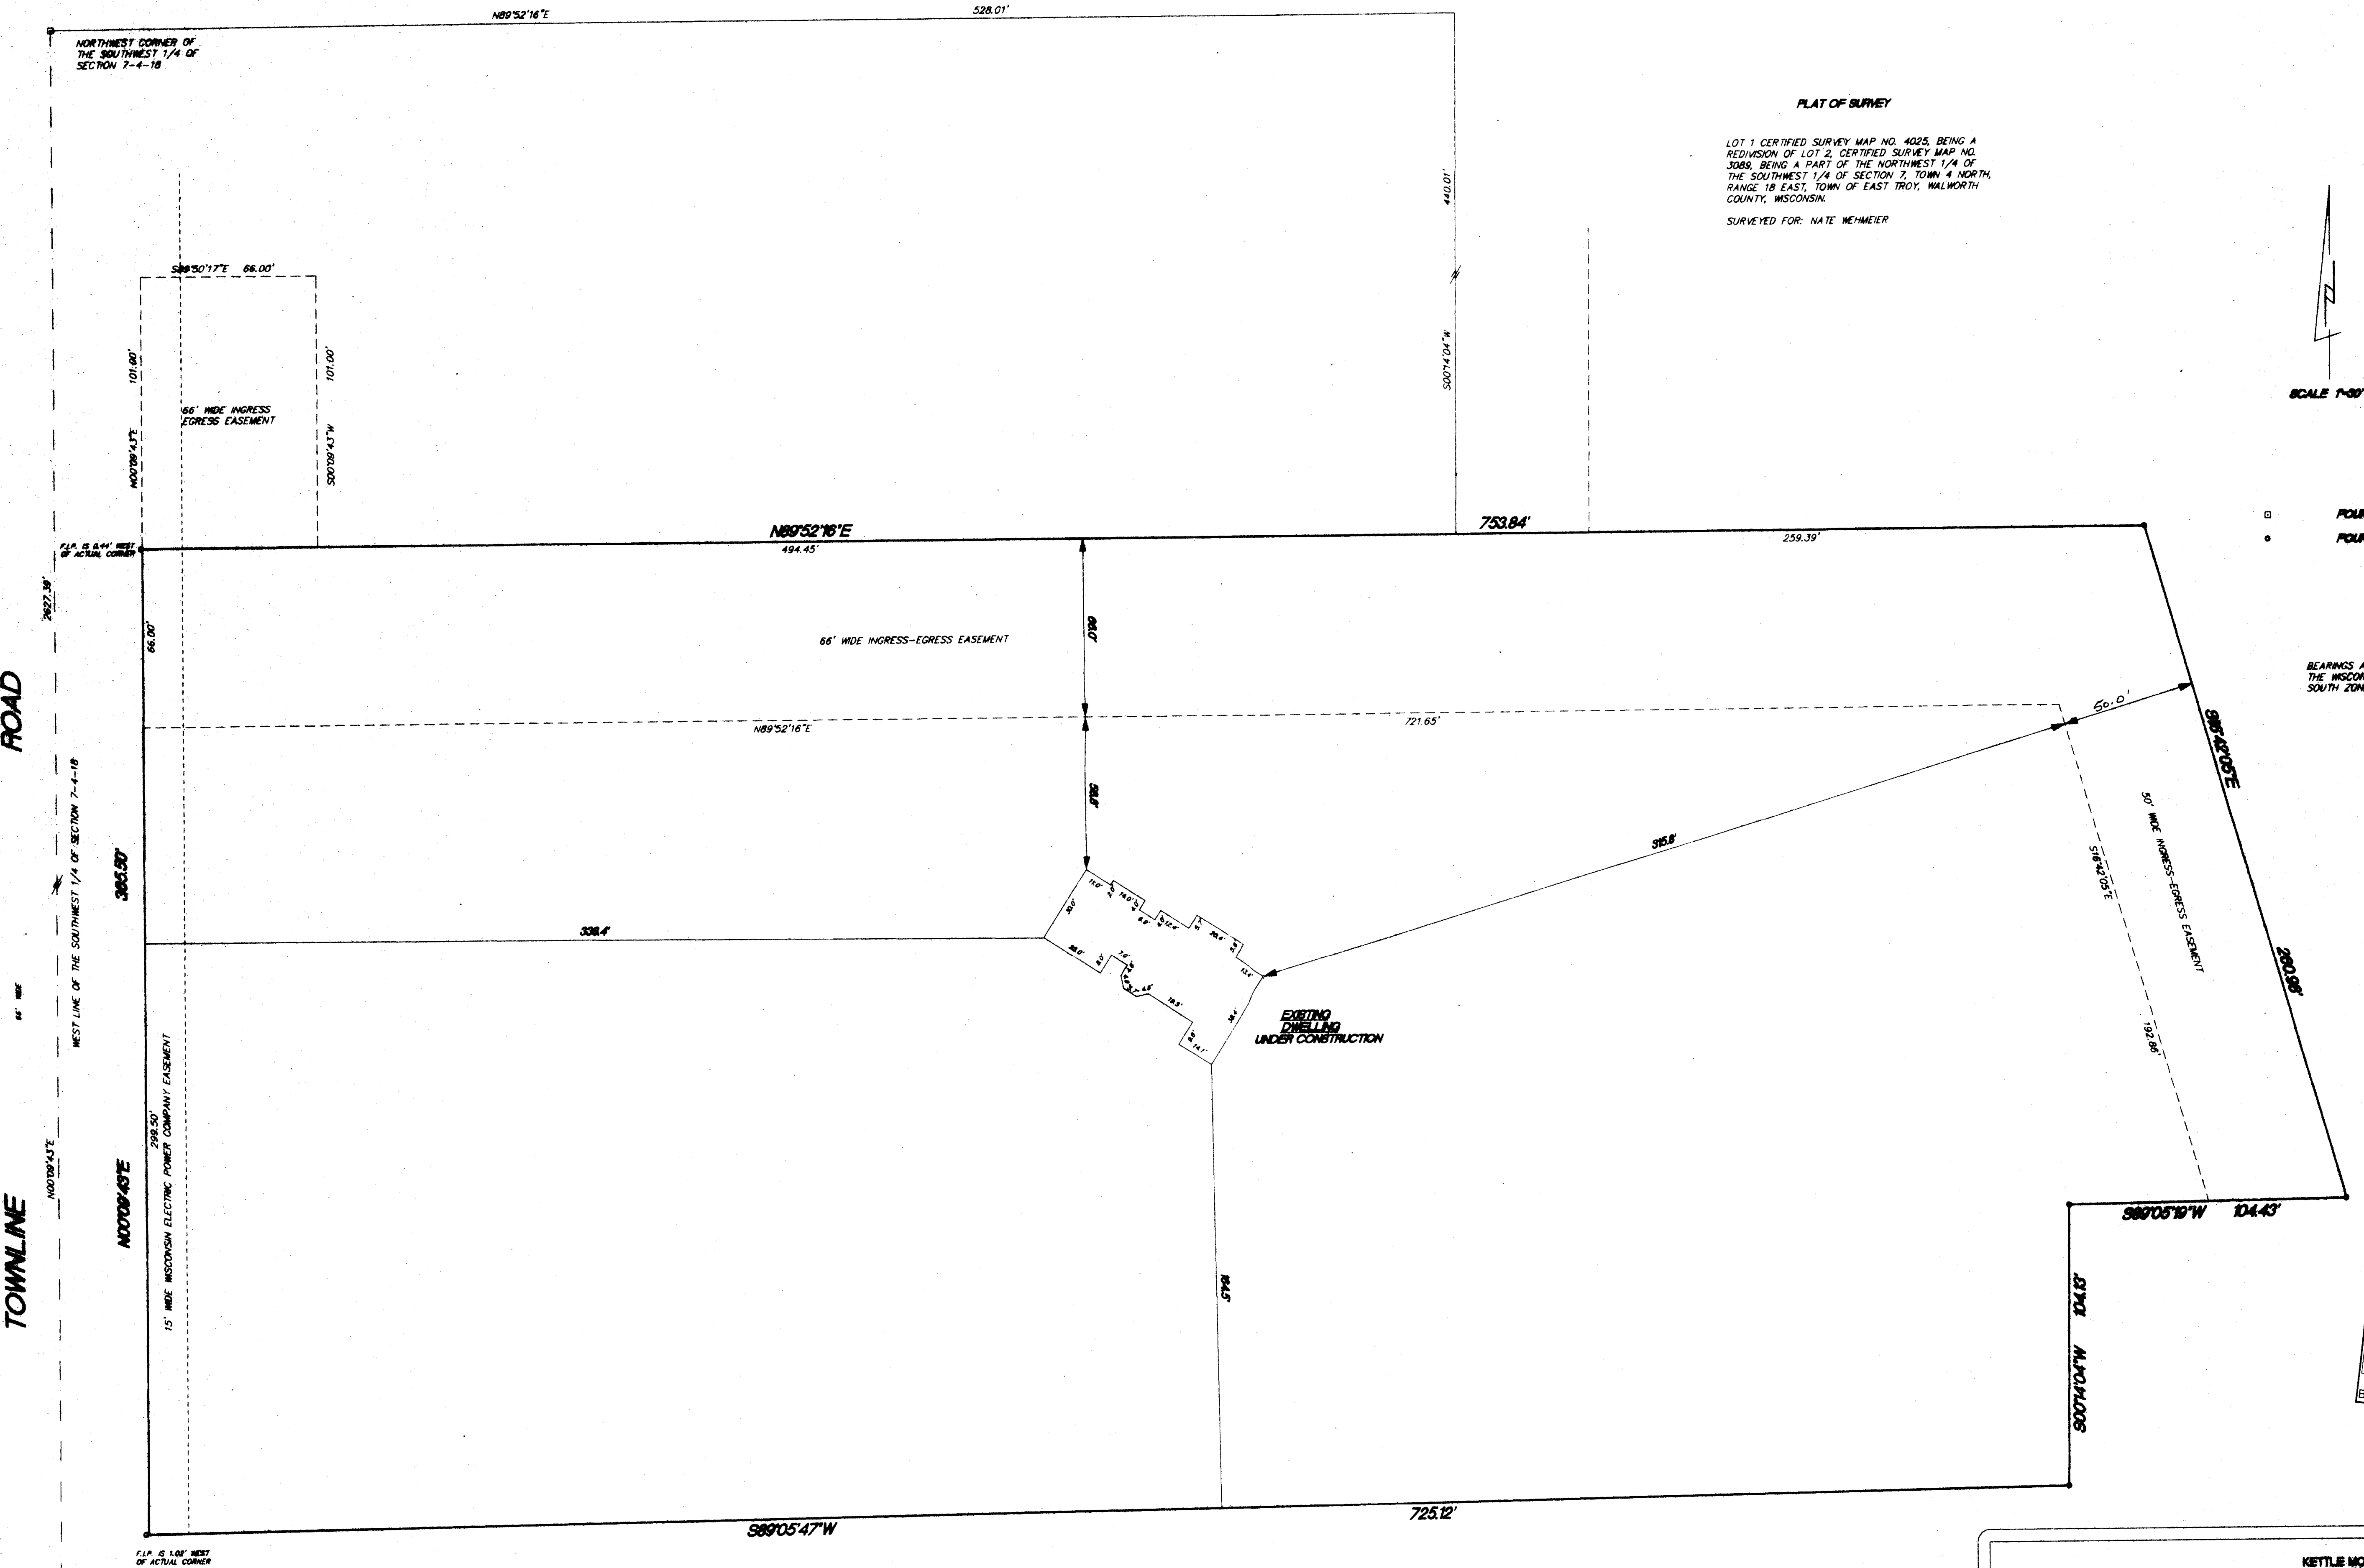

PLAT OF SURVEY
LOT 1 CERTIFIED SURVEY MAP NO. 4025, BEING A
REDIVISION OF LOT 2, CERTIFIED SURVEY MAP NO.
3089, BEING A PART OF THE NORTHWEST 1/4 OF
THE SOUTHWEST 1/4 OF SECTION 7, TOWN 4 NORTH,
RANGE 18 EAST, TOWN OF EAST TROY, WALWORTH
COUNTY, WISCONSIN.
SURVEYED FOR: NATE MEHMEIER

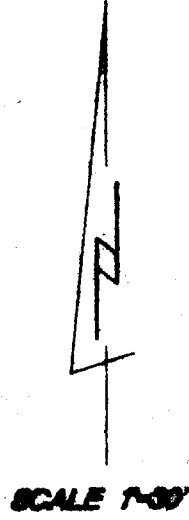

FOUND 6" CONC. MEN. REBAR CAP
FOUND 1" IRON PIPE

BEARINGS ARE REFERENCED TO GRID NORTH OF
THE WISCONSIN STATE PLANE COORDINATE SYSTEM
SOUTH ZONE. (NAD 1983)

RECEIVED
FEB 1 2012
By: [Signature]

TERENCE F. DISABEK
S-1930
EAGLE, WISCONSIN
LAND SURVEYOR

KETTLE MORaine SURVEYING INC.
P.O. BOX 867
Eagle WI 53009
(262) 894-3404

I hereby certify that I have surveyed the above property and that the above map is a true representation thereof and shows the size and location of the property, exterior boundaries, the location of all visible structures and dimensions of all principal buildings thereon, boundary lines, adjacent easements, roadways and encroachments if any.

This survey is made for the use of the present owners of the property, and who those who purchase, mortgage or guarantee the title thereto shall use from date hereof.

THIS IS NOT AN ORIGINAL SURVEY UNLESS THE SEAL IS RED.

REV. 1/8/12
DATE: 4/3/08
FELD WORK BY: [Signature]
DRAWN BY: [Signature]
JOB NUMBER: 00017

PA4035-1

418-2766