
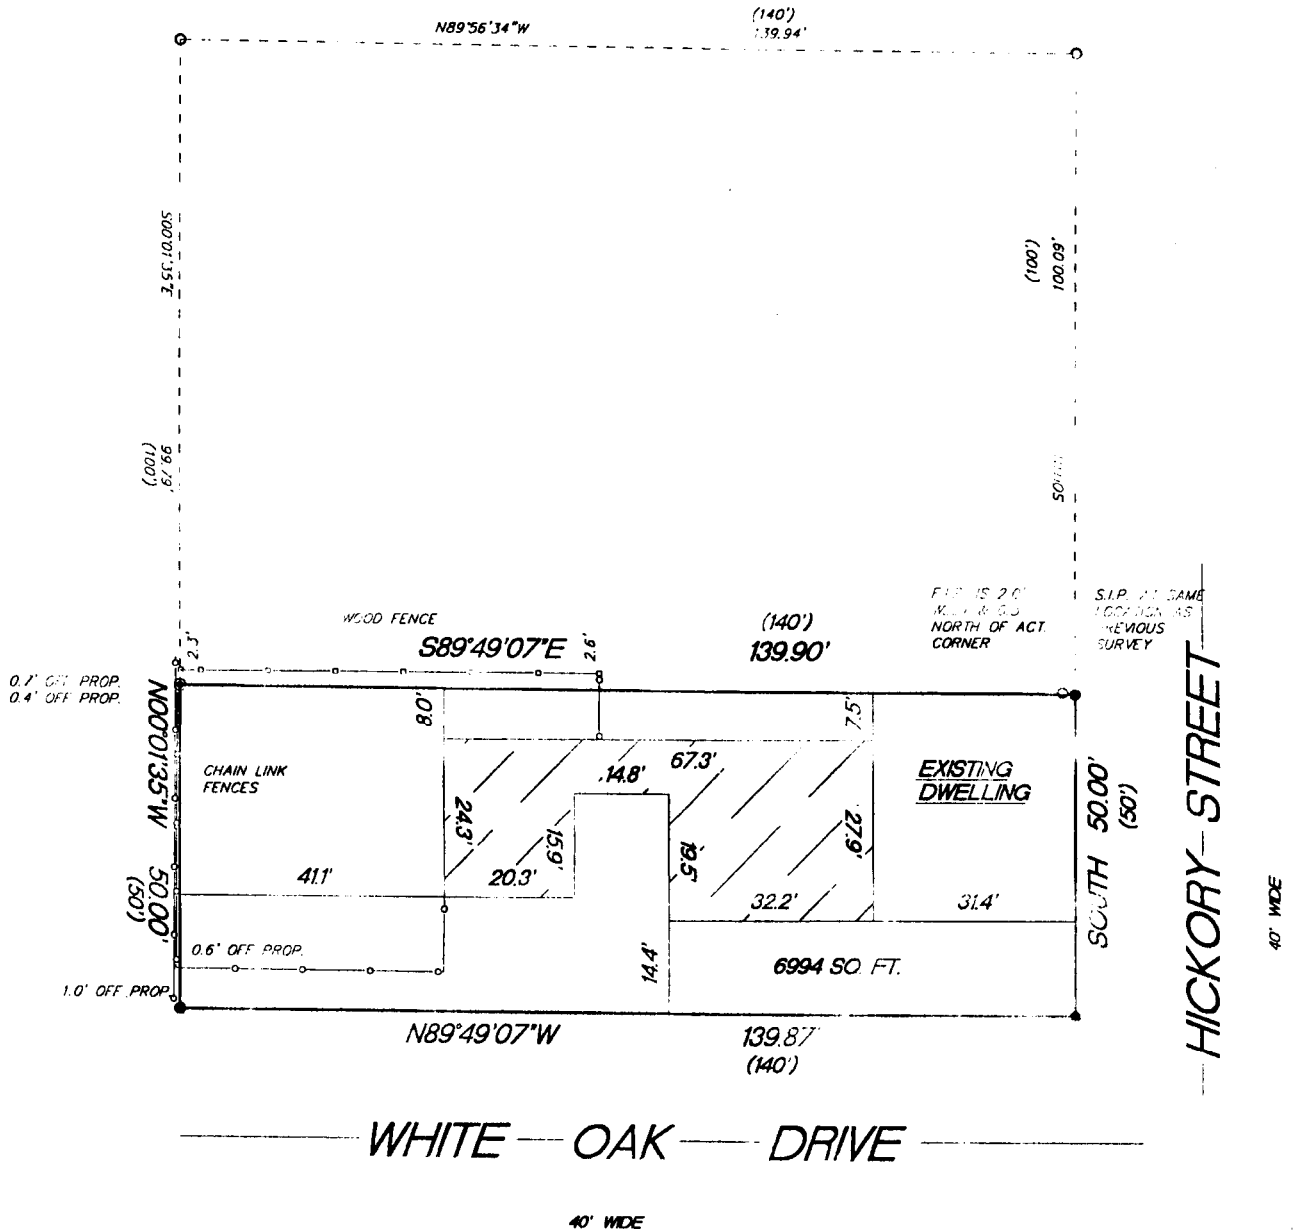


PLAT OF SURVEY

LOT 13 IN BLOCK 12 IN MIRAMAR SUBDIVISION, being a part of the East 1/2 of Section 10 and the West 1/2 of Section 11, Town 4 North, Range 18 East, Town of East Troy, Walworth County, Wisconsin.

Surveyed for: Thanksgiving Properties

Survey address: W946 White Oak Drive

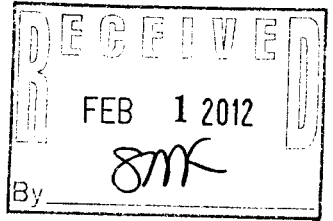

- FOUND 1" IRON PIPE-F.I.P.
- FOUND 1 1/2" IRON PIPE
- SET 1" IRON PIPE-S.I.P.
- () RECORDED AS DIMENSIONS


BEARINGS ARE REFERENCED TO THE WEST LINE OF HICKORY STREET AND IS ASSUMED TO BEAR SOUTH.

SCALE 1"=30'

"I hereby certify that I have surveyed the above described property and that the above map is a true representation thereof and shows the size and location of the property, its exterior boundaries, the location of all visible structures and dimension of all principal buildings thereon, boundary fences, apparent easements, roadways and encroachments if any."

"This survey is made for the use of the present owners of the property, and also those who purchase, mortgage or guarantee the title thereto within one year from date hereof."

KETTLE MORaine SURVEYING INC.
S75 W36245 Wilton Road
Eagle Wisconsin 53119
P.O. Box 357
(262) 594-3484
Terrance E. Pisarek R.L.S.

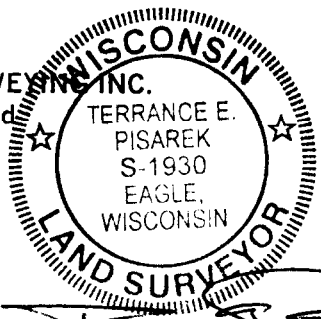

THIS IS NOT AN ORIGINAL SURVEY UNLESS THE SEAL IS RED.

1/11/12	TEP	TEP	12003
DATE	FIELD WORK BY	DRAWN BY	JOB NUMBER

PMR-133A

418-2268