
LAND-MARK SURVEYING Mark L. Miritz

Wisconsin Registered Land Surveyor S-2582

N9330 Knuteson Drive Whitewater, WI 53190 Phone:(262)495-3284 FAX: (262) 495-8421 LAND-MARKSURVEYING.COM


PLAT OF SURVEY

LOT 1 OF CERTIFIED SURVEY MAP NO. 30, LOCATED IN THE EAST 1/2 OF SECTION 9, **TOWN 4 NORTH, RANGE 18 EAST, EAST TROY** TOWNSHIP, WALWORTH COUNTY, WISCONSIN.

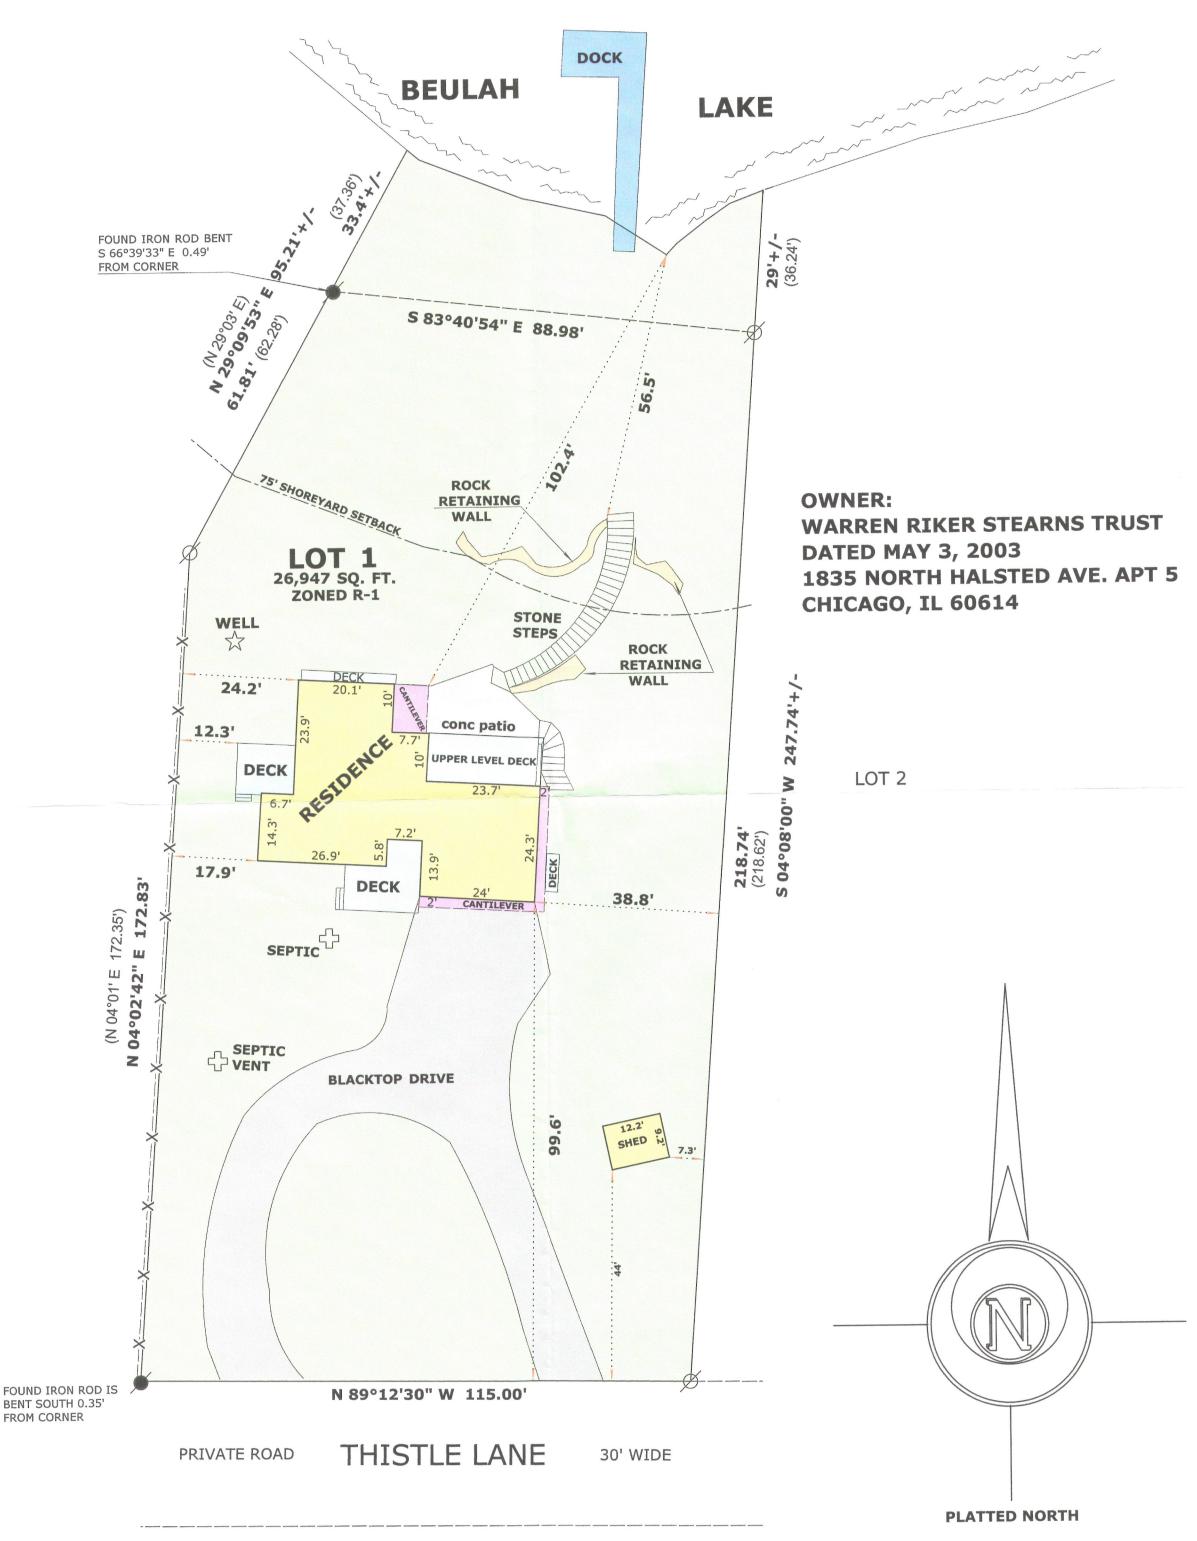



LEGEND

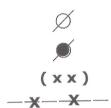

FOUND IRON PIPE FOUND IRON ROD RECORDED AS DIMENSION **EXISTING FENCE**

REVISED NOV. 30, 2012 TO SHOW DECKS AS BUILT

MIRITZ

SCALE: 1 INCH = 20 FEET

"I hereby certify that the above described property has been surveyed by me or under my direction and that the above map is a true representation thereof and shows the size and location of the property, its exterior boundaries, the location of all visible structures and dimensions of all principal buildings thereon, boundary fences, apparent easements, roadways and visible encroachments, if any." "This survey is made for the use of the present owners of the property, and also those who purchase, mortgage, or

guarantee the title thereto within one year from date

MARK L. MIRITZ **WISCONSIN REGISTERED LAND SURVEYOR S-2582**

DATE: AUGUST 8, 2007 JOB NO. 07.803

418-2321