
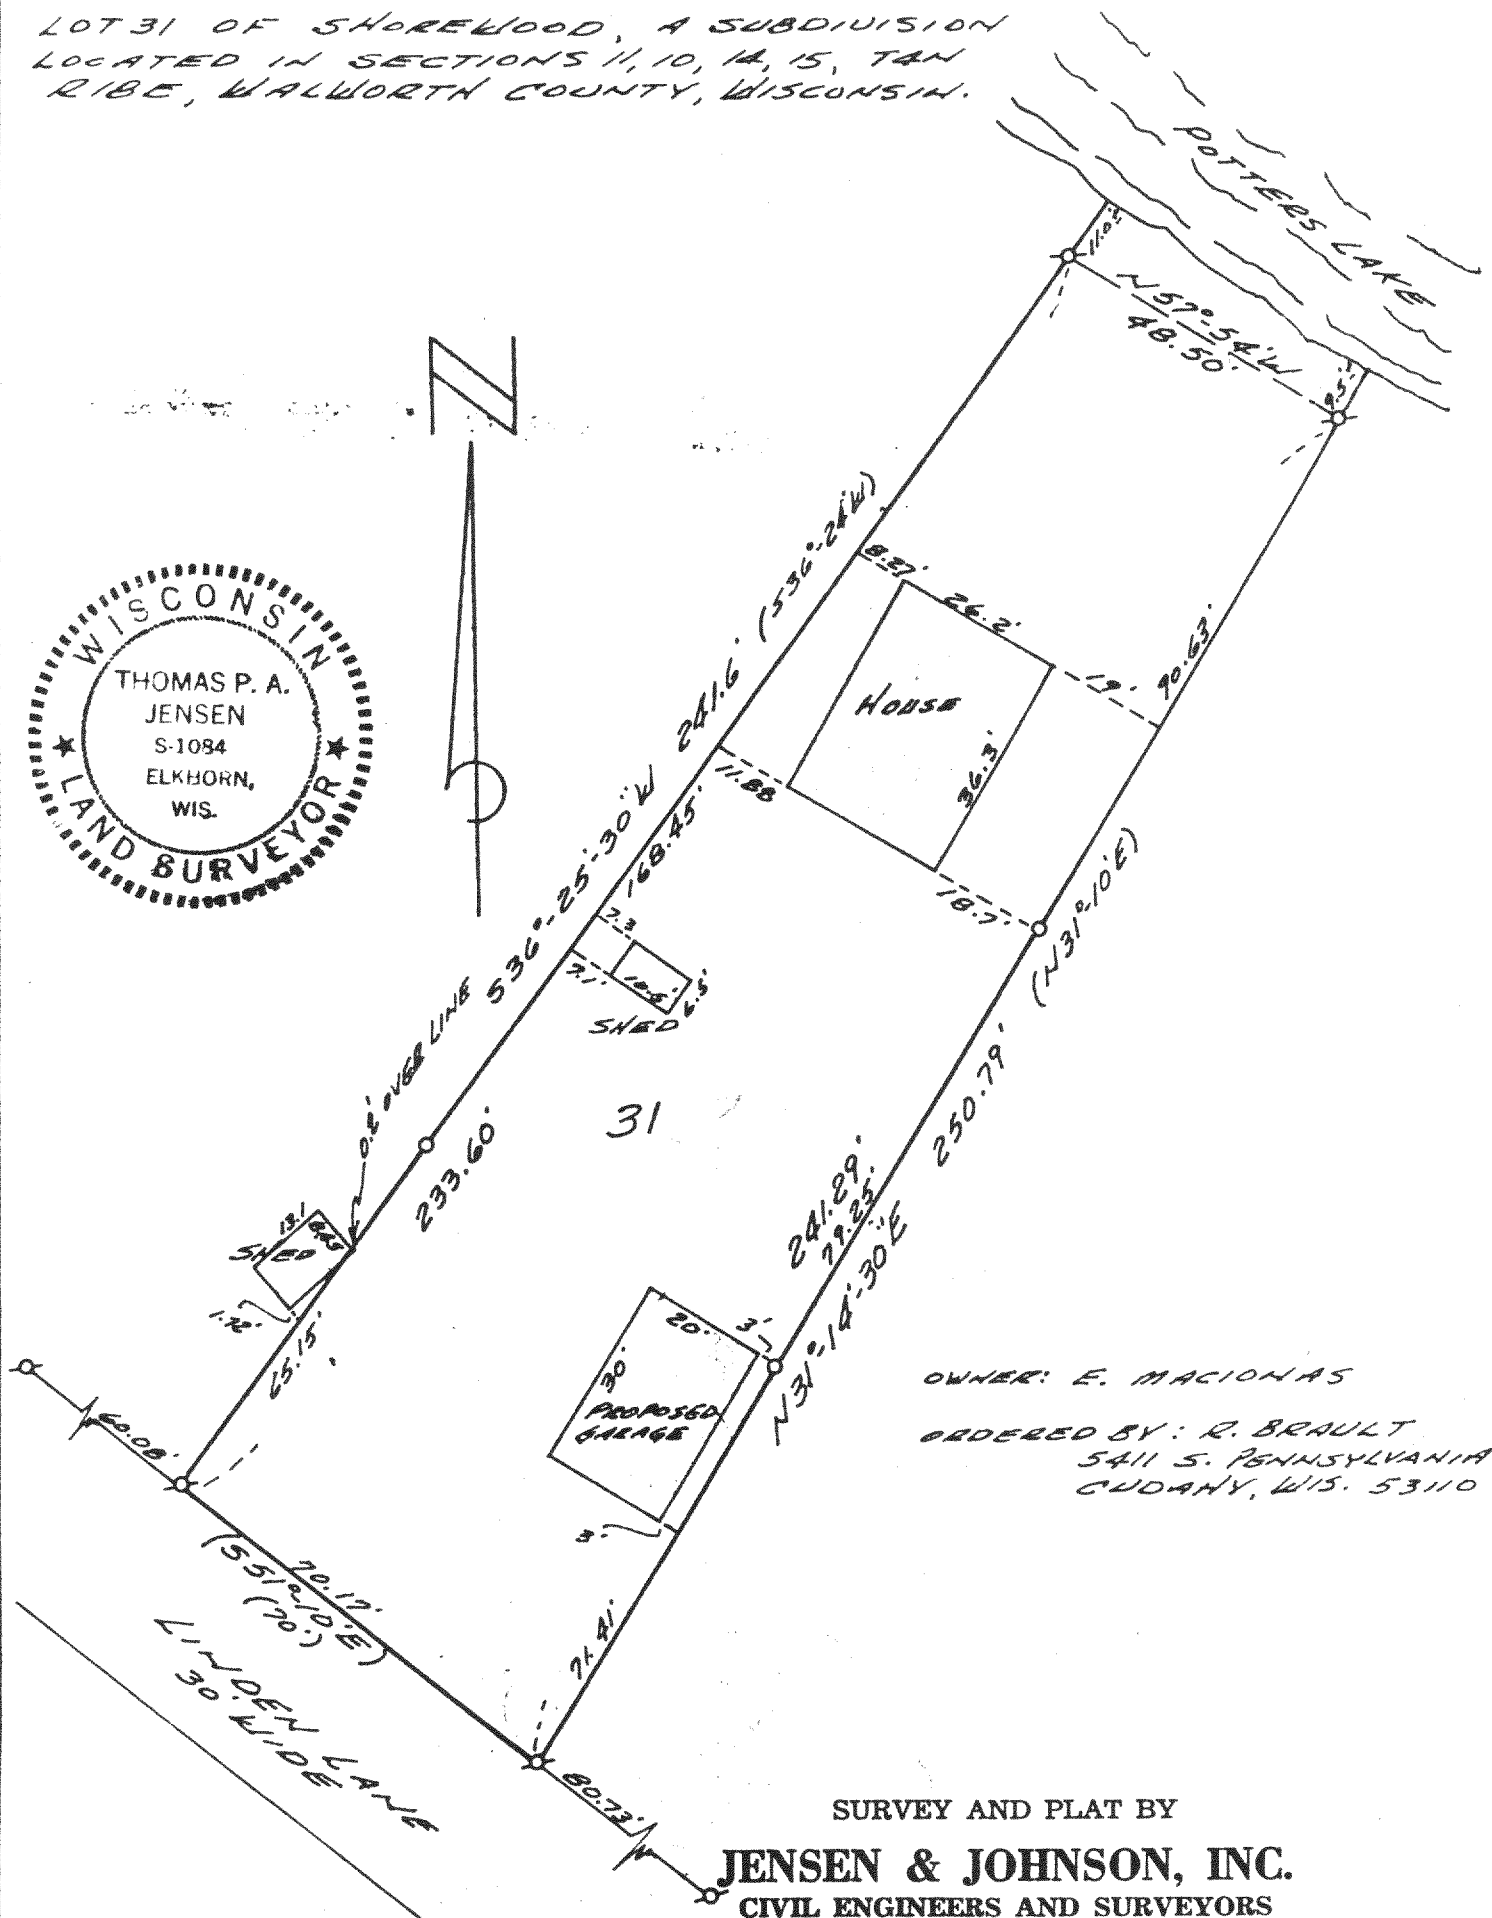


PLAT OF SURVEY

OF

LOT 31 OF SHOREWOOD, A SUBDIVISION
LOCATED IN SECTIONS 11, 10, 14, 15, T4N
R16E, WALWORTH COUNTY, WISCONSIN.

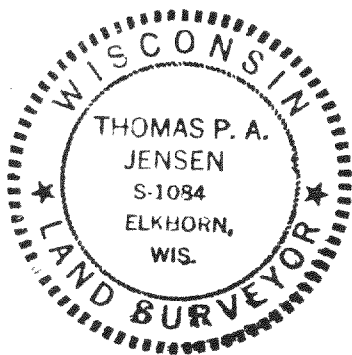

OWNER: E. MACIONAS

ORDERED BY: R. BRAULT
5411 S. PENNSYLVANIA
CUDAHY, WIS. 53110

SURVEY AND PLAT BY

JENSEN & JOHNSON, INC.
CIVIL ENGINEERS AND SURVEYORS

Elkhorn, Wisconsin

LEGEND

- — Iron Pipe SET
- — Concrete Monument

Scale 1" = 30'

Ø — IRON PIPE FOUND
() — RECORDED AS

WE CERTIFY: That we have surveyed the above described property and that the plat shown hereon is an accurate survey and a true representation thereof and correctly shows the exterior boundary lines and all divisions of said property.



Date AUG 5, 1974

Thomas P. A. Jensen

Wisconsin Registered Land Surveyor, No. S-1084

PLAT OF SURVEY
OF

LOT 31 OF SHOREWOOD, A SUBDIVISION
LOCATED IN SECTIONS 11, 10, 14, 15, T4N
R18E, WALWORTH COUNTY, WISCONSIN.

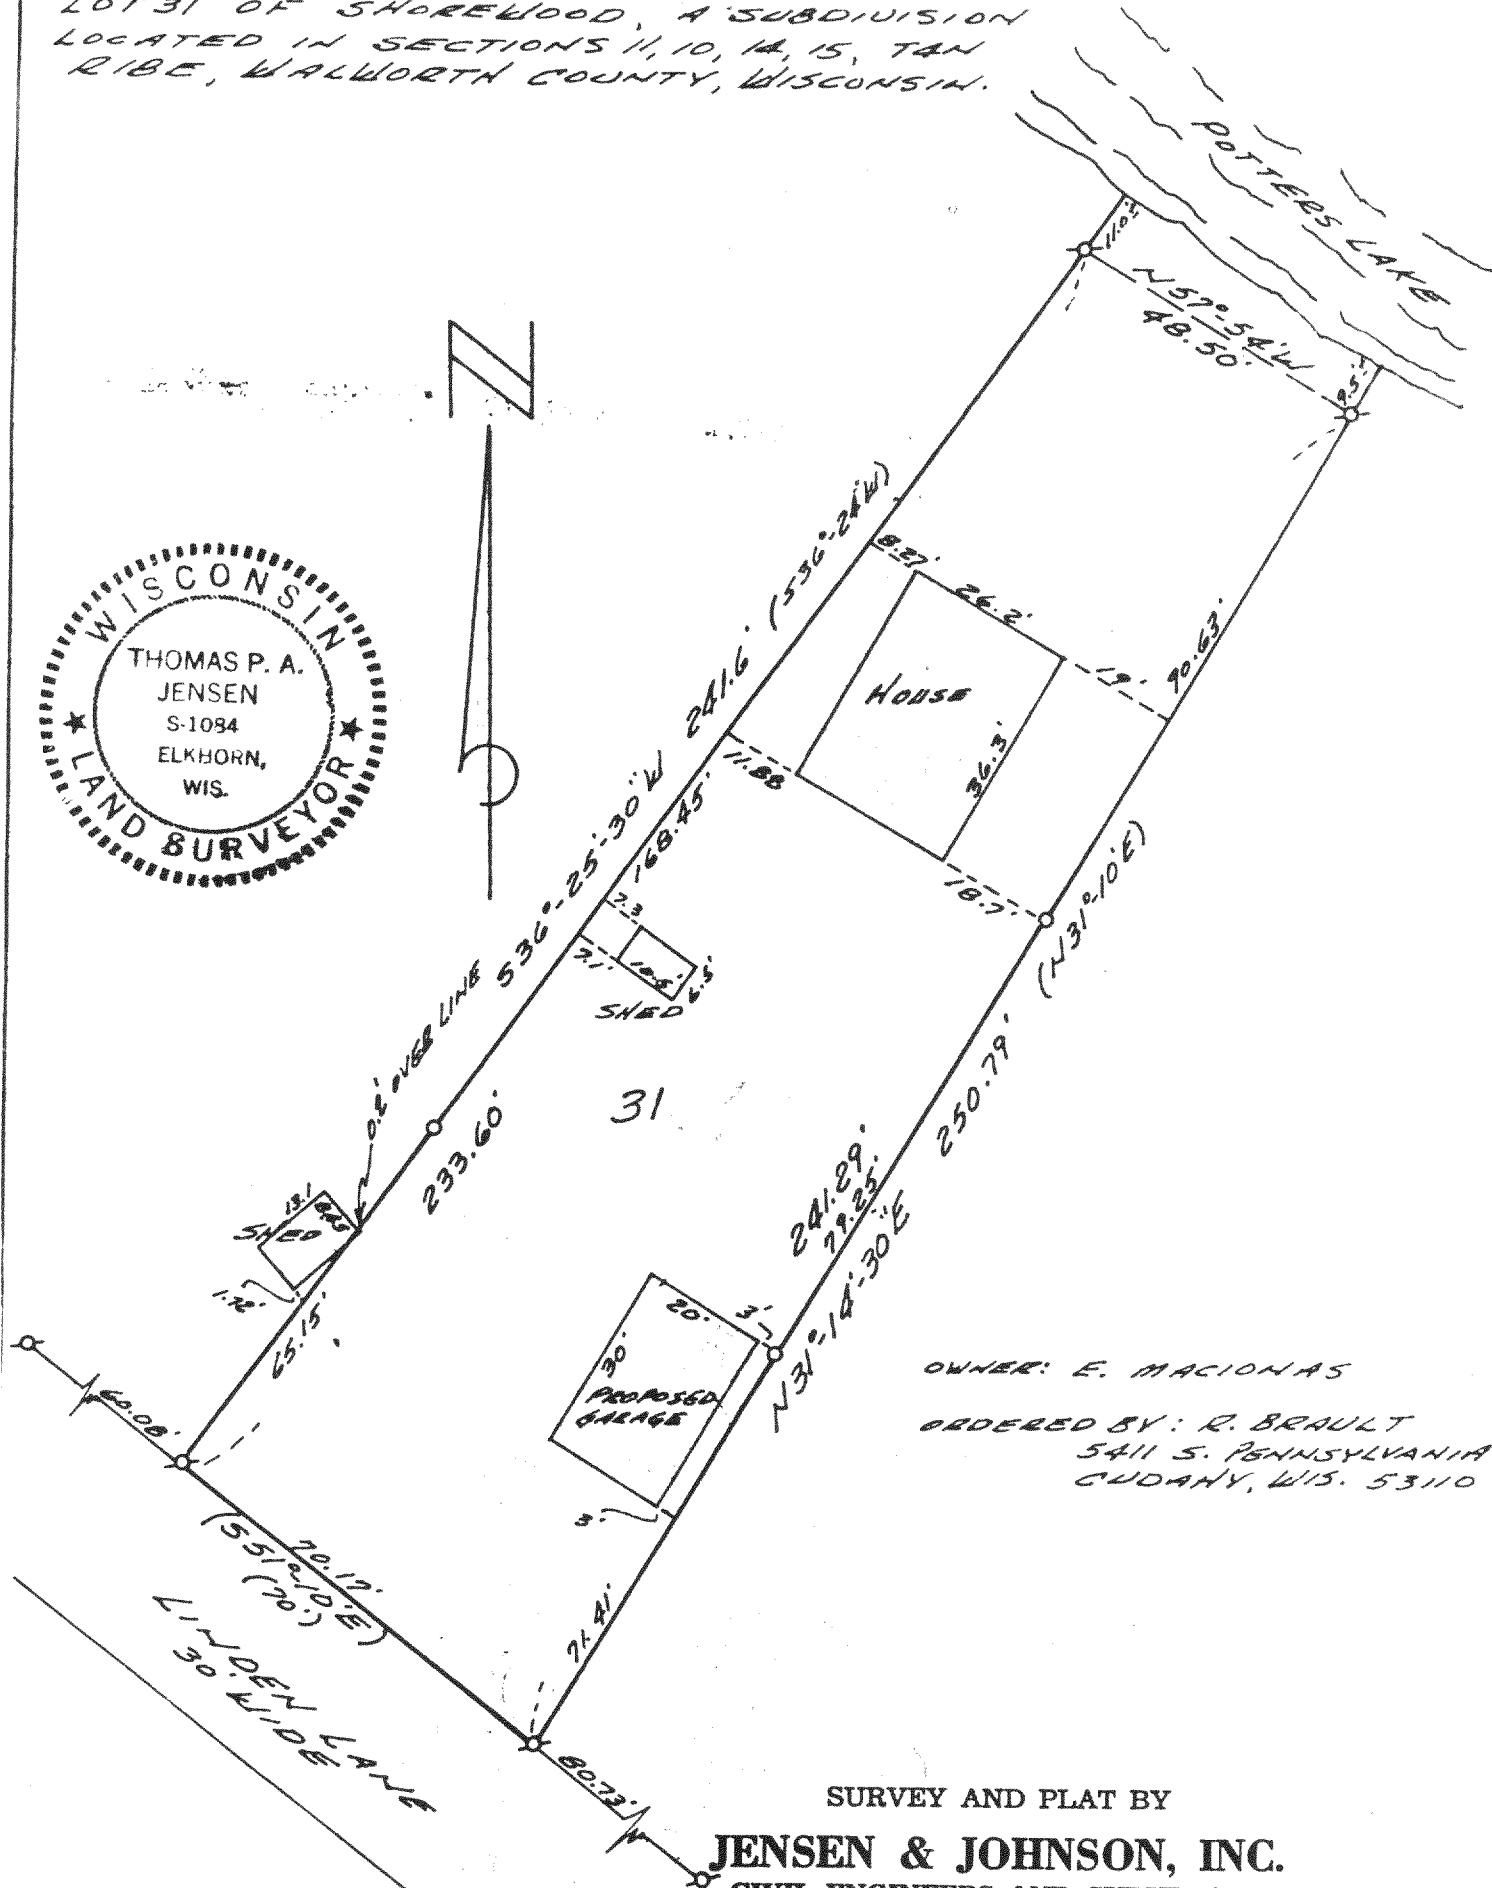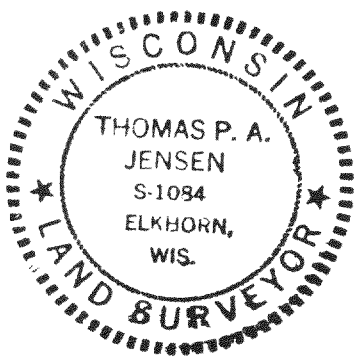

SURVEY AND PLAT BY

JENSEN & JOHNSON, INC.
CIVIL ENGINEERS AND SURVEYORS

Elkhorn, Wisconsin

LEGEND

○ — Iron Pine SET