

Plat of Survey

LOT 10, IN SHOREWOOD, being a Subdivision of a part of the Southeast ¼ and the Southwest ¼ of Section 11, and the Northwest ¼ of Section 14, and the Northeast ¼ of Section 15, Town 4 North, Range 18 East, in the Town of East Troy, Walworth County, Wisconsin.


Surveyed for: Ruebl Builders

Survey address: W830 Shorewood dr.

POTTERS

LAKE

LAKE ELEV. 809.5

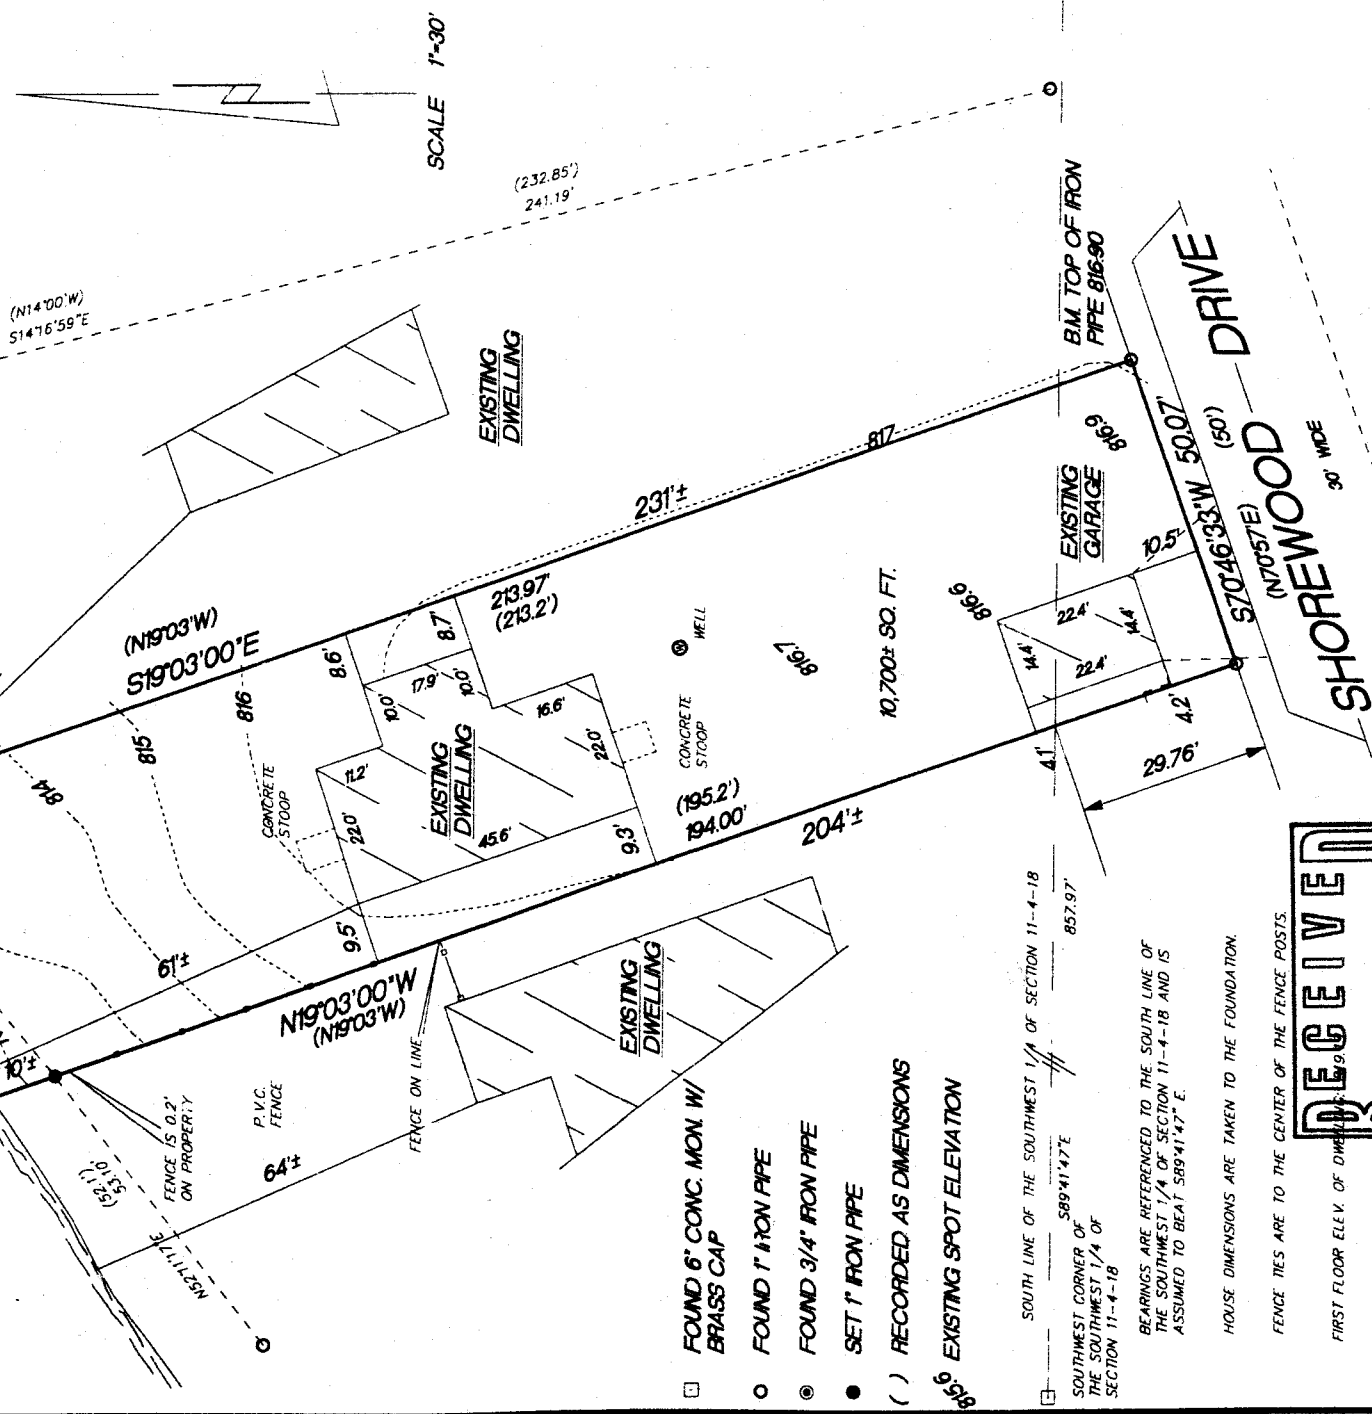

- FOUND 6" CONC. MON W/ BRASS CAP
- FOUND 1" IRON PIPE
- FOUND 3/4" IRON PIPE
- SET 1" IRON PIPE
- () RECORDED AS DIMENSIONS
- ± EXISTING SPOT ELEVATION

SOUTH LINE OF THE SOUTHWEST 1/4 OF SECTION 11-4-18
S89°41'47"E 857.97'
SOUTHWEST CORNER OF THE SOUTHWEST 1/4 OF SECTION 11-4-18
BEARINGS ARE REFERENCED TO THE SOUTH LINE OF THE SOUTHWEST 1/4 OF SECTION 11-4-18 AND IS ASSUMED TO BE AT S89°41'47"E.

HOUSE DIMENSIONS ARE TAKEN TO THE FOUNDATION.

FENCE TIES ARE TO THE CENTER OF THE FENCE POSTS.


FIRST FLOOR ELEV. OF DWELLING

RECEIVED
JAN 14 2014

By *[Signature]*

"I hereby certify that I have surveyed the above described property and that the above map is a true representation thereof and shows the size and location of the property, its exterior boundaries, the location of all visible structures and dimensions of all principal buildings thereon, boundary fences, apparent easements, roadways and encroachments if any"

"This survey is made for the use of the present owners of the property, and also those who purchase, mortgage or guarantee the title thereto within one year from date hereof."

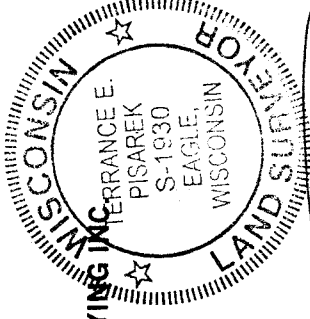

KETTLE MORaine SURVEYING INC.
S75 W36245 Wilton Road
Eagle Wisconsin 53119
P.O. Box 357
(262) 594-3484
kettlemorainesurvey.com
Terrance E. Pisarek R.L.S.

THIS IS NOT AN ORIGINAL SURVEY UNLESS THE SEAL IS RED.

11/5/13

TEP

DATE

FIELD WORK BY

DRAWN BY

JOB NUMBER

P8 -10

418-2392