


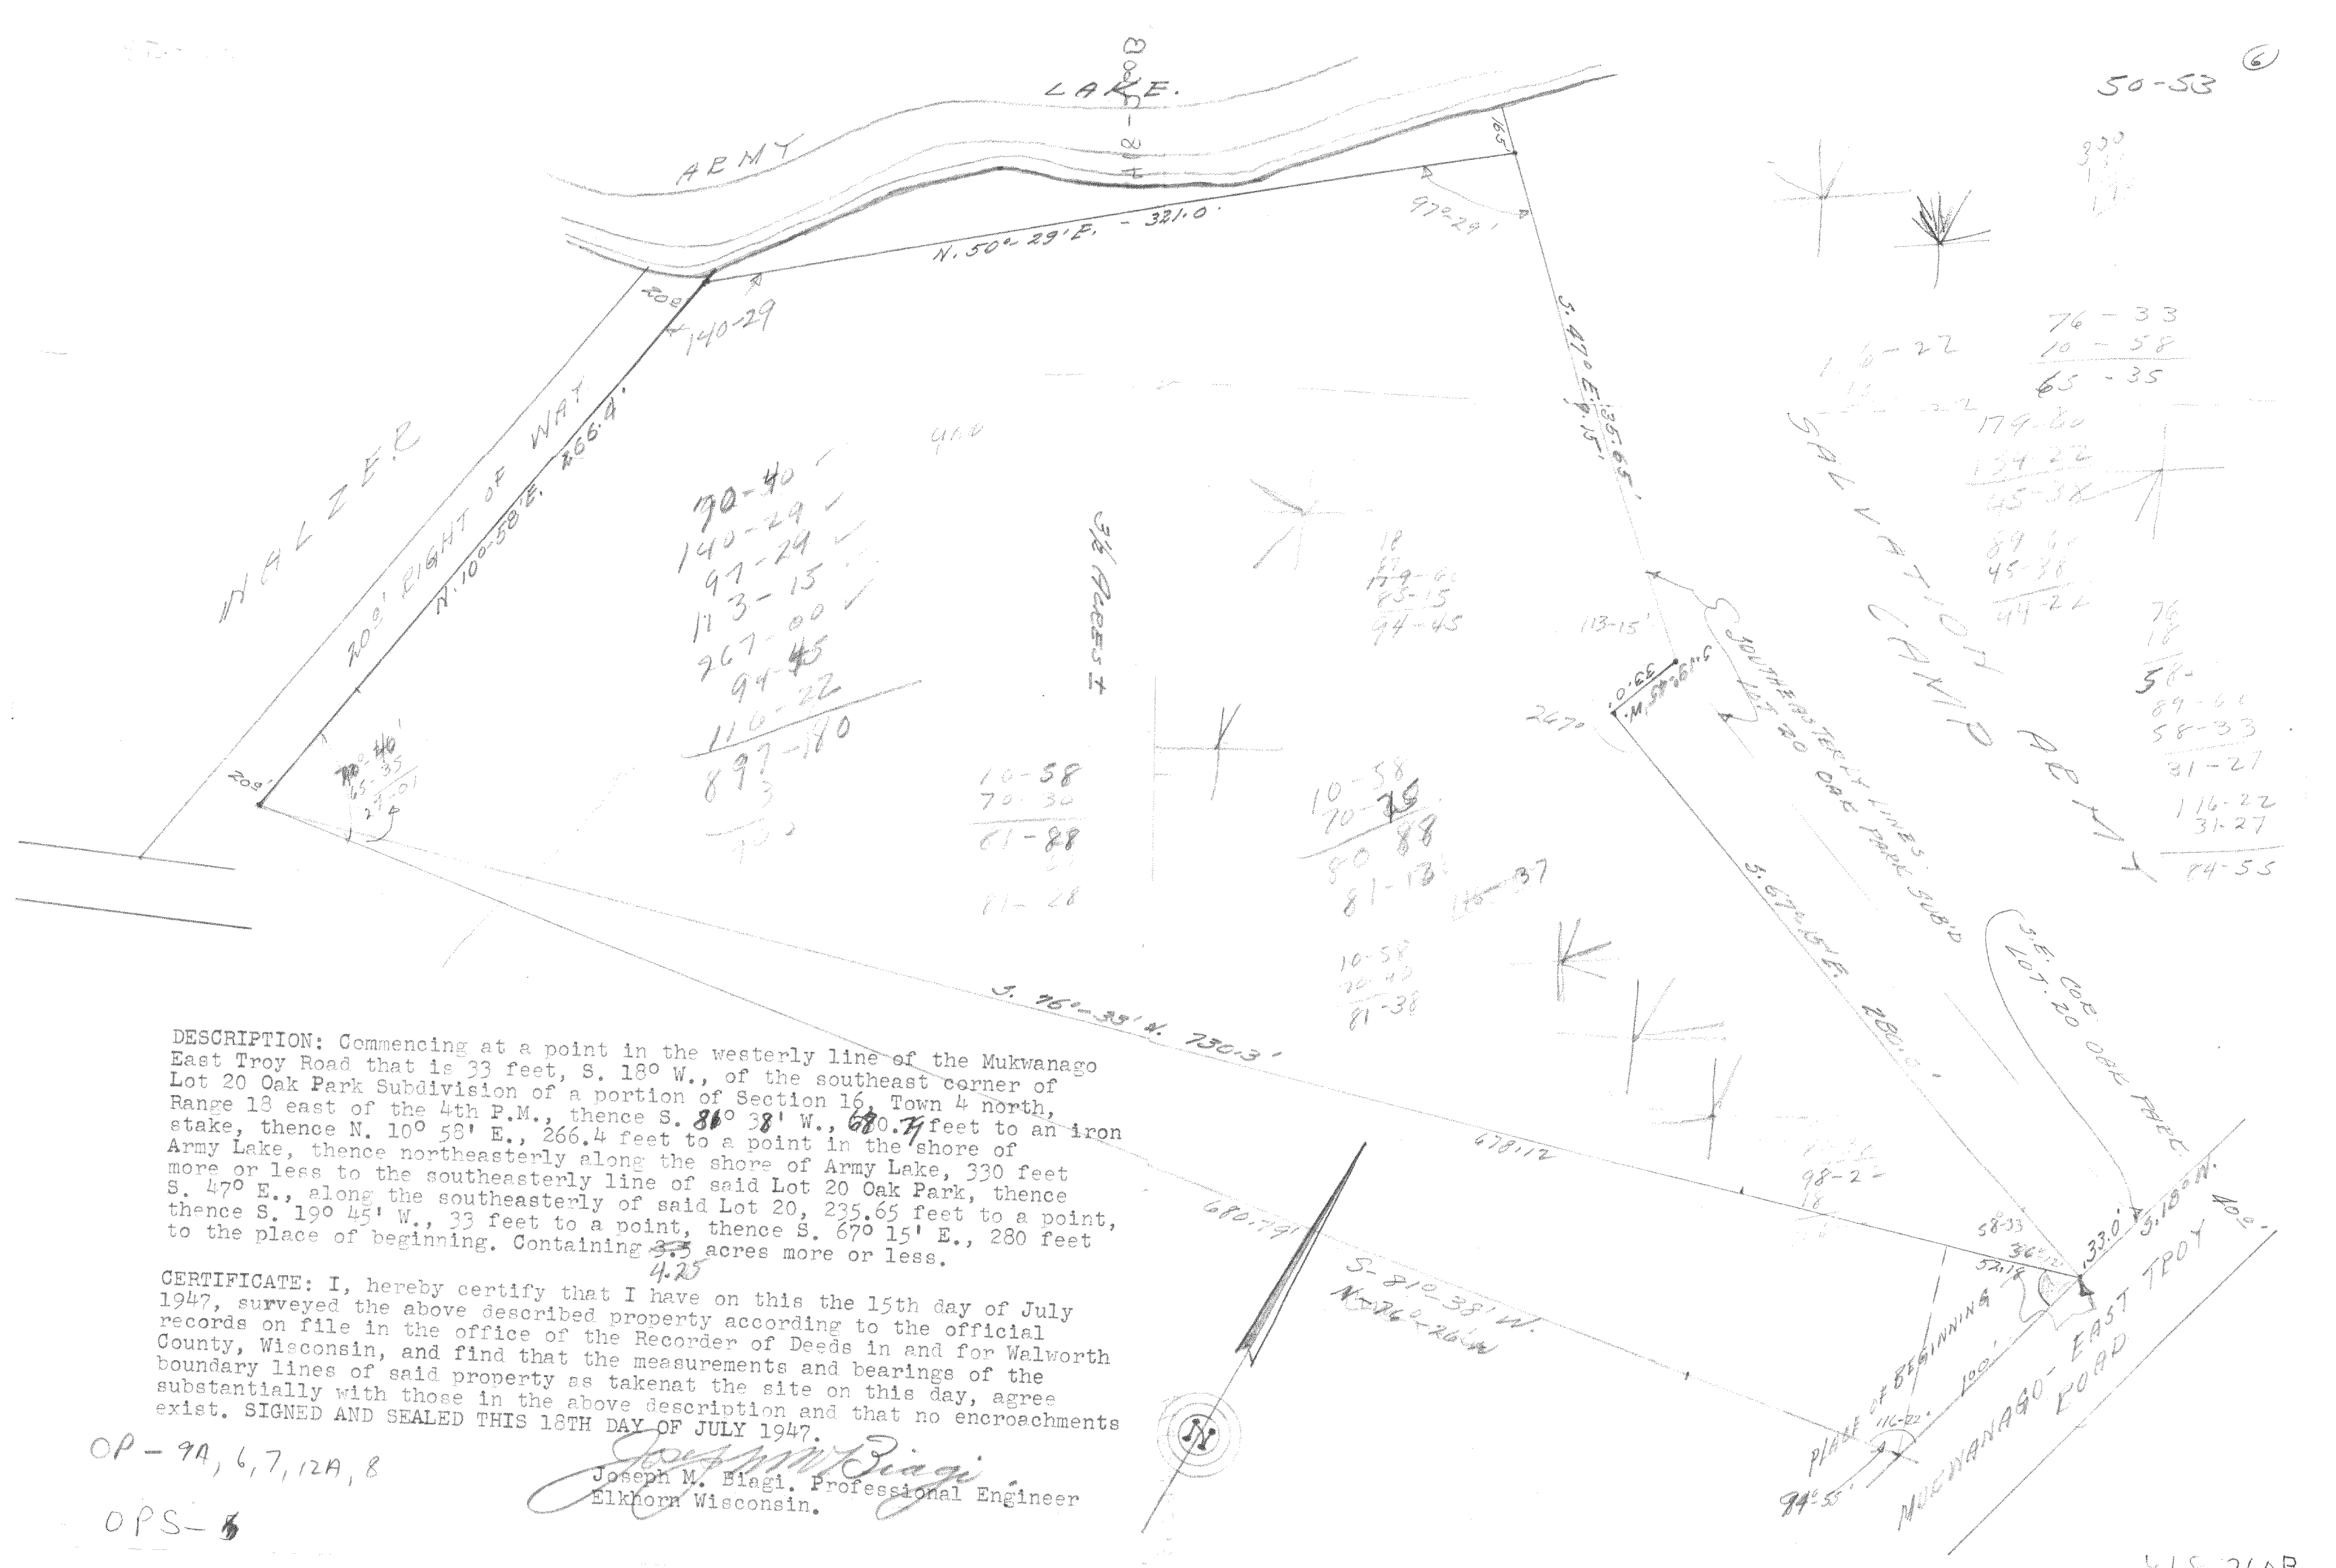

DESCRIPTION: Commencing at a point in the westerly line of the Mukwanago East Troy Road that is 33 feet, S. 18° W., of the southeast corner of Lot 20 Oak Park Subdivision of a portion of Section 16, Town 4 north, Range 18 east of the 4th P.M., thence S. 81° 38' W., 680.79 feet to an iron stake, thence N. 10° 58' E., 266.4 feet to a point in the shore of Army Lake, thence northeasterly along the shore of Army Lake, 330 feet more or less to the southeasterly line of said Lot 20 Oak Park, thence S. 47° E., along the southeasterly of said Lot 20, 235.65 feet to a point, thence S. 19° 45' W., 33 feet to a point, thence S. 67° 15' E., 280 feet to the place of beginning. Containing 4.25 acres more or less.

CERTIFICATE: I, hereby certify that I have on this the 15th day of July 1947, surveyed the above described property according to the official records on file in the office of the Recorder of Deeds in and for Walworth County, Wisconsin, and find that the measurements and bearings of the boundary lines of said property as taken at the site on this day, agree substantially with those in the above description and that no encroachments exist. SIGNED AND SEALED THIS 18TH DAY OF JULY 1947.

Joseph M. Biagi
Professional Engineer
Elkhorn Wisconsin.

OP-9A, 6, 7, 12A, 8

OPS-8