## PLAT OF SURVEY PART OF LOT 2 OF C.S.M. 4521

PART OF THE NE 1/4 AND SE 1/4 OF THE NW 1/4 OF SECTION 10, TOWN 4 NORTH, RANGE 18 EAST, WALWORTH COUNTY, WISCONSIN



SURVEY

AT OF SURVINGE N9200 HIGHWAY ES EAST TROY, WISCONSIN 己

FARRIS, ENGINEER


**REVISIONS** 

PROJECT NO.


8897 DATE: 01/06/2022 SHEET NO.

1 OF 1

415-2001

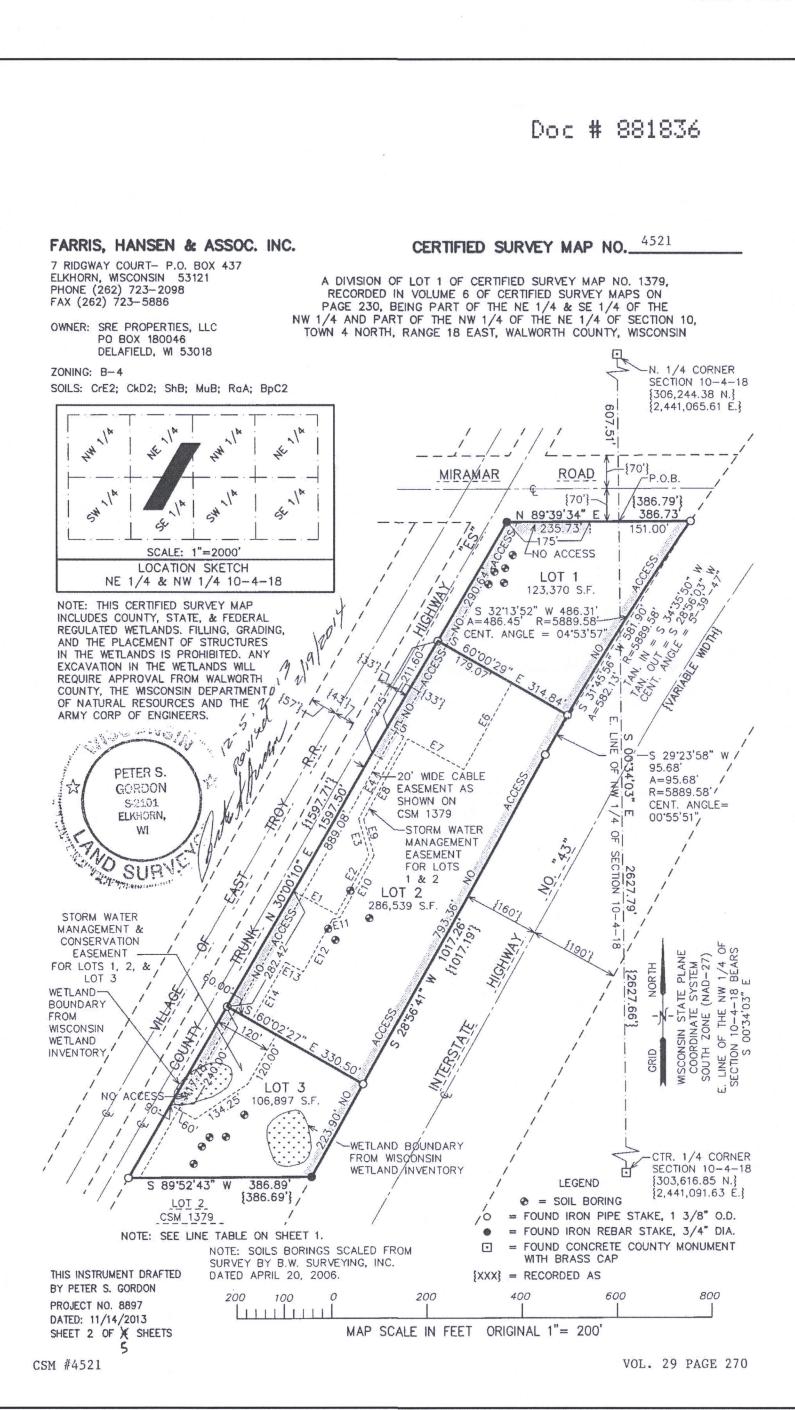

PART OF RECORD CERTIFIED SURVEY MAP NO. 4521

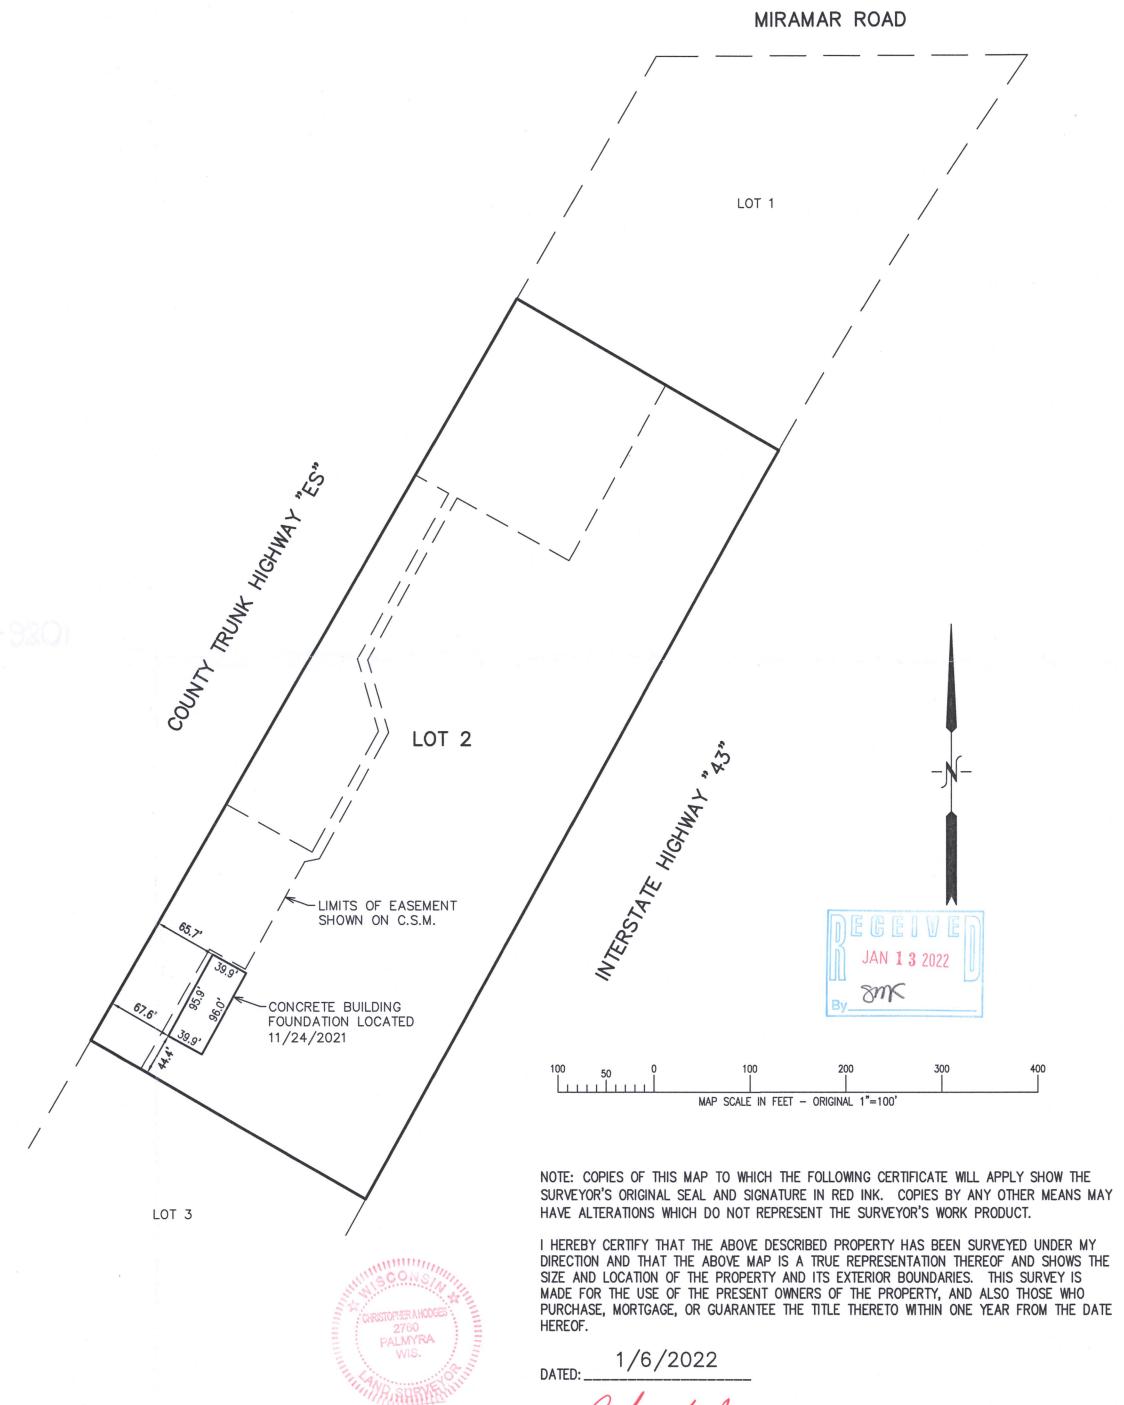

CHRISTOPHER A. HODGES P.L.S. 2760