


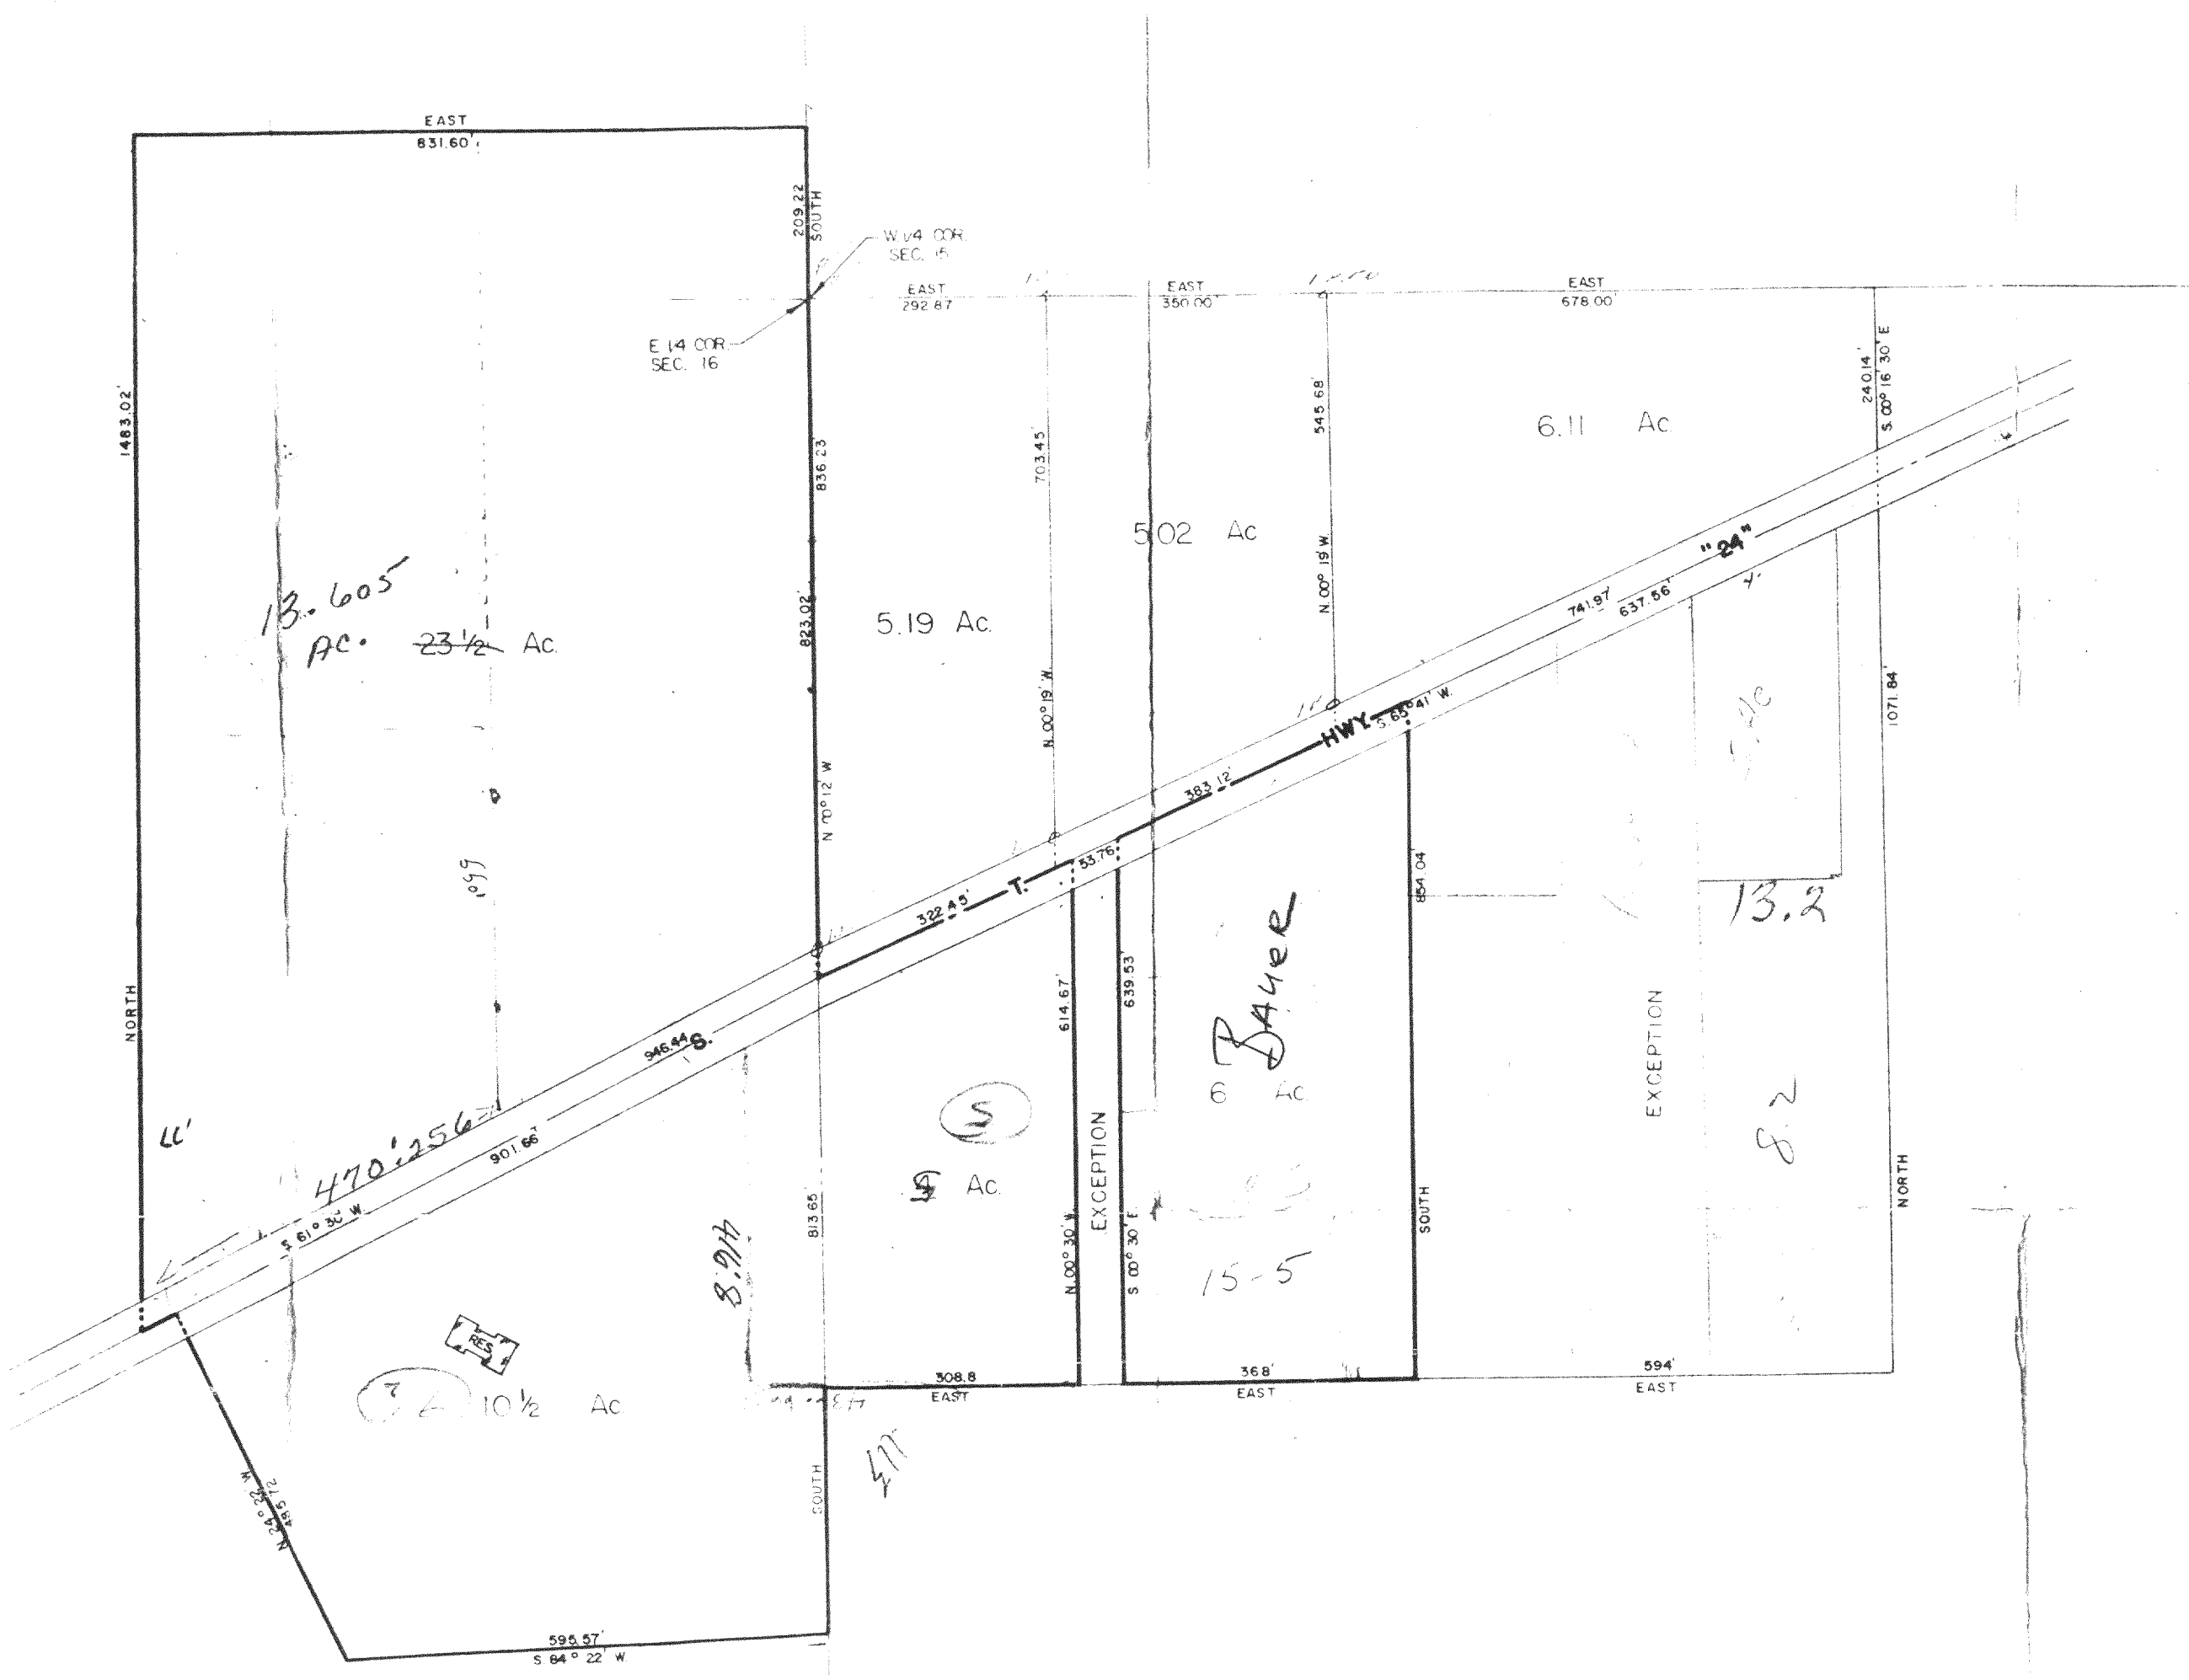


STATE OF WISCONSIN } SS
COUNTY OF WAUKESHA }

I, RONALD H. ZIMMERMAN, REGISTERED LAND SURVEYOR, DO HEREBY CERTIFY THAT I HAVE MADE A MAP
OF THE GERALD BAUER PROPERTY SHOWN ABOVE
AND THAT THE PLAT HEREWITH DRAWN
IS A CORRECT REPRESENTATION THEREOF

DATE SEPT 2 19 71

CERTIFICATION

Ronald H. Zimmerman
RONALD H. ZIMMERMAN S 868

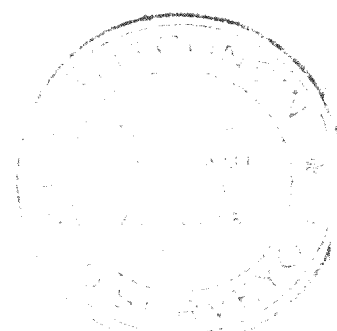

PLAT OF REC FOR

GERALD BAUER

PART — S.W. 1/4 SECTION
E 1/2 SECTION
TOWN OF EAST TROY, WALWORTH

BY • RONALD H. ZIMMERMAN
REGISTERED LAND SURVEYOR
WAUKESHA, WIS.

DRAWN BY — DATE —
CHK'D BY — FILE —

418-280-Z