



PLAT OF SURVEY
FOR: THOMAS MOEHN
PART OF LOTS 12 & 13 MILL SITE SUBD.
TOWN OF EAST TROY, WALWORTH COUNTY, WI.

JAHNKE & JAHKE ASSOCIATES INC.
PLANNERS & PROFESSIONAL ENGINEERS
WAUKESHA — WISCONSIN

SCALE: 1" = 20'	DATE: JULY 7, 1986
DRAWN BY: K. L. T.	FILE NO: WALWORTH 17
BOOK NO: WAL 5, PG 4	SHEET 1 OF 1

REVISION DATES

OCT. 22, 1986 (ELEV)
JUNE 22, 1987 (STK.RES.)
JUNE 30, 1987 (" ")
SEPT. 10, 1987 (ASBUILT)

RECEIVED
JUN 27 2022
By *gmk*

Existing Top of Block 835.72
9/9/87 - Basement constructed
and located as shown.

827.2 - Existing elevation

Bench mark 808.0 (Quadrangle Map) water on
Mill Lake


STATE OF WISCONSIN ss
COUNTY OF WAUKESHA)

We, Jahnke & Jahnke Associates Inc. do hereby certify that we have made this survey and that the information as shown on the above Plat of Survey is a true and correct representation thereof.

840.8.- Existing elevation
Suggested Residence Grade: Lower Level 831.5*
Basement Level 827.0*

*set by builder

SURVEY CERTIFICATE: I have surveyed the above described property and the map shown is a true representation thereof and shows the size and location of the property, its exterior boundaries, the location and dimensions of all visible structures thereon, fences, apparent easements and roadways, and visible encroachments, if any. This survey is made for the exclusive use of the present owners of the property and also those who purchase, mortgage or guarantee the title thereto within one (1) year from date hereof and as to them I warrant the accuracy of said survey and map.

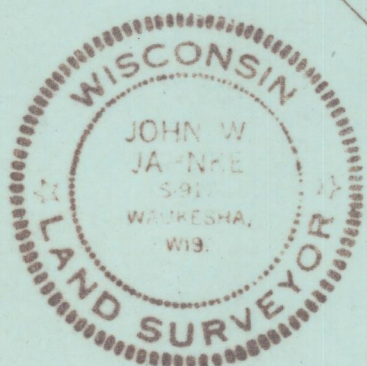

JOHN W. JAHNKE - Wis. Reg. No. S-917
Dated this 8th day of July, 1986.
Revised this 22nd day of June, 1987

PM1-7

418-2843