
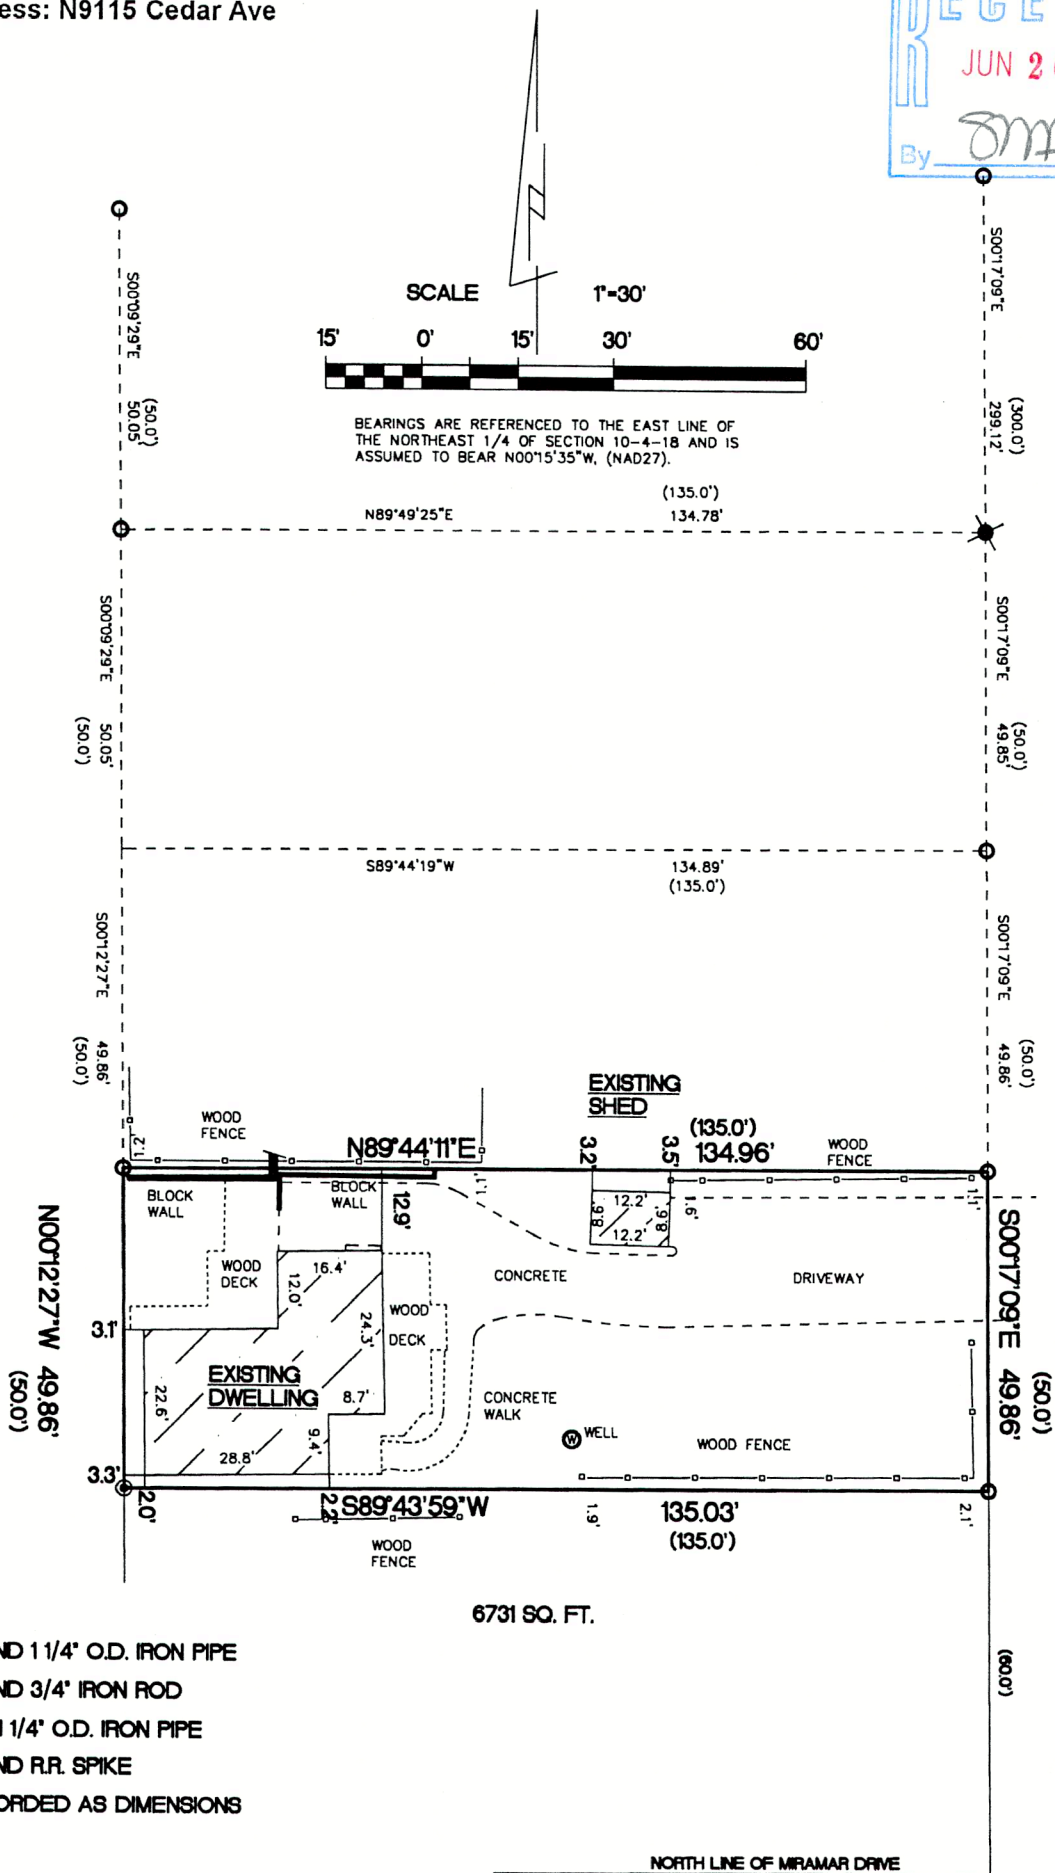


PLAT OF SURVEY

LOT 13 IN BLOCK 6 IN MIRAMAR SUBDIVISION, being a part of the East 1/2 of Section 10 and the West 1/2 of Section 11, Town 4 North, Range 18 East, Town of East Troy, Walworth County, Wisconsin.

Surveyed for: Daniel Covert  
Survey address: N9115 Cedar Ave

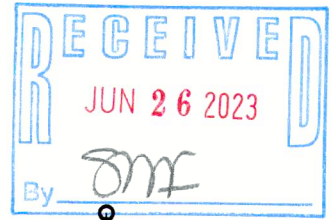

CEDAR AVENUE

- FOUND 1 1/4" O.D. IRON PIPE
- ⊙ FOUND 3/4" IRON ROD
- SET 1 1/4" O.D. IRON PIPE
- ✱ FOUND R.R. SPIKE
- ( ) RECORDED AS DIMENSIONS

6731 SQ. FT.

NORTH LINE OF MIRAMAR DRIVE

KETTLE MORaine SURVEYING INC.  
S75 W36245 Wilton Road  
Eagle Wisconsin 53119  
P.O. Box 357  
(262) 594-3484  
kettlemorainesurvey.com  
Terrance E. Pisarek P.L.S.



THIS IS NOT AN ORIGINAL SURVEY UNLESS THE SEAL IS RED.

"I hereby certify that I have surveyed the above described property and that the above map is a true representation thereof and shows the size and location of the property, its exterior boundaries, the location of all visible structures and dimensions of all principal buildings thereon, boundary fences, apparent easements, roadways and encroachments if any"

"This survey is made for the use of the present owners of the property, and also those who purchase, mortgage or guarantee the title thereto within one year from date hereof."

REV. 2/13/2023  
9/27/18

DATE

TEP  
FIELD WORK BY

TEP  
DRAWN BY

18116  
JOB NUMBER

PMR-80

418-2890