


PLAT OF SURVEY

LOT 2, CERTIFIED SURVEY MAP No. 30, BEING A PART OF THE EAST 1/2 OF SECTION 9, TOWNSHIP 4 NORTH, RANGE 18 EAST, TOWN OF EAST TROY, WALWORTH COUNTY, WISCONSIN.

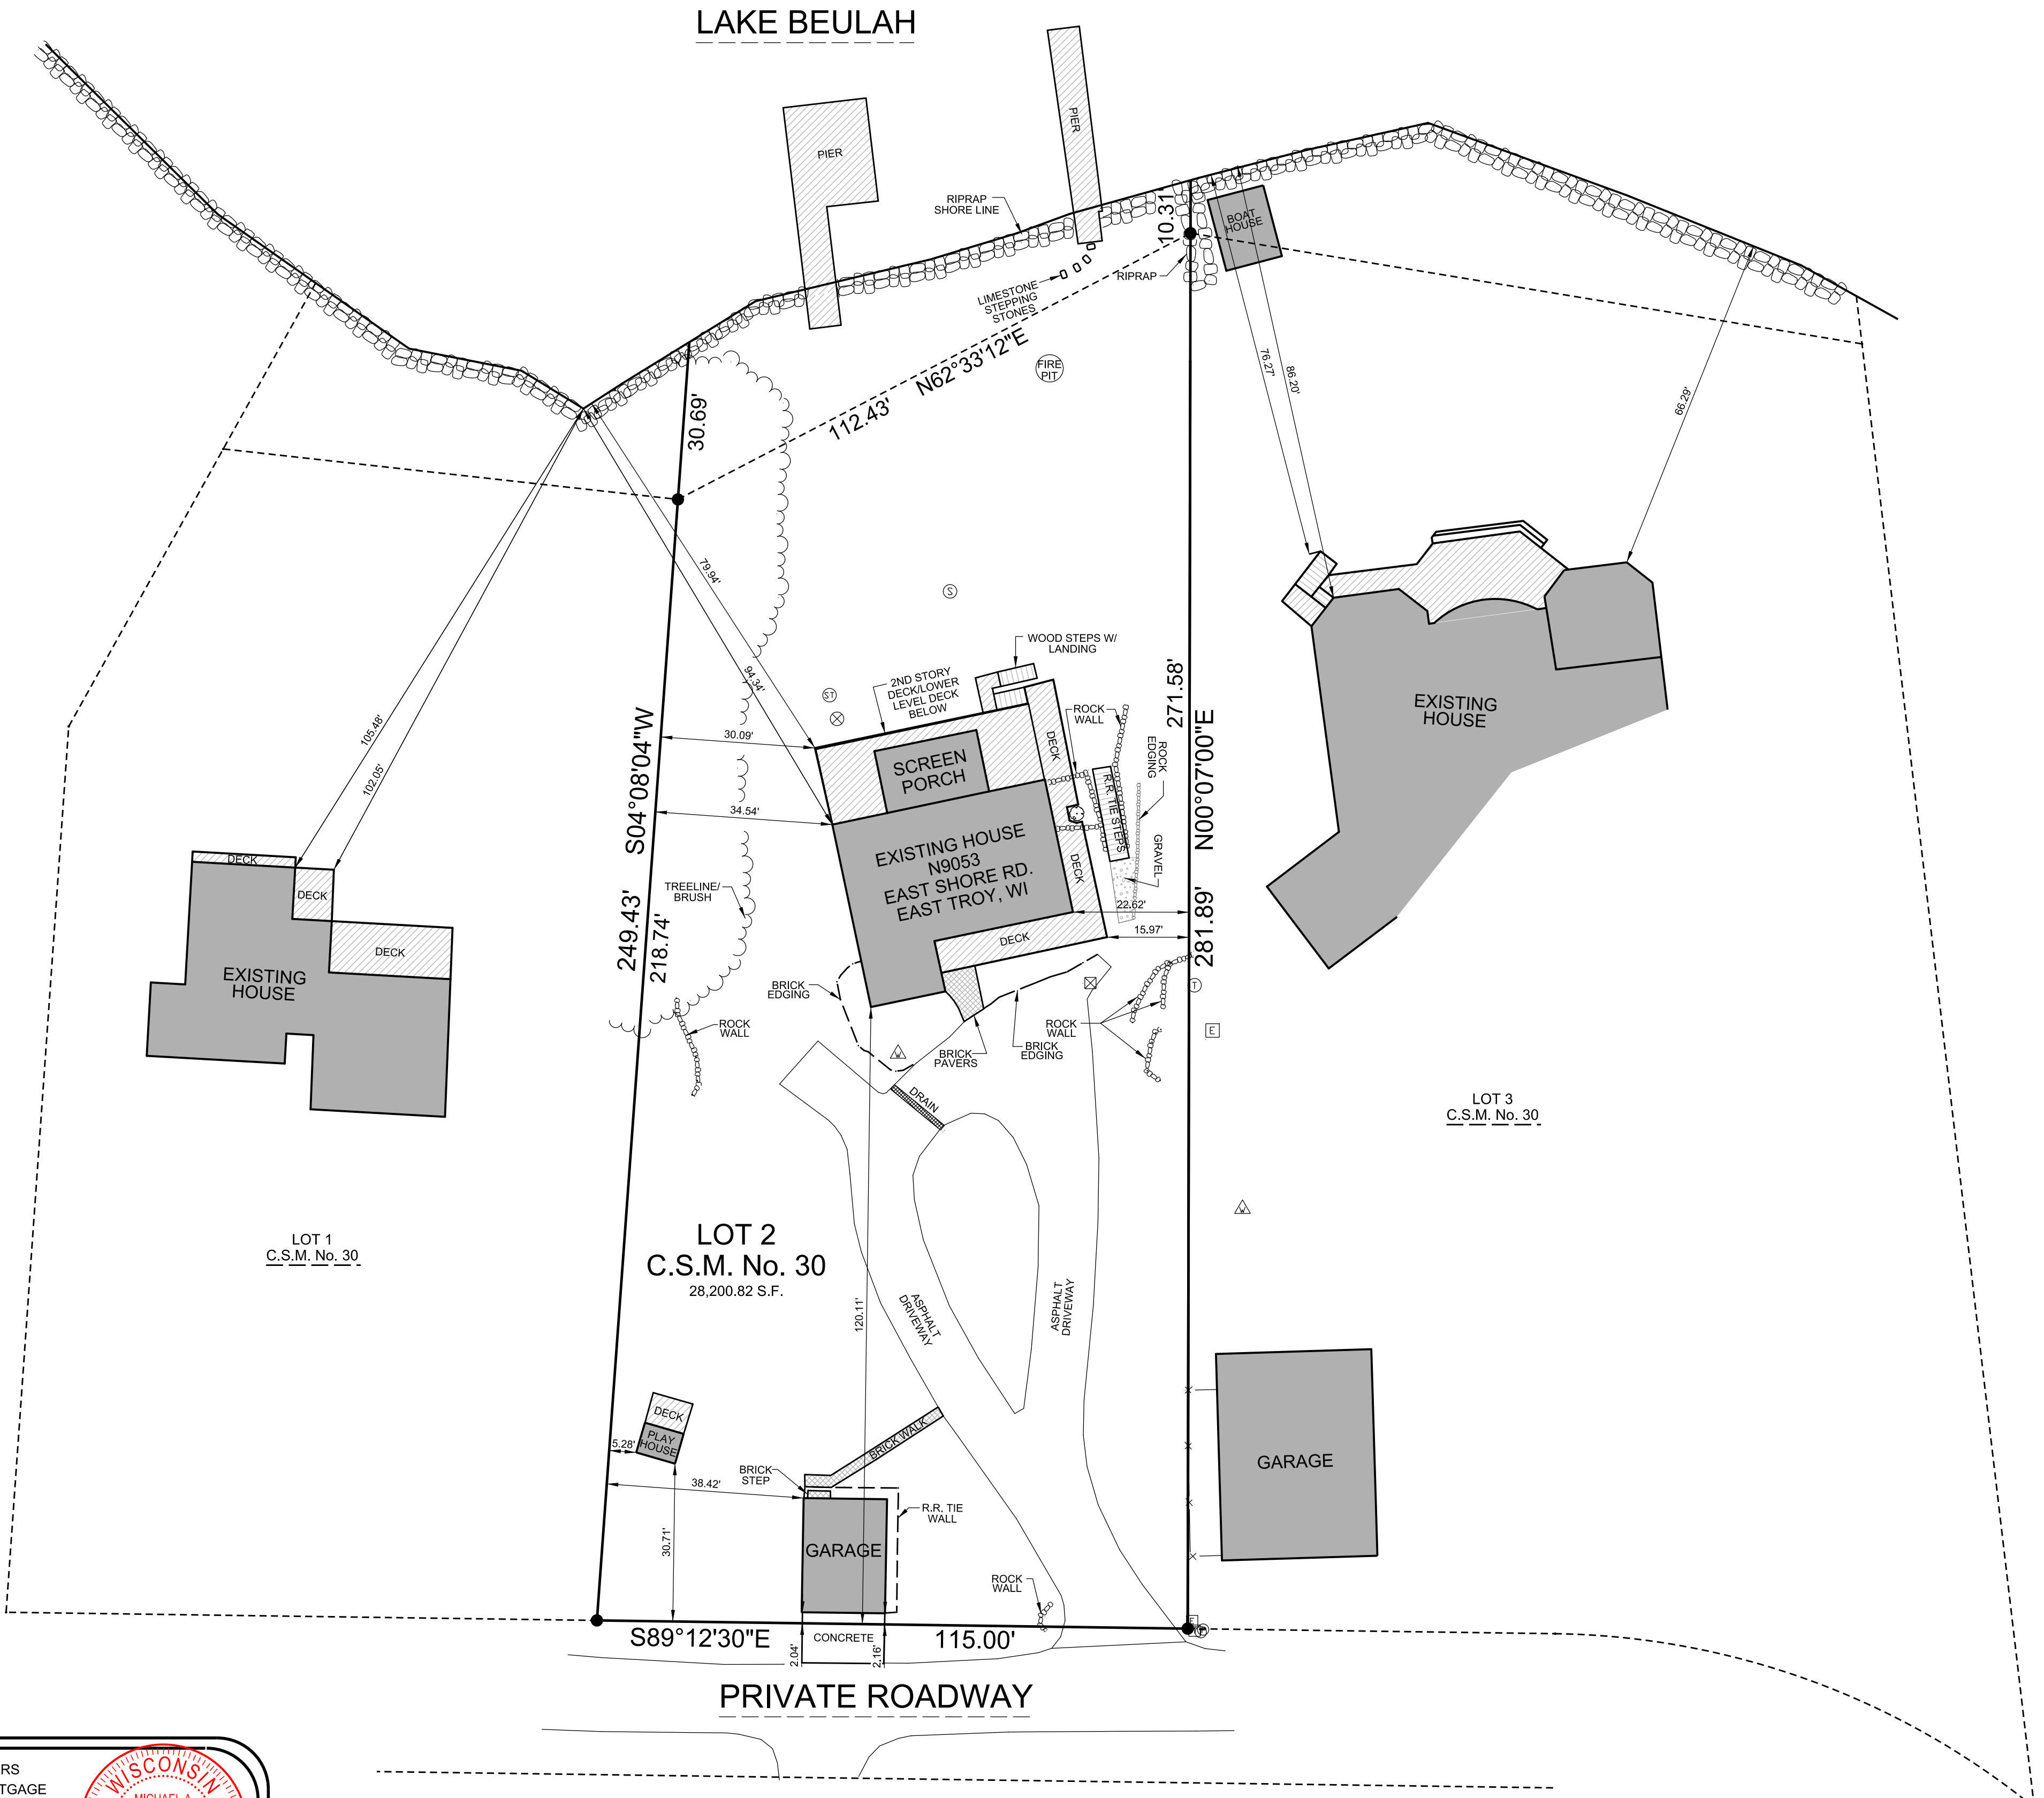

LEGEND:

(100.00')	RECORDED DISTANCE
100.00'	MEASURED DISTANCE
●	1" FOUND IRON PIPE, UNLESS NOTED
⊗	3/4" x 18" IRON PIPE SET, 1.13 lbs./L.F.
⚠	WELL
Ⓣ	SEPTIC TANK
Ⓢ	SEPTIC VENT
⊠	FIELD DRAIN
ⓔ	ELECTRIC TRANSFORMER
ⓔ	ELECTRIC PEDESTAL
Ⓣ	TELEPHONE PEDESTAL
Ⓣ	CABLE TV PEDESTAL

V²G
SURVEYING, LLC

123 WOLF RUN - SUITE 4
MUKWONAGO, WI 53149
(262) 378-5097

SURVEY MADE FOR:
ROB MILLER HOMES
706 Main St.
Delafield, WI 53018

DATE	ITEM
05/24/2023	PLAT OF SURVEY

THIS SURVEY IS MADE FOR THE USE OF THE PRESENT OWNERS OF THE PROPERTY, AND ALSO THOSE WHO PURCHASE, MORTGAGE OR GUARANTEE TITLE TO WITHIN ONE (1) YEAR FROM DATE HERETO.

I, MICHAEL A. GREESON P.L.S. #2770, HEREBY CERTIFY THAT THIS SURVEY WAS MADE IN ACCORDANCE WITH THE MINIMUM STANDARDS FOR PROPERTY SURVEYS (CHAPTER A-E 7) FOR THE STATE OF WISCONSIN AND HAS BEEN PREPARED UNDER MY DIRECTION AND CONTROL AND IS CORRECT TO THE BEST OF MY KNOWLEDGE AND BELIEF.

Michael A. Greeson

FILE NAME: 2023-064 R. MILLER HOMES N9053 EAST SHORE RD.DGN

PLOT DATE: 05/24/2023

V2G JOB#: 2023-064