

KOLB LAND CONSULTING, INC.
LAND SURVEYING • SUBDIVIDING • LAND PLANNING


LAKE GENEVA, WISCONSIN 53147

WHITEWATER, WISCONSIN 53190

SWABODA

ROAD


66' WIDE

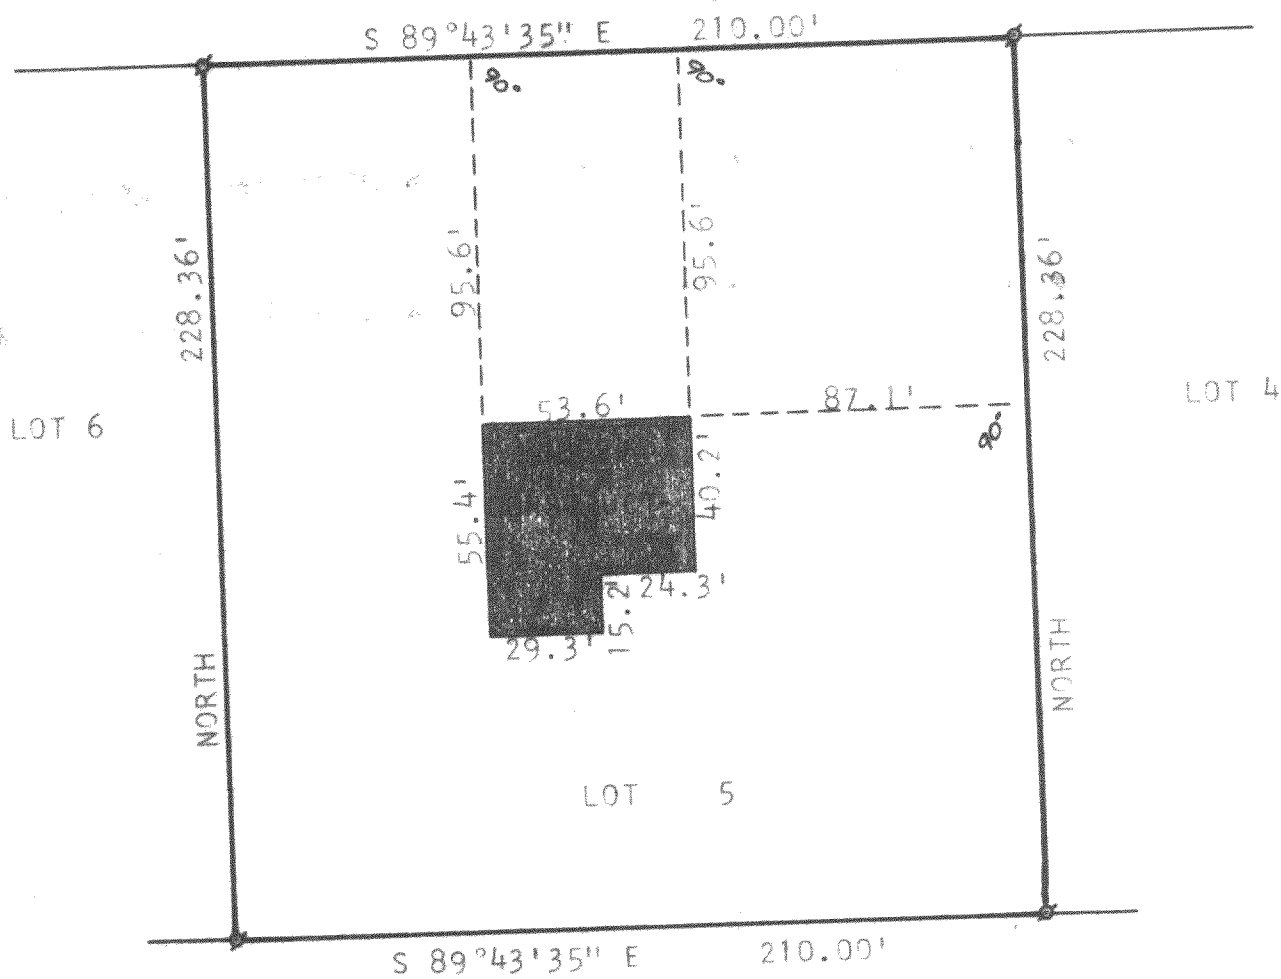

PLAT OF SURVEY OF

LOT 5 OF AMES MANOR, A SUBDIVISION
LOCATED IN THE SOUTHEAST $\frac{1}{4}$ OF THE
SOUTHWEST $\frac{1}{4}$ OF SECTION 31, T4N, R18E,
WALWORTH COUNTY, WISCONSIN.

ORDERED BY: JEAN MOEHRLE

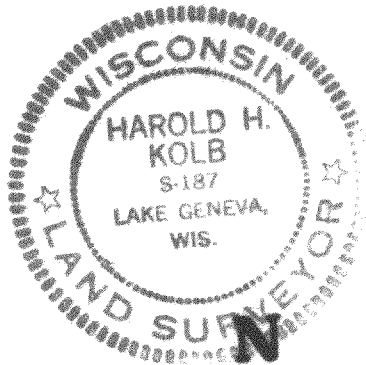

SCALE - 1"=50'

LEGEND

- ⊙ - IRON PIPE FOUND
- - IRON PIPE SET

I, HAROLD H. KOLB, DO HEREBY CERTIFY THAT I
HAVE SURVEYED THE PROPERTY HEREON DESCRIBED
ACCORDING TO THE OFFICIAL RECORDS, AND THAT
THE PLAT HEREON IS A CORRECT REPRESENTATION
OF THE LOT LINES TO THE BEST OF MY KNOWLEDGE
AND BELIEF.

Harold H. Kolb

HAROLD H. KOLB
WISCONSIN REGISTERED LAND SURVEYOR, S-187

DATE Feb. 8, 1979

PAM-5

418-341K