


PLAT OF SURVEY

OF LOT 15, BLOCK 1 OF MAPAMAR SUBDIVISION, LOCATED IN THE EAST 1/2
OF SECTION 11, T4N, R15E, WALWORTH COUNTY, WIS.

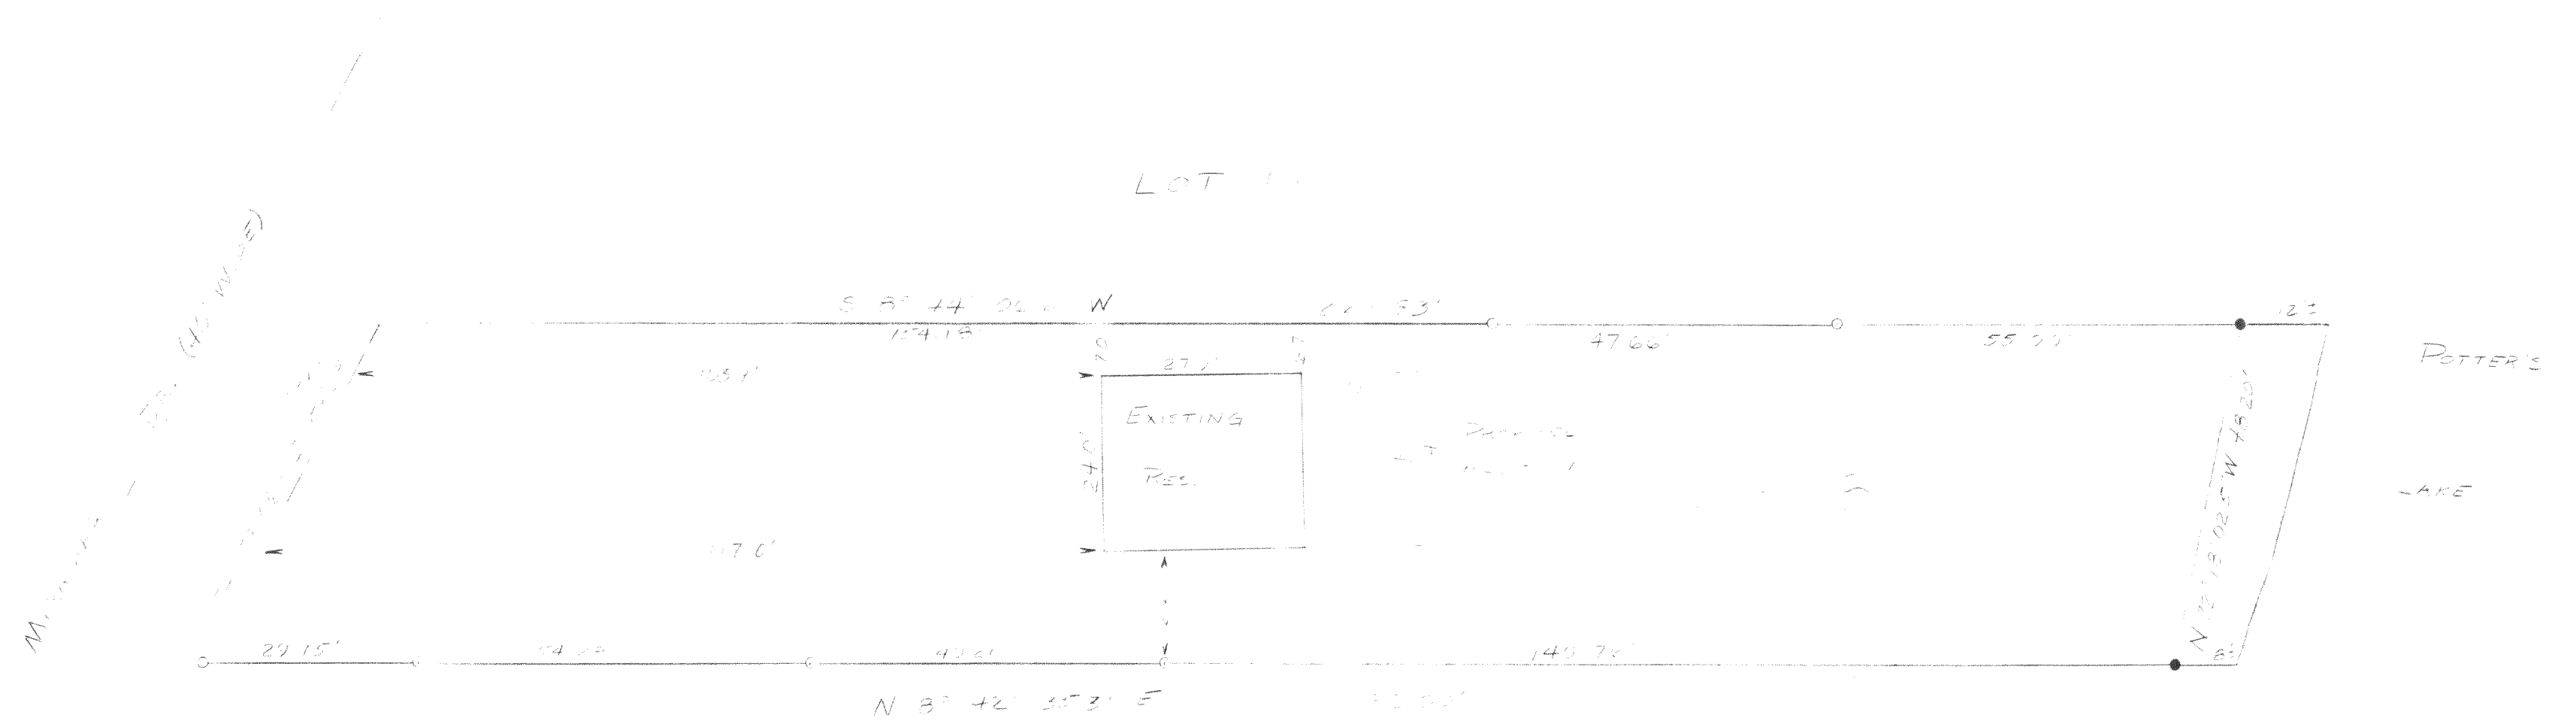

BEARINGS REFERENCED TO THE EAST LINE OF LOT 15
AS SHOWN S 89° 44' 06" W

LEGEND

- - IRON PIN SET
- - IRON PIN SET 1/4"

Surveyors Certificate

I, WILLIAM A. SHEARMAN, a duly licensed Professional Engineer and Surveyor in the State of Wisconsin, do hereby certify that the foregoing is a true and correct copy of the original survey and a true representation thereof, and that the same was made by me or under my direct supervision.

All divisions of said property have been surveyed and shown on this plat. The plat is a true and correct copy of the original survey and a true representation thereof, and that the same was made by me or under my direct supervision.

DATED THIS 1ST DAY OF JULY, 1979.

WILLIAM A. SHEARMAN, S.E.
Professional Engineer and Surveyor
PME-ISA

William A. Shearman


JENSEN & JOHNSON

ENGINEERS AND SURVEYORS

PO BOX 290, ELKHORN, WISCONSIN

414-723-3204

A Division of
Donohue & Associates, Inc.

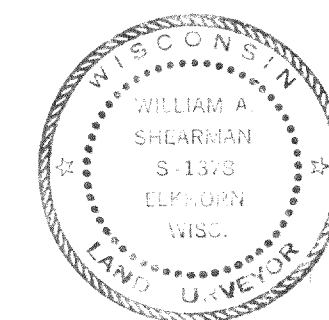

Date	7-31-79	Scale	1" = 20'
Drawn By	WJ	Surveyed For	THOMAS KUNDMANN
Checked By		Project No.	1658.326