

78-344-2


910 ELM GROVE RD.  
ELM GROVE, WISCONSIN 53122  
PHONE: 782-8690

PREPARED FOR:  
LOCATION

Floyd Surridge  
Wilmer's Grove Road (Town of East Troy)

DESCRIPTION OF PROPERTY

Lots 60 & 61 - WILMER GROVE BEACH, in Town 4 North, Range 18 East,  
Town of East Troy, Walworth County, Wisconsin.

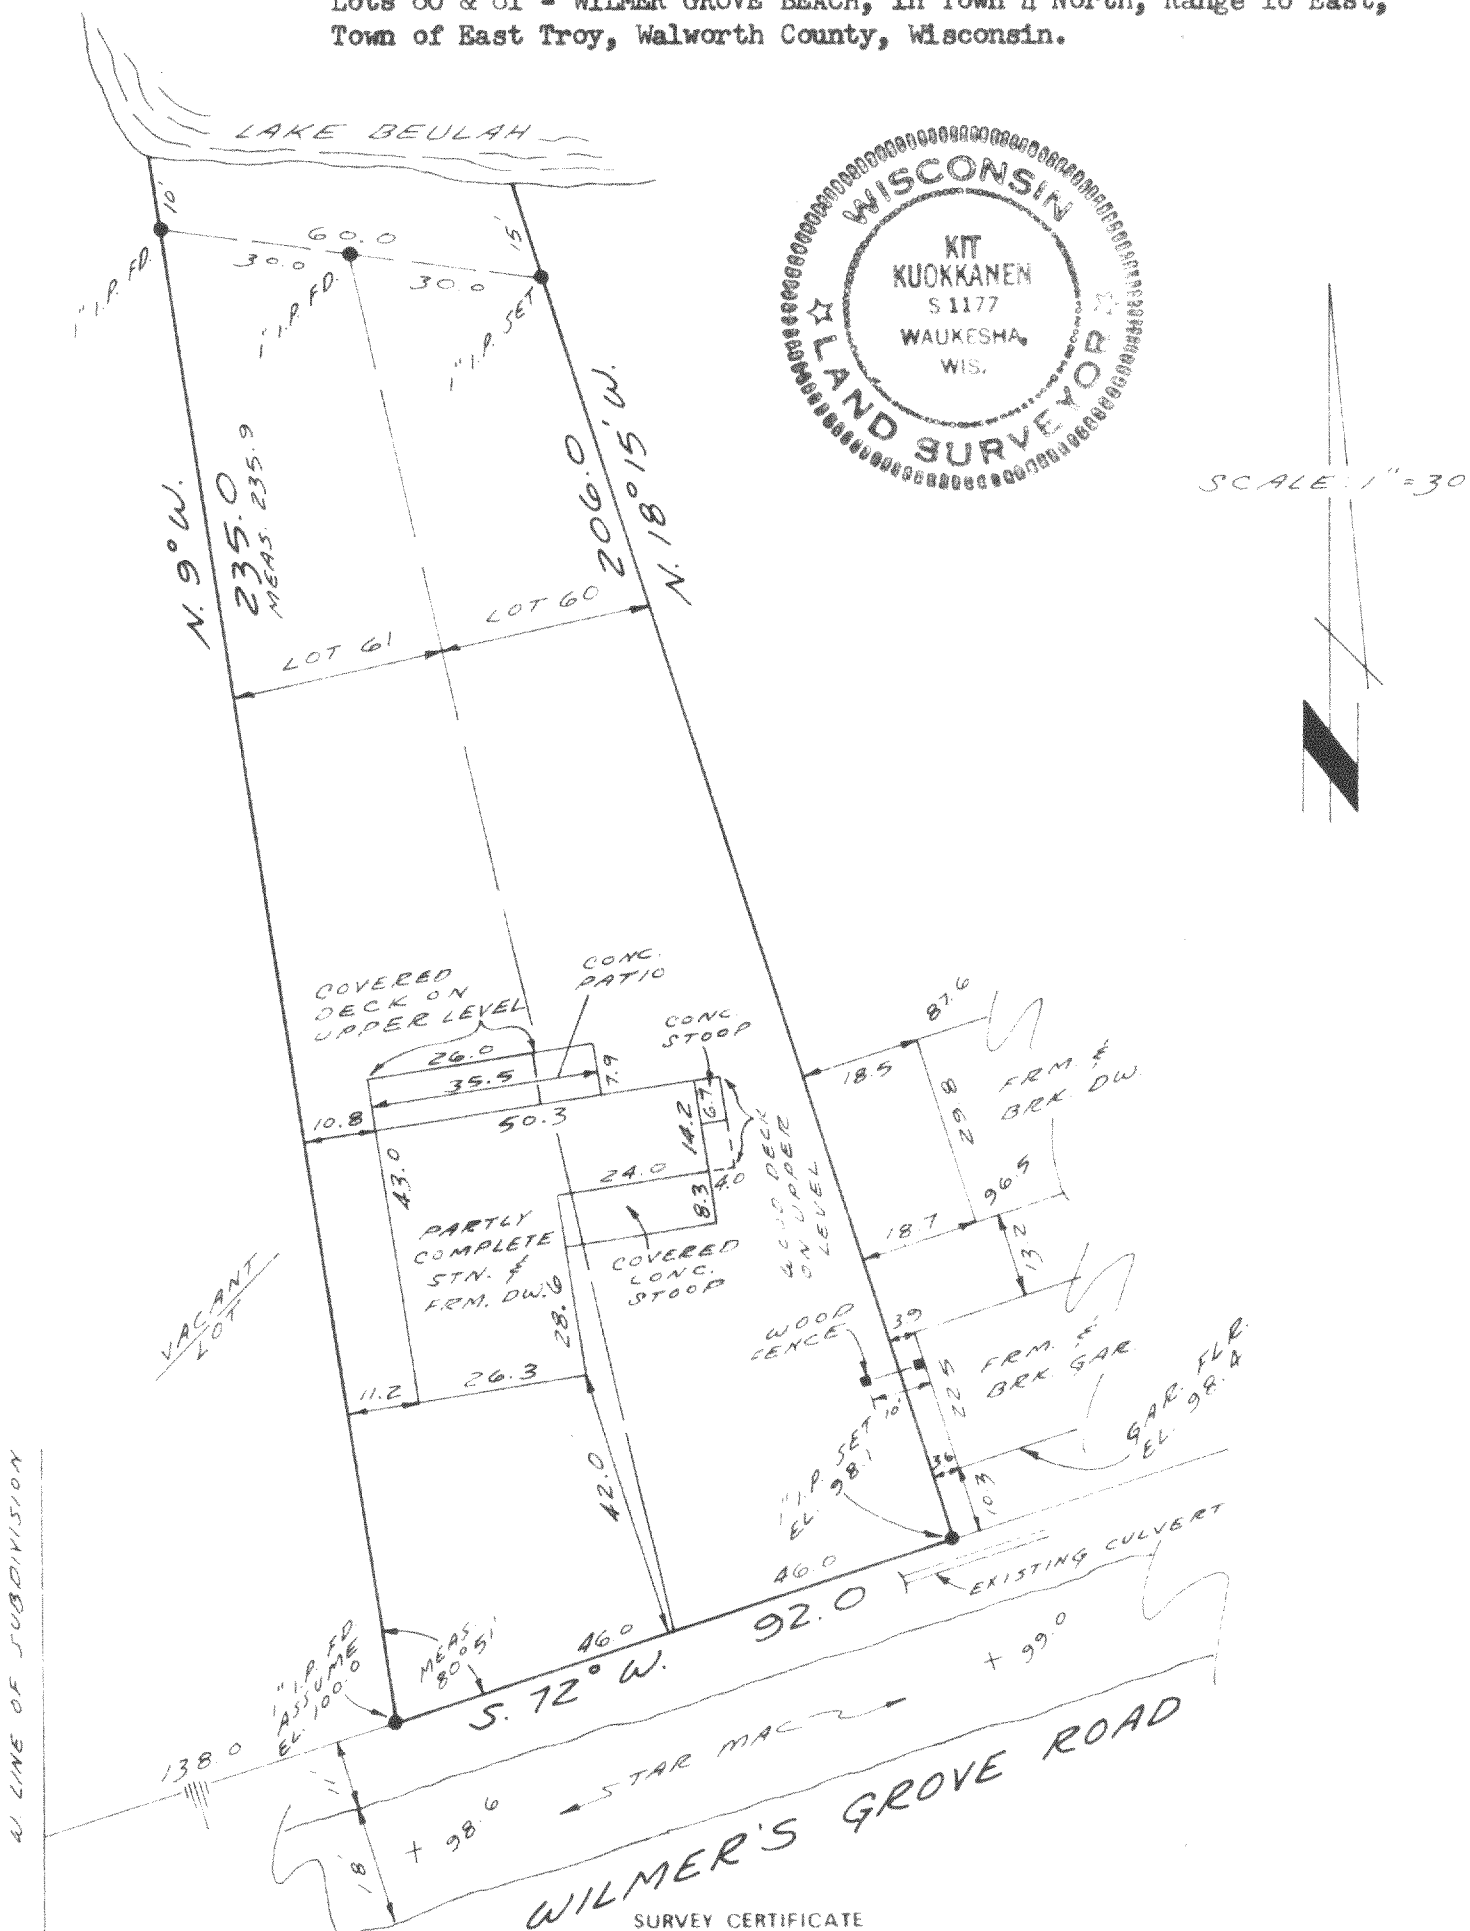

## SURVEY CERTIFICATE

I HAVE SURVEYED THE ABOVE-DESCRIBED PROPERTY AND THE ABOVE MAP IS A TRUE REPRESENTATION THEREOF AND SHOWS THE SIZE AND LOCATION OF THE PROPERTY, ITS EXTERIOR BOUNDARIES, THE LOCATION AND DIMENSIONS OF ALL VISIBLE STRUCTURES THEREON, FENCES, APPARENT EASEMENTS AND ROADWAYS AND VISIBLE ENCROACHMENTS, IF ANY.

THIS SURVEY IS MADE FOR THE EXCLUSIVE USE OF THE PRESENT OWNERS OF THE PROPERTY, AND ALSO THOSE WHO PURCHASE, MORTGAGE, OR GUARANTEE THE TITLE THERETO WITHIN ONE (1) YEAR FROM DATE HEREOF.

Dated at

this 19<sup>TH</sup> day of SEPTEMBER, 1978

REVISED 9-29-78

RECERTIFICATION 3-10-80

## Survey

415-426