


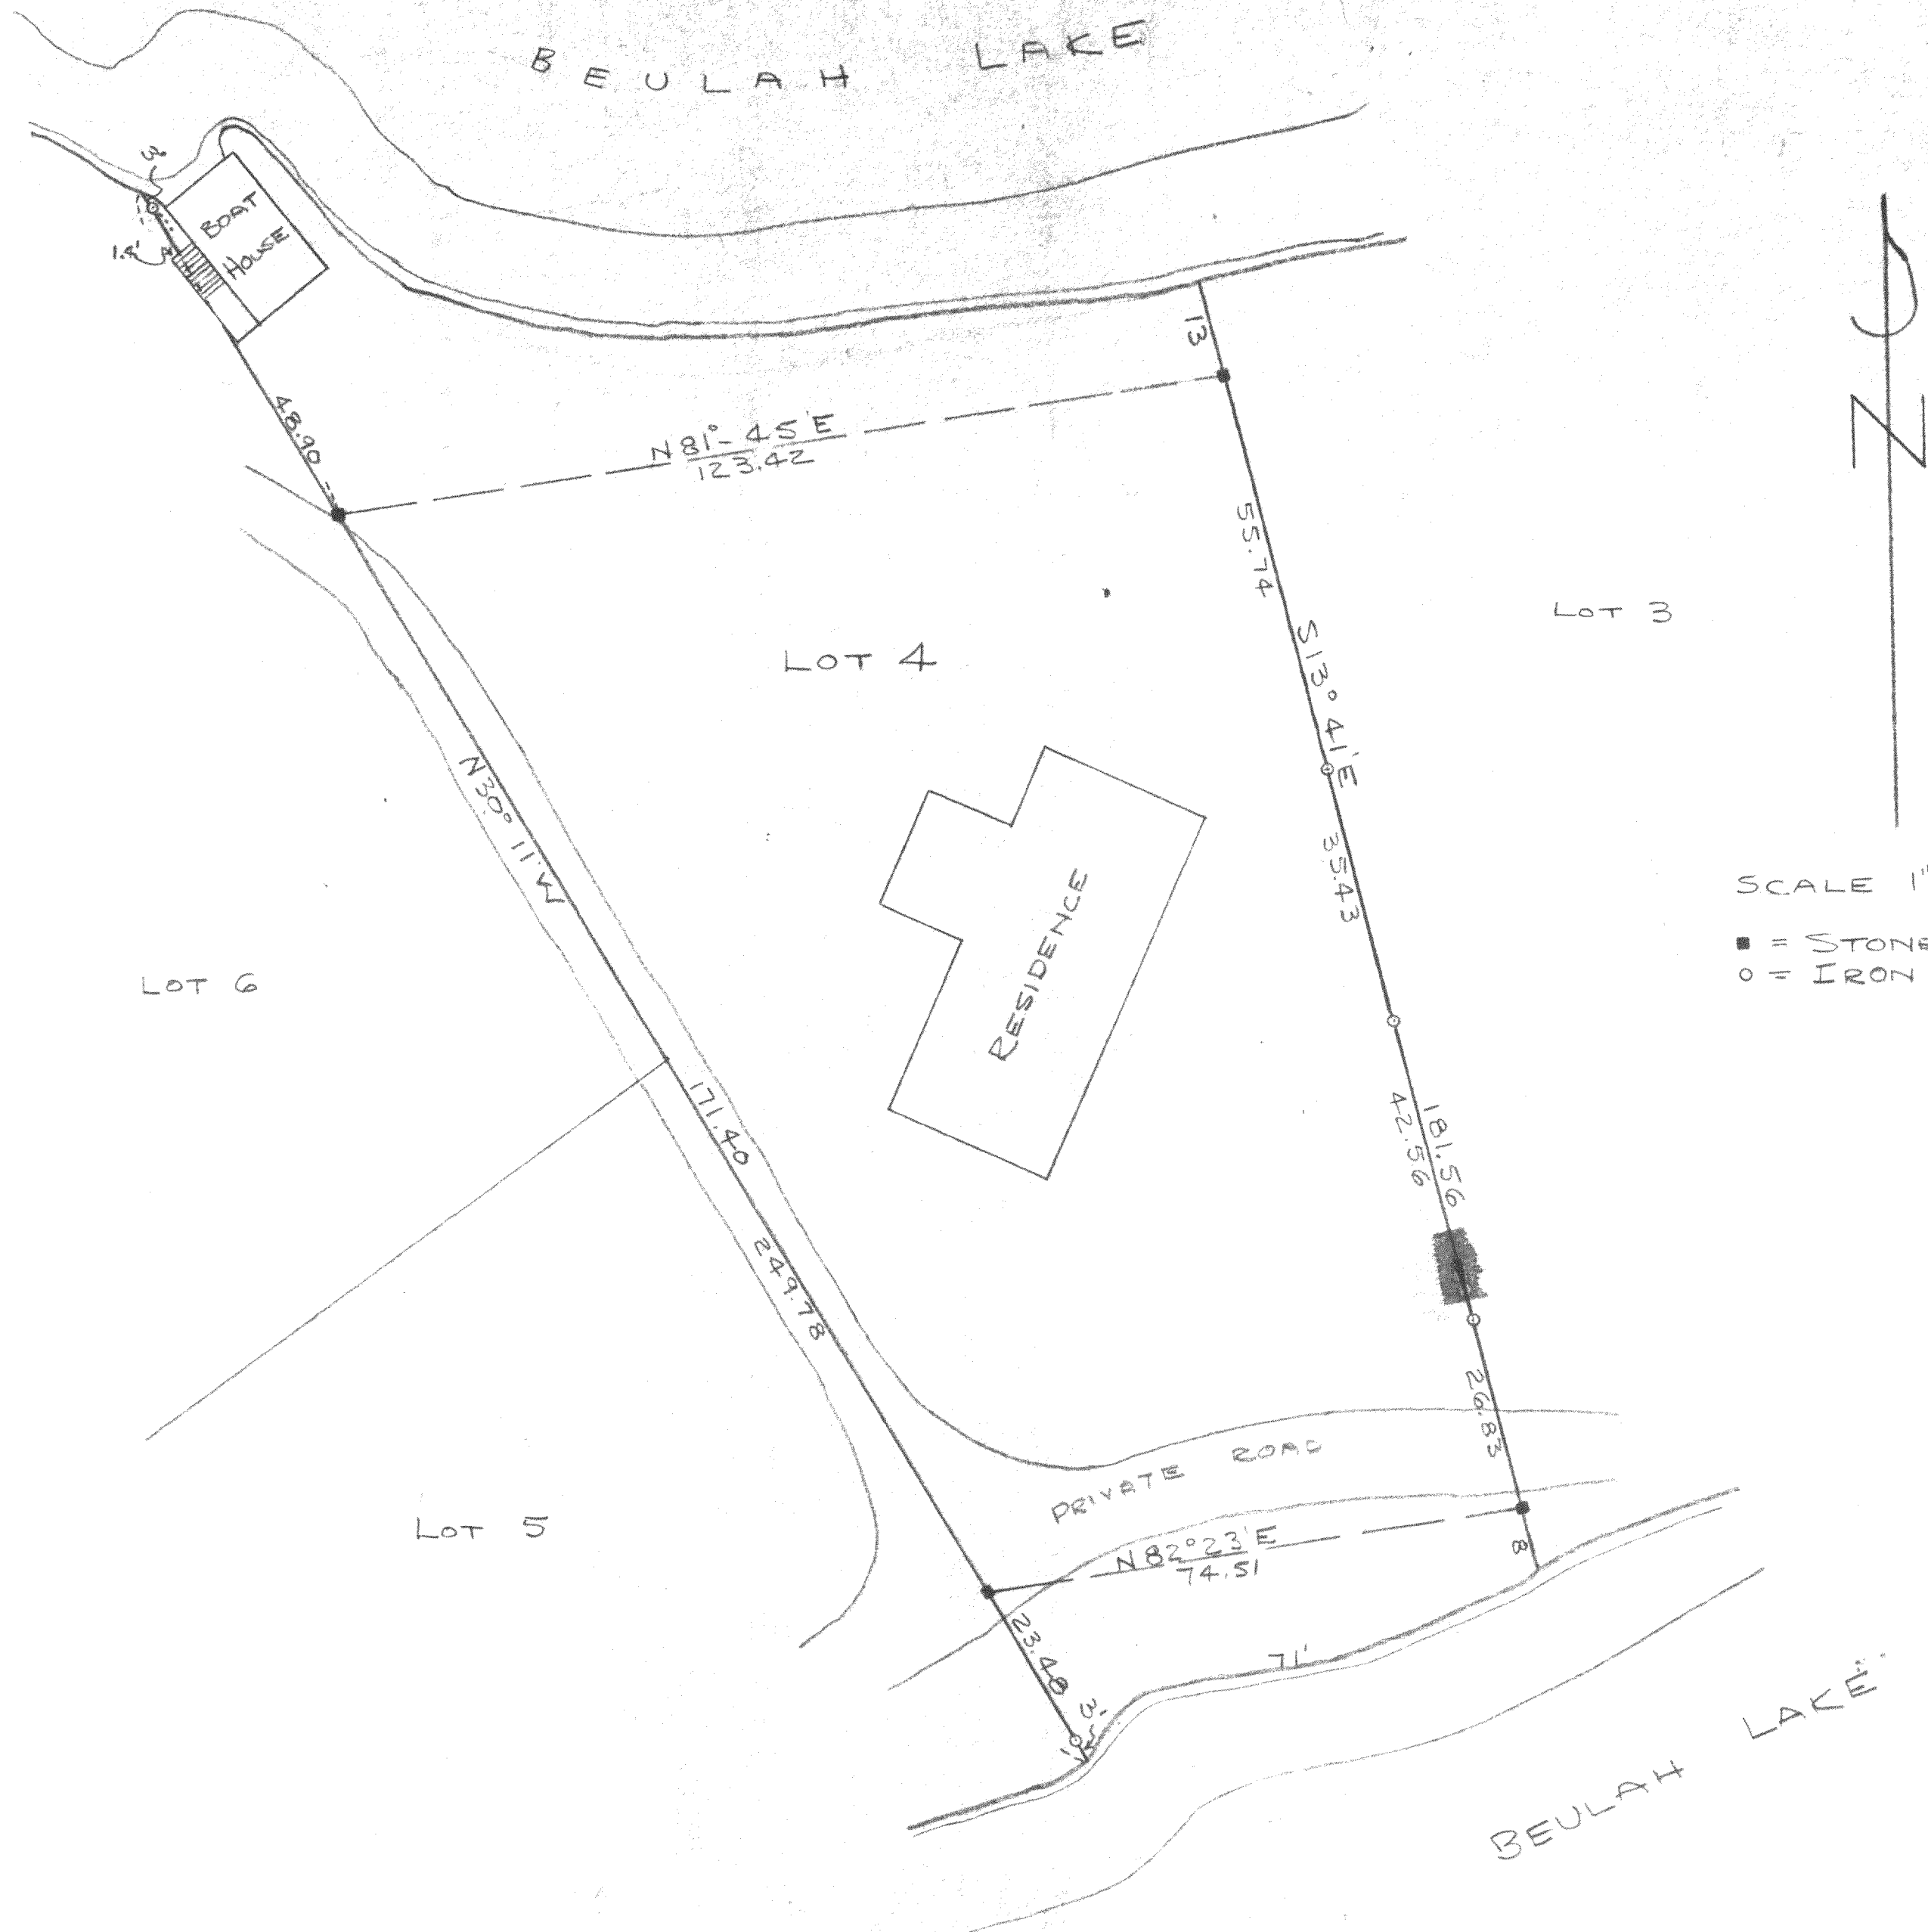

STATE OF WISCONSIN) ss
COUNTY OF WALWORTH)
I, LLOYD L. JENSEN, DO HEREBY CERTIFY THAT I HAVE
SURVEYED THE PROPERTY DESCRIBED, ACCORDING TO THE
OFFICIAL RECORDS, AS FOLLOWS:
LOT 4 OF CHAMBERLAIN'S SUBDIVISION LOCATED IN
THE NORTHWEST 1/4 OF SECTION 9, T4N R18E,
WALWORTH COUNTY, WISCONSIN;
AND THAT THE PLAT SHOWN ABOVE IS A CORRECT REPRESENT-
ATION OF THE LOT LINES AND THE PRINCIPAL LINES OF ALL
BUILDINGS THEREON.

ELKHORN, WIS.
APRIL 3, 1951

Lloyd L. Jensen
COUNTY SURVEYOR

418-435