


Plat of Survey

FOR: MERRILL LYNCH - GROSZ

DESCRIPTION: Certified Survey Map number 421 recorded October 18, 1974 in Volume 2 of Certified Survey Maps as document Number 684362 located in the Northwest 1/4 of Section 32, T4N, R18E, Town of East Troy, Walworth County, Wisconsin.

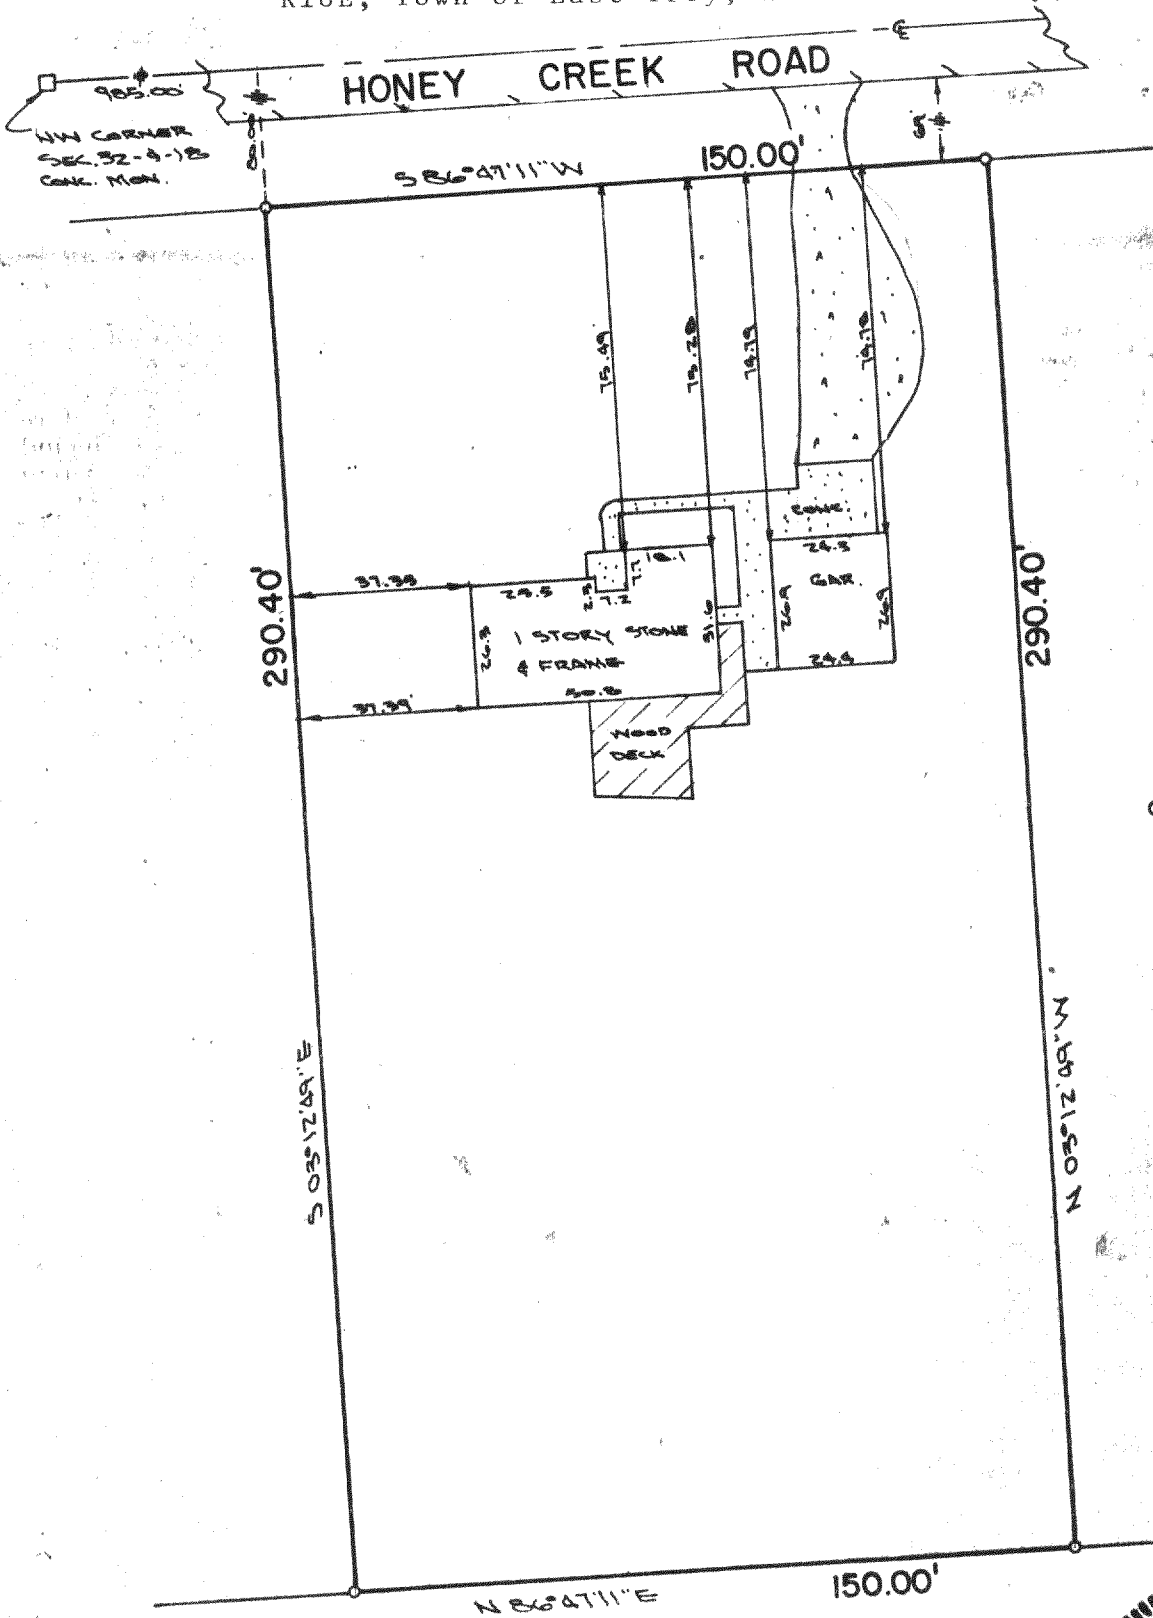

O - DENOTES 1/4" IR. P.D.

MONUMENTATION OF MISSING BOUNDARY CORNERS HAS BEEN WAIVED BY MERRILL LYNCH, AS PER CHAPTER A-E5 OF THE WISCONSIN ADMINISTRATIVE CODE.



CERTIFICATE

STATE OF WISCONSIN) ss
WAUKESHA COUNTY)

I CERTIFY THAT I HAVE SURVEYED THE ABOVE DESCRIBED PROPERTY, AND THE ABOVE MAP IS A TRUE REPRESENTATION THEREOF AND SHOWS THE SIZE AND LOCATION OF THE PROPERTY, ITS EXTERIOR BOUNDARIES, THE LOCATION AND DIMENSIONS OF ALL STRUCTURES THEREON, FENCES, APPARENT EASEMENTS AND ROADWAYS AND VISIBLE ENCROACHMENTS, IF ANY. THIS SURVEY IS MADE FOR THE EXCLUSIVE USE OF THE PRESENT OWNERS OF THE PROPERTY, AND ALSO THOSE WHO PURCHASE, MORTGAGE, OR GUARANTEE THE TITLE THERETO, WITHIN ONE (1) YEAR FROM DATE HEREOF.

Donald C. Chaput Jan 30, 1984
REGISTERED LAND SURVEYOR DATE

The Cornerstone Group, Inc.
PLANNING • ENGINEERING • SURVEYING
1700 E. RACINE AVENUE
WAUKESHA, WI 53186
414-544-1111

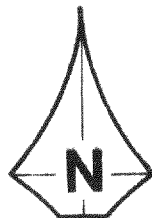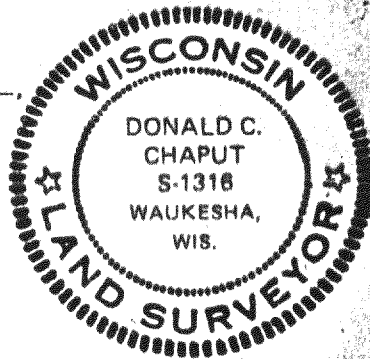

SCALE: 1" = 40'

DRAFTED BY: Dec CHECKED BY: Dec

FIELD BOOK: File

JOB NUMBER: 2312

e 2 m 421

418-444