


RECERTIFICATION

Lot 3 of Certified Survey Map No. 58, being a part of the Northwest 1/4 of Section 9, Township 4 North, Range 18 East, Town of East Troy, Walworth County, Wisconsin, recorded in the office of the Register of Deeds for Walworth County, Wisconsin, on June 2, 1971 in Volume 1 of Certified Survey Maps, page 58, as Document No. 636317. Together with a right of way in common with others as described and shown on Certified Survey Map No. 58.

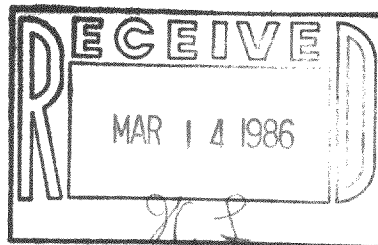

☒ — MONUMENTATION OF MISSING BOUNDARY CORNERS HAS BEEN WAIVED BY PAT & WENDY NELSON AS PER CHAPTER A-53 OF THE WISCONSIN ADMINISTRATIVE CODE.


STATE OF WISCONSIN)
WAUKESHA COUNTY) SS

I CERTIFY THAT I HAVE SURVEYED THE ABOVE DESCRIBED PROPERTY, AND THE ABOVE MAP IS A TRUE REPRESENTATION THEREOF AND SHOWS THE SIZE AND LOCATION OF THE PROPERTY, ITS EXTERIOR BOUNDARIES, THE LOCATION AND DIMENSIONS OF ALL STRUCTURES THEREON, FENCES, APPARENT EASEMENTS AND ROADWAYS AND VISIBLE ENCROACHMENTS, IF ANY.

THIS SURVEY IS MADE FOR THE EXCLUSIVE USE OF THE PRESENT OWNERS OF THE PROPERTY, AND ALSO THOSE WHO PURCHASE, MORTGAGE, OR GUARANTEE THE TITLE THERETO, WITHIN ONE (1) YEAR FROM DATE HEREOF.

REVISÉ 2/14/88

(414) 549-1111

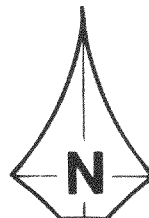

SCALE : 1" = 40'

JOB NUMBER: 2931

418-508