

Surveyed by ~

PO Box 322

45 S. WISCONSIN ST.

PHONE (414) 723-3434



53121

Surveyed for -

MIKE BRENNEN
WILLIAMS BAY, WISC.

RESURVEYED FORM KEEFE REAL EST

Box 268 W.H. & W.S. 53184

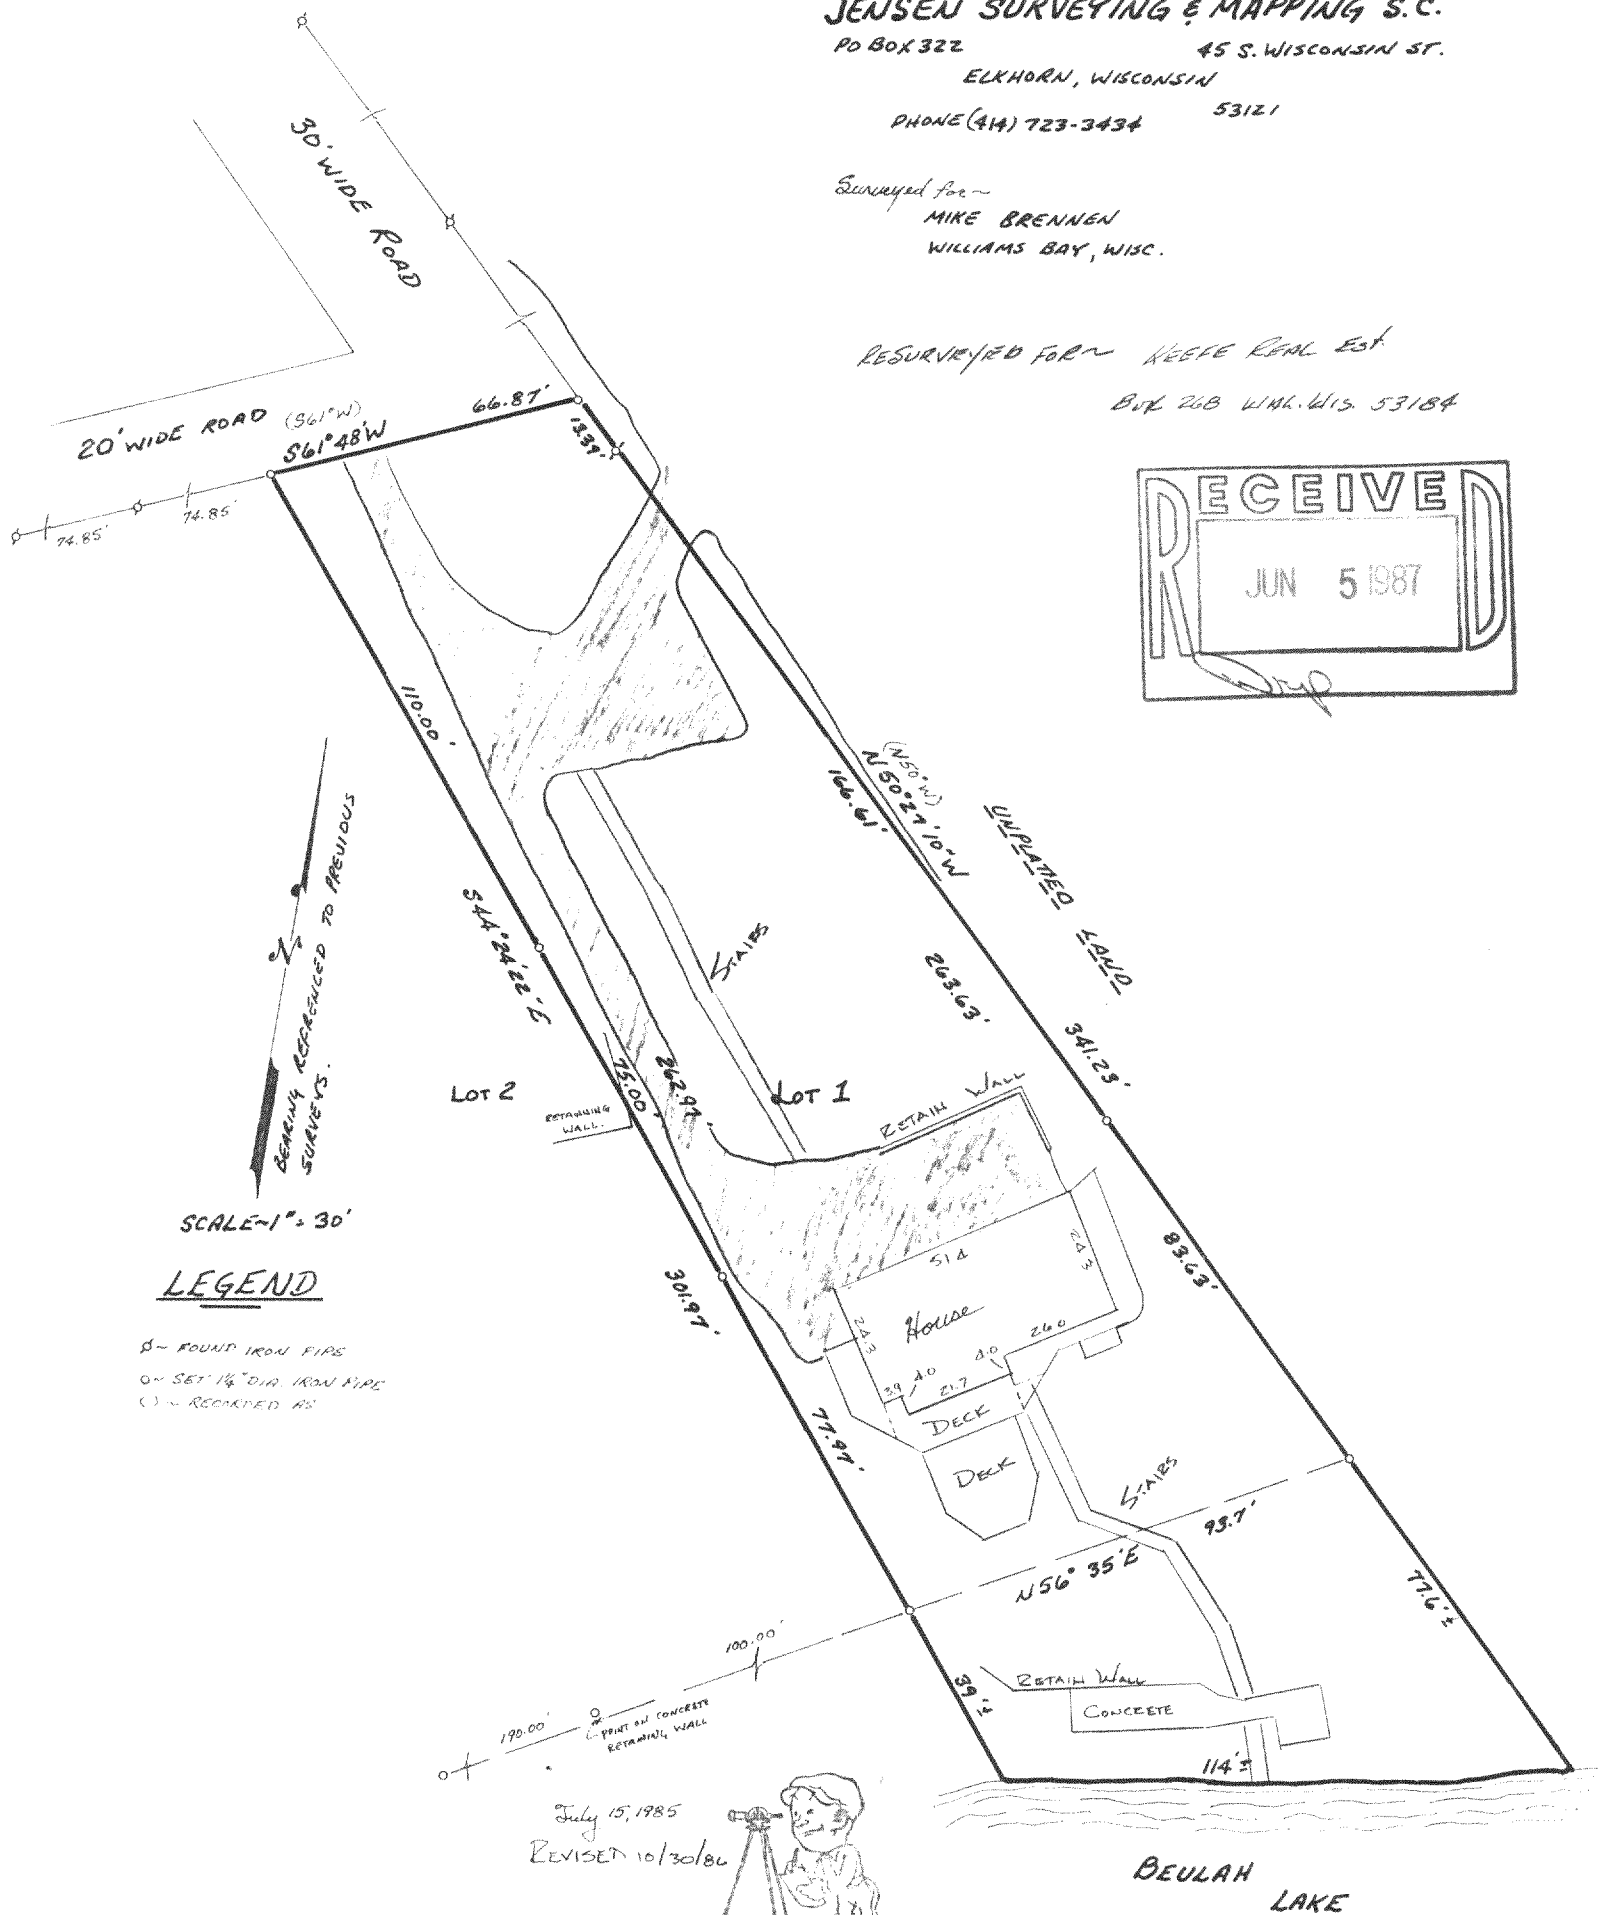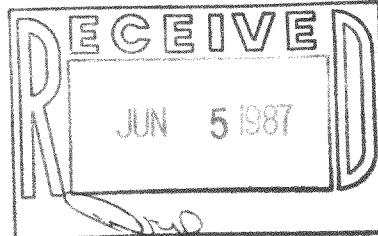

BEULAH
LAKE

I, THOMAS P.A. JENSEN, WIS. REGISTERED LAND SURVEYOR, DO HEREBY CERTIFY THAT THIS SURVEY WAS PERFORMED BY ME, OR UNDER MY DIRECTION, IN FULL COMPLIANCE WITH THE OWNER'S/AGENT'S INSTRUCTIONS AND CHAPTER A-55 OF WIS. ADMIN. CODE "MINIMUM STANDARDS FOR PROPERTY SURVEYS"; AND THAT THIS MAP IS AN ACCURATE REPRESENTATION TO THE BEST OF MY KNOWLEDGE AND BELIEF.

THOMAS P. A. JENSEN S-1084

418-570

100

92-1