

PLAT OF SURVEY
OF

LOT 2, DUTCHLAND ACRES, LOCATED IN THE SOUTHEAST 1/4 OF THE NORTHEAST 1/4 OF SECTION 21,
T. 4 N., R. 18 E. OF THE 4TH P.M., TOWNSHIP OF EAST TROY, WALWORTH COUNTY, WISCONSIN.


FOR: RUTH DUSSAULT

SCALE 1" = 60'

o = IRON PIPE STAKE SET.

o = IRON PIPE STAKE FOUND.

BEARING DATUM IS THAT OF RECORDED PLAT.

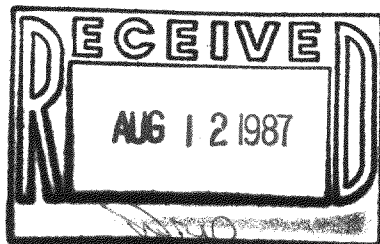


I have surveyed the above-described property, and the map hereon is a true representation thereof and shows the size and location of the property, its exterior boundaries, the location and dimensions of all visible structures thereon, fences, apparent easements and roadways and visible encroachments, if any.

This survey is made for the exclusive use of the present owners of the property, and also those who purchase, mortgage, or guarantee the title thereto, within one year from date hereof.

Dated at Burlington, this 6th day of AUGUST 1987

John F. Degen
John F. Degen, Land Surveyor S 242

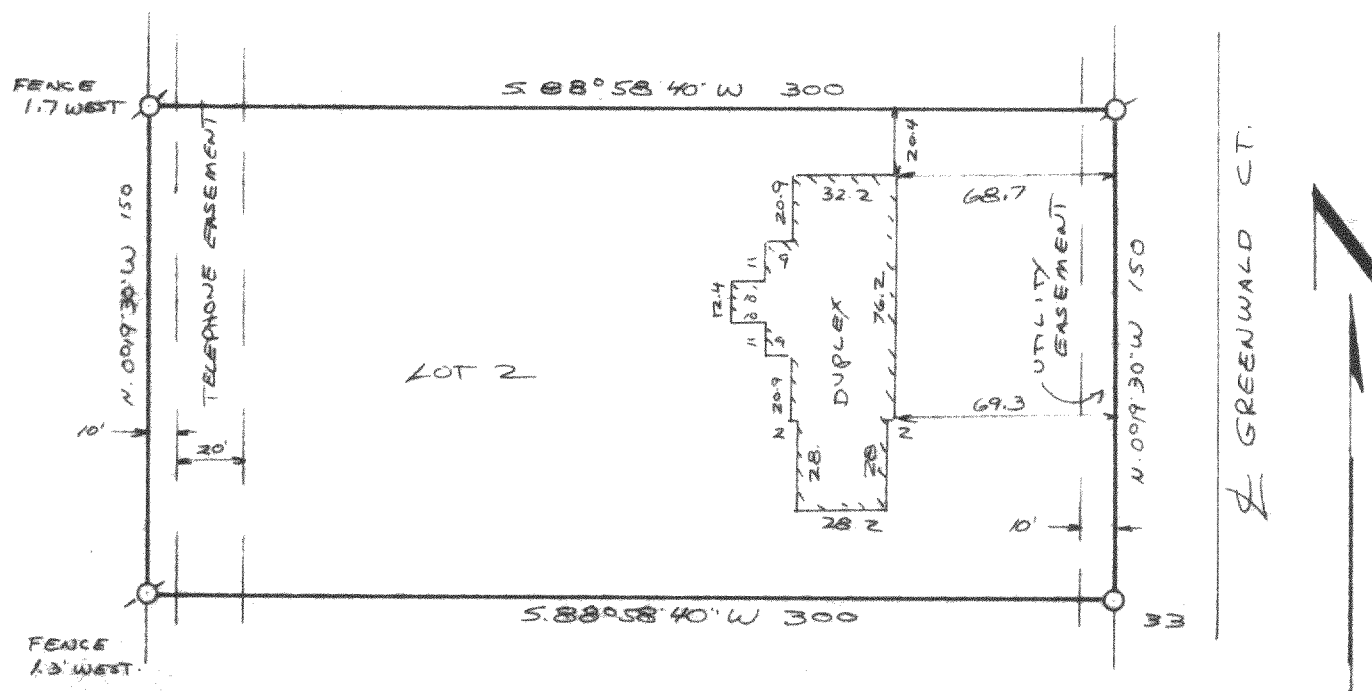

418-571

11-C-4 #37