



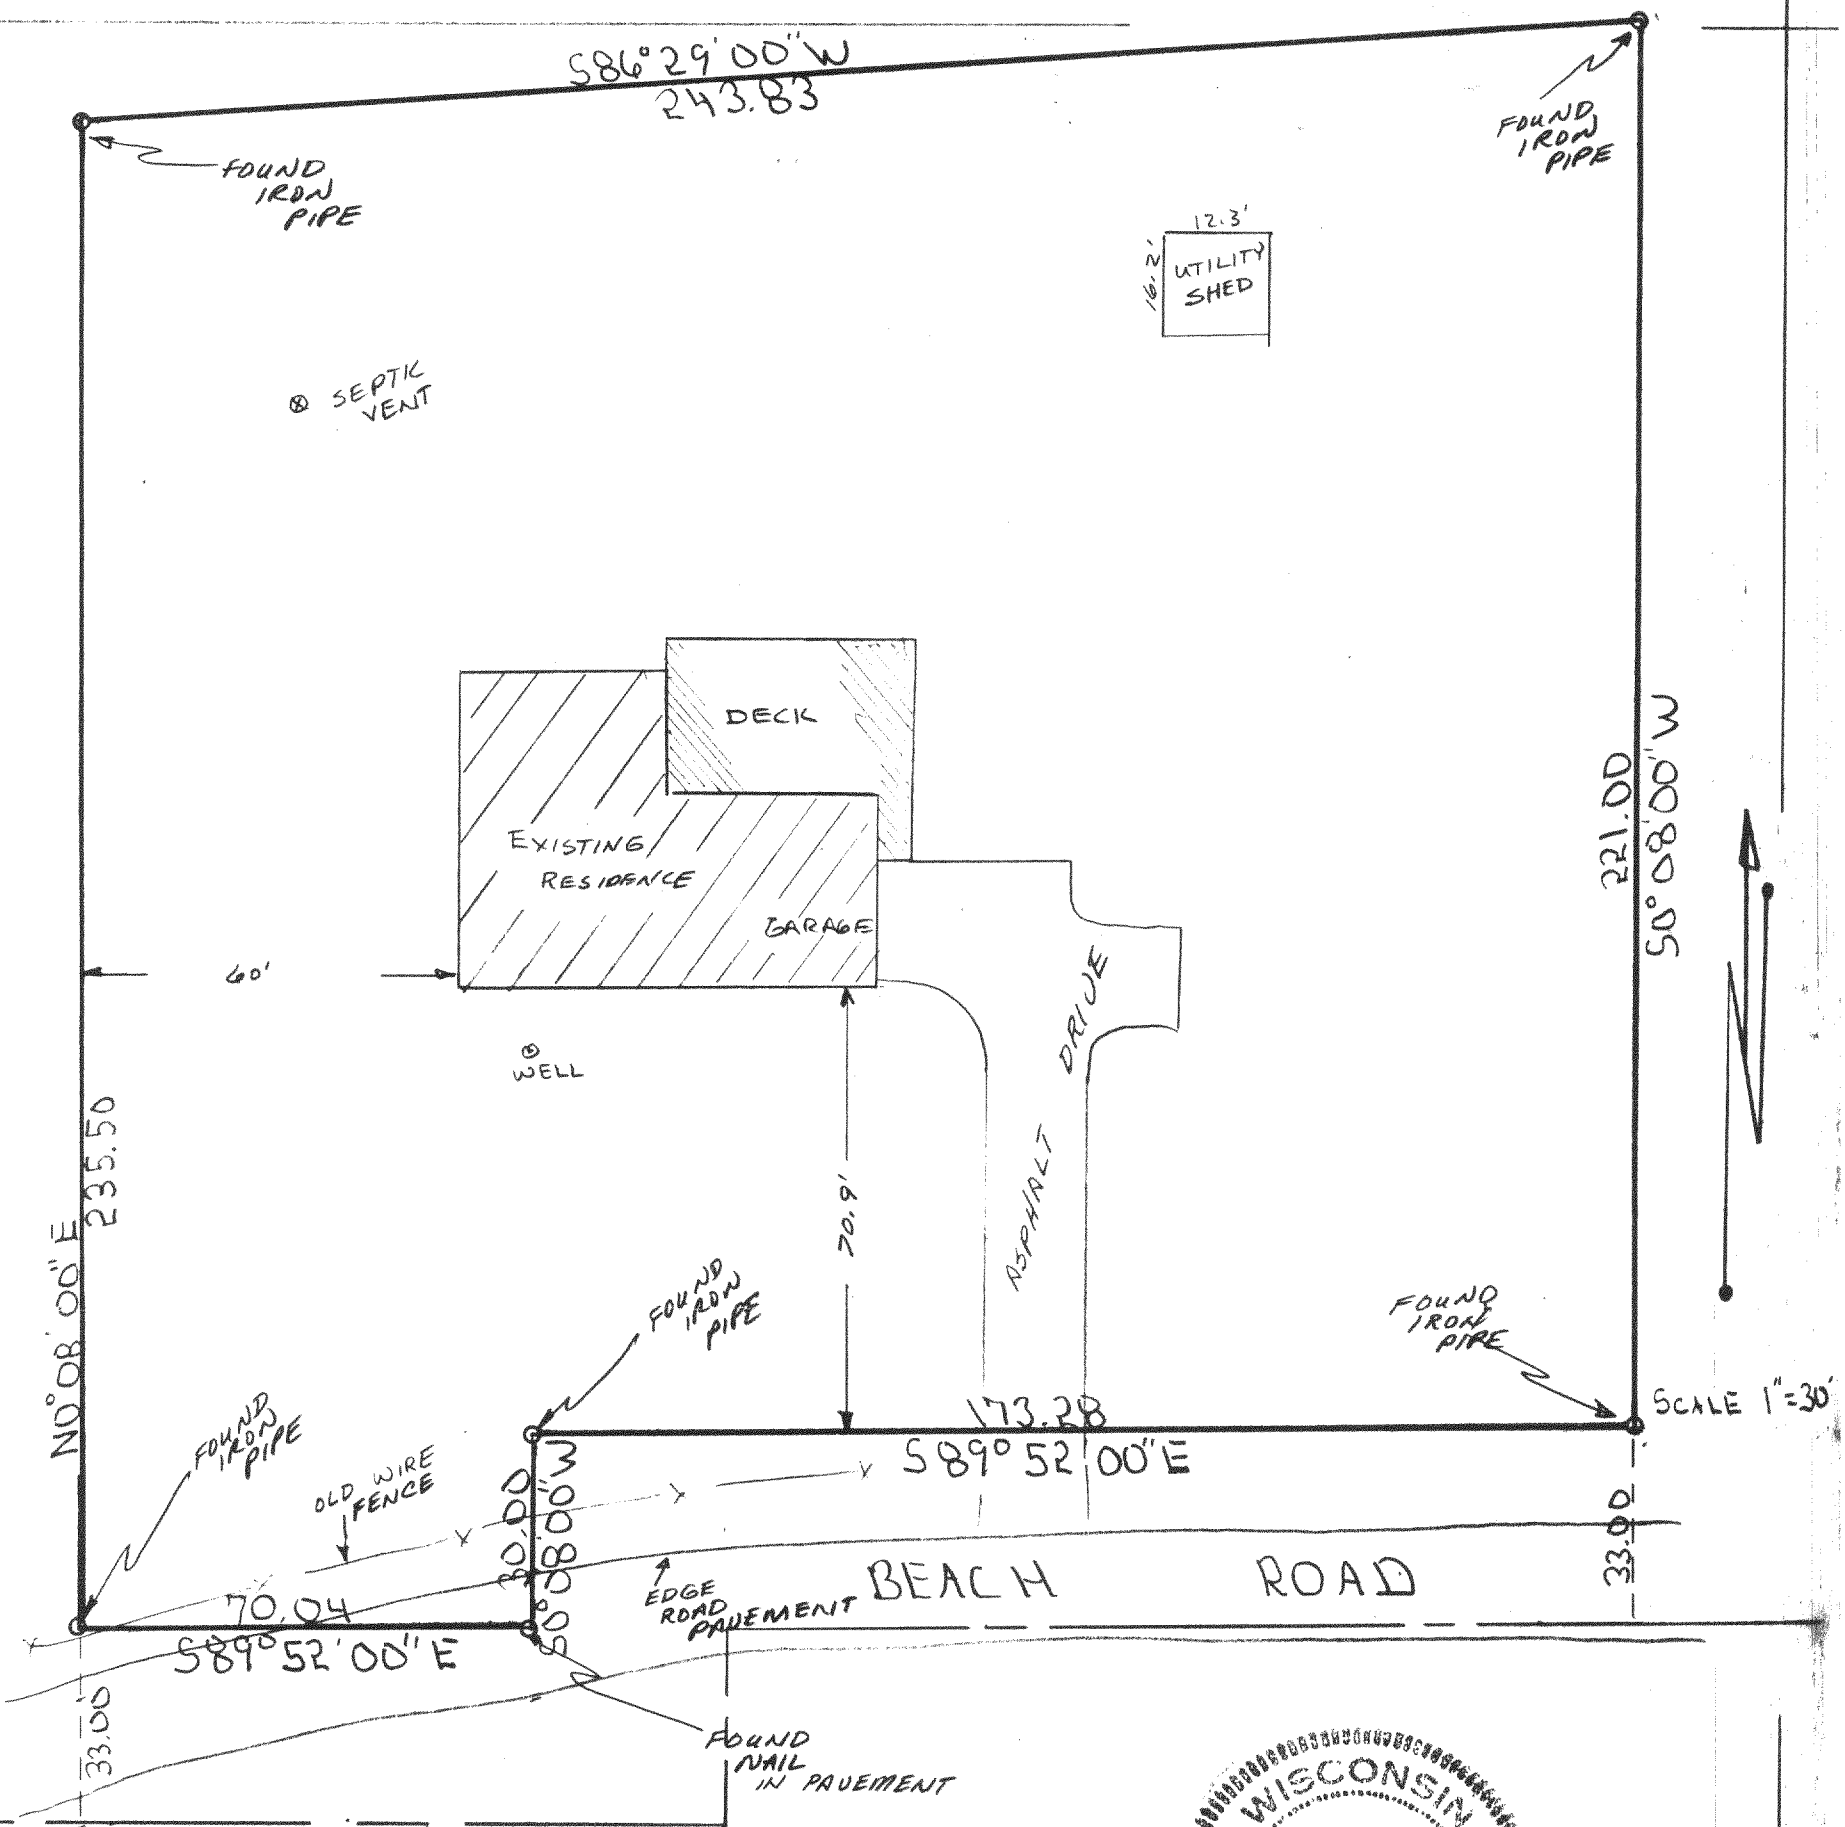


Plat of Survey of Lot 1 OF Certified Survey Map No. 967
Located in the Town of East Troy Walworth County WI

Survey ordered by St. Francis Savings & Loan
Milwaukee WI

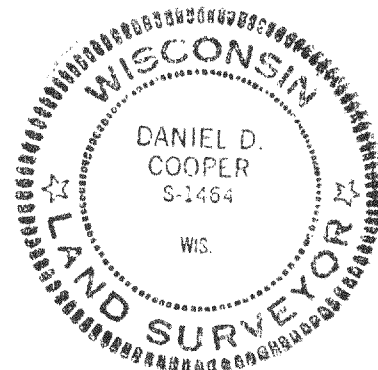

I, Daniel D. Cooper, Registered Land Surveyor do hereby certify that
I have surveyed the property described hereon and that the map shown
hereon is a true and accurate representation thereof to the best of my
professional knowledge and belief.

Dated this 17TH day of Nov., 1986

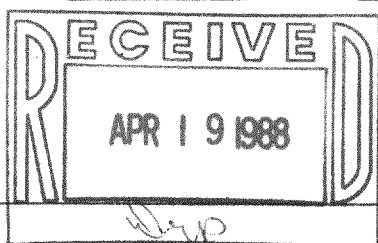

Daniel D. Cooper
Daniel D. Cooper, RLS NO. S-1464

D. D. COOPER & CO., INC.
Daniel D. Cooper
Rt. 4 Box 508B
Elkhorn, WI 53121

DRAWING NO. 2198-S

418-605