


**D. Cooper & CO., INC**

Rt 4 Box 508B \* Elkhorn WI 53121

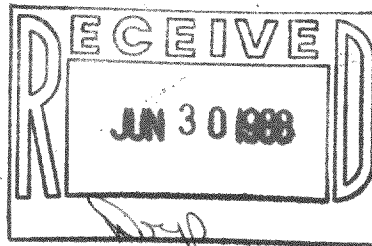


Plat of Survey of Lots 3 and 4, Block 2, Frasers and Hunters Addition,  
being located in Section 12, Town 4 North, Range 18 East Walworth  
County, Wisconsin.

Survey ordered by Main Street Realty  
East Troy

Bearing reference: Centerline of Highway  
"24" assumed to bear  
N 40 00'E as recorded

FOUND IRON  
FOUND IRON  
S.T.H. "24"

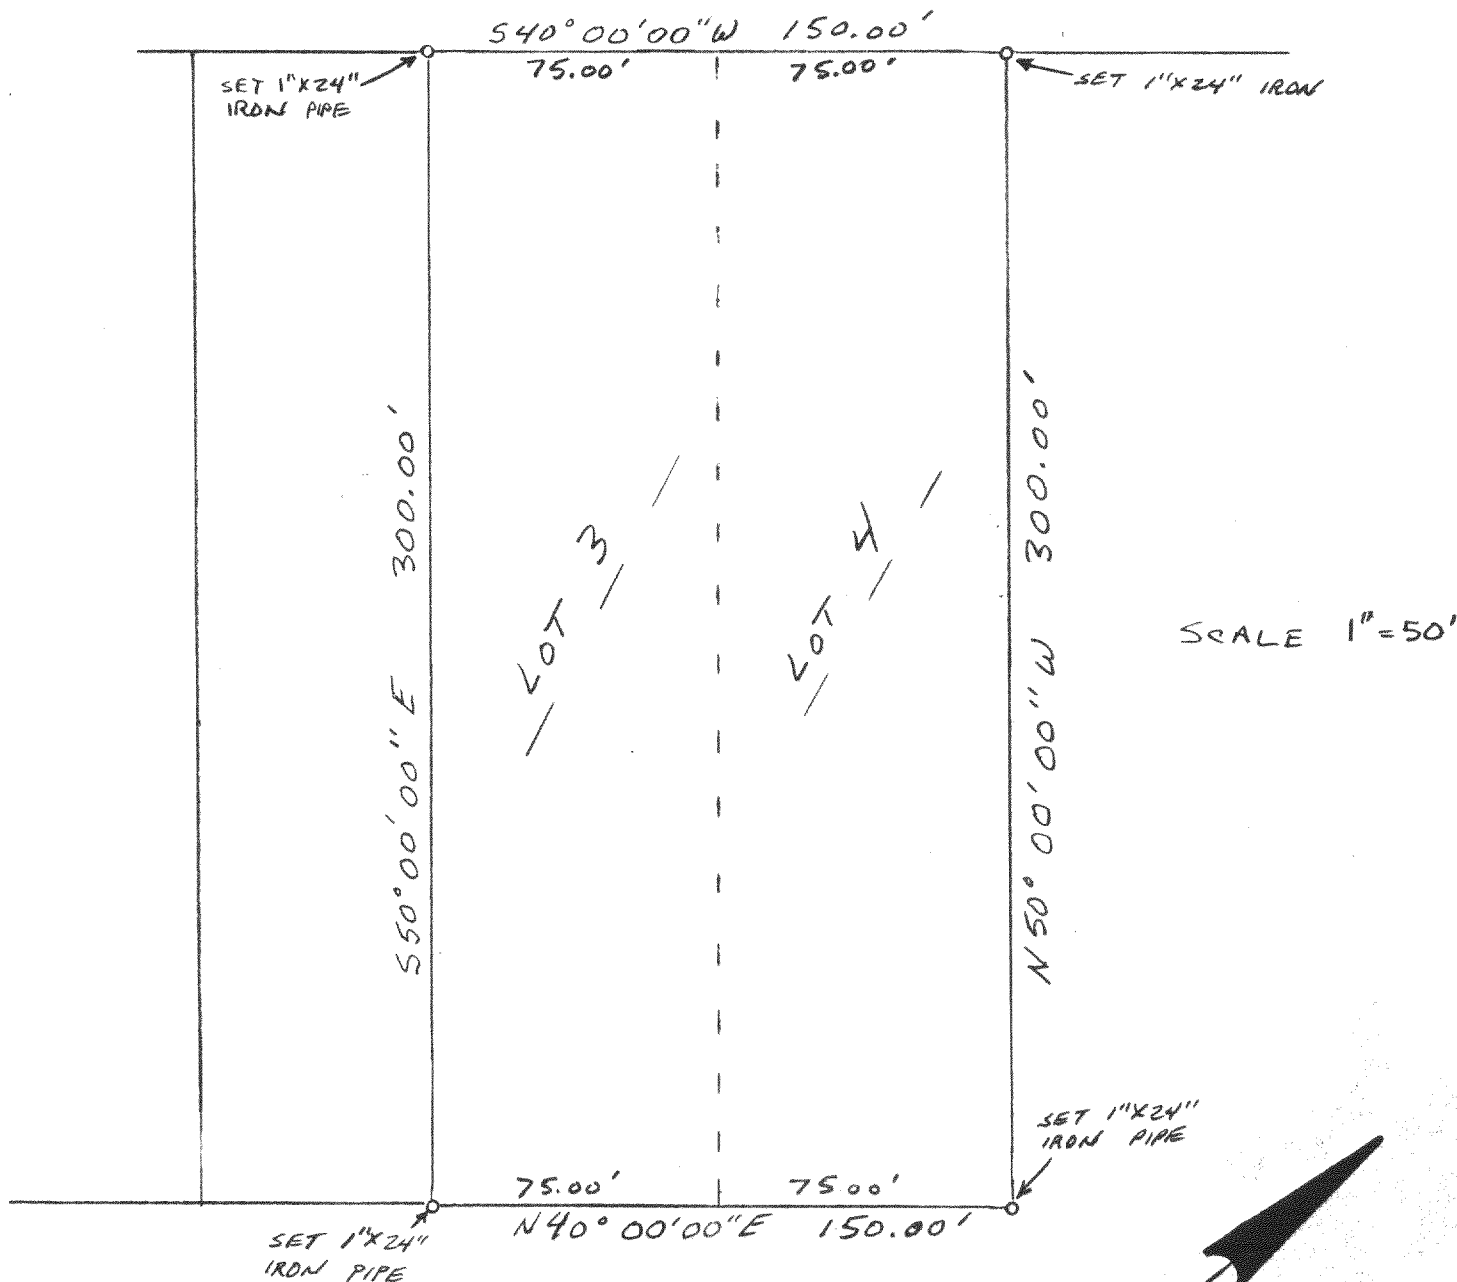



I hereby certify that I have surveyed the  
property described hereon and that the  
map shown hereon is a true and accurate  
representation thereof to the best of my  
professional knowledge and belief.

Dated this 25 day of April, 1988

*Daniel D. Cooper*

Daniel D. Cooper, RLS No. S-1464

PLBSA-7

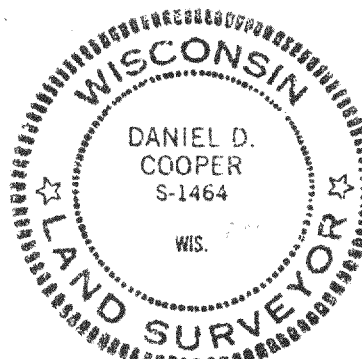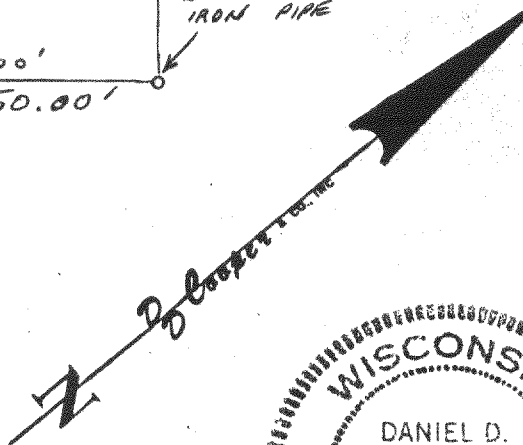

DRAWING NO. 3237