

Jensen Surveying & Mapping S.C.
45 S. Wisconsin St. P.O. Box 322
Elkhorn, Wisconsin 53121
(414) 723-3434

SURVEY of Section 17, Town 4 North, Range 18 East,
Town of East Troy, Walworth County, Wisconsin

SURVEYED FOR: Lloyd L. Jensen
Walworth County Surveyor


Mapping Date: April 10, 1989

Field work done: March 31, 1989
April 3, 1989

Revised: May 12, 1989

SCALE: 1" = 600'

Bearings
referenced
to the
Wisconsin
State Plane
Coordinate
System,
South Zone

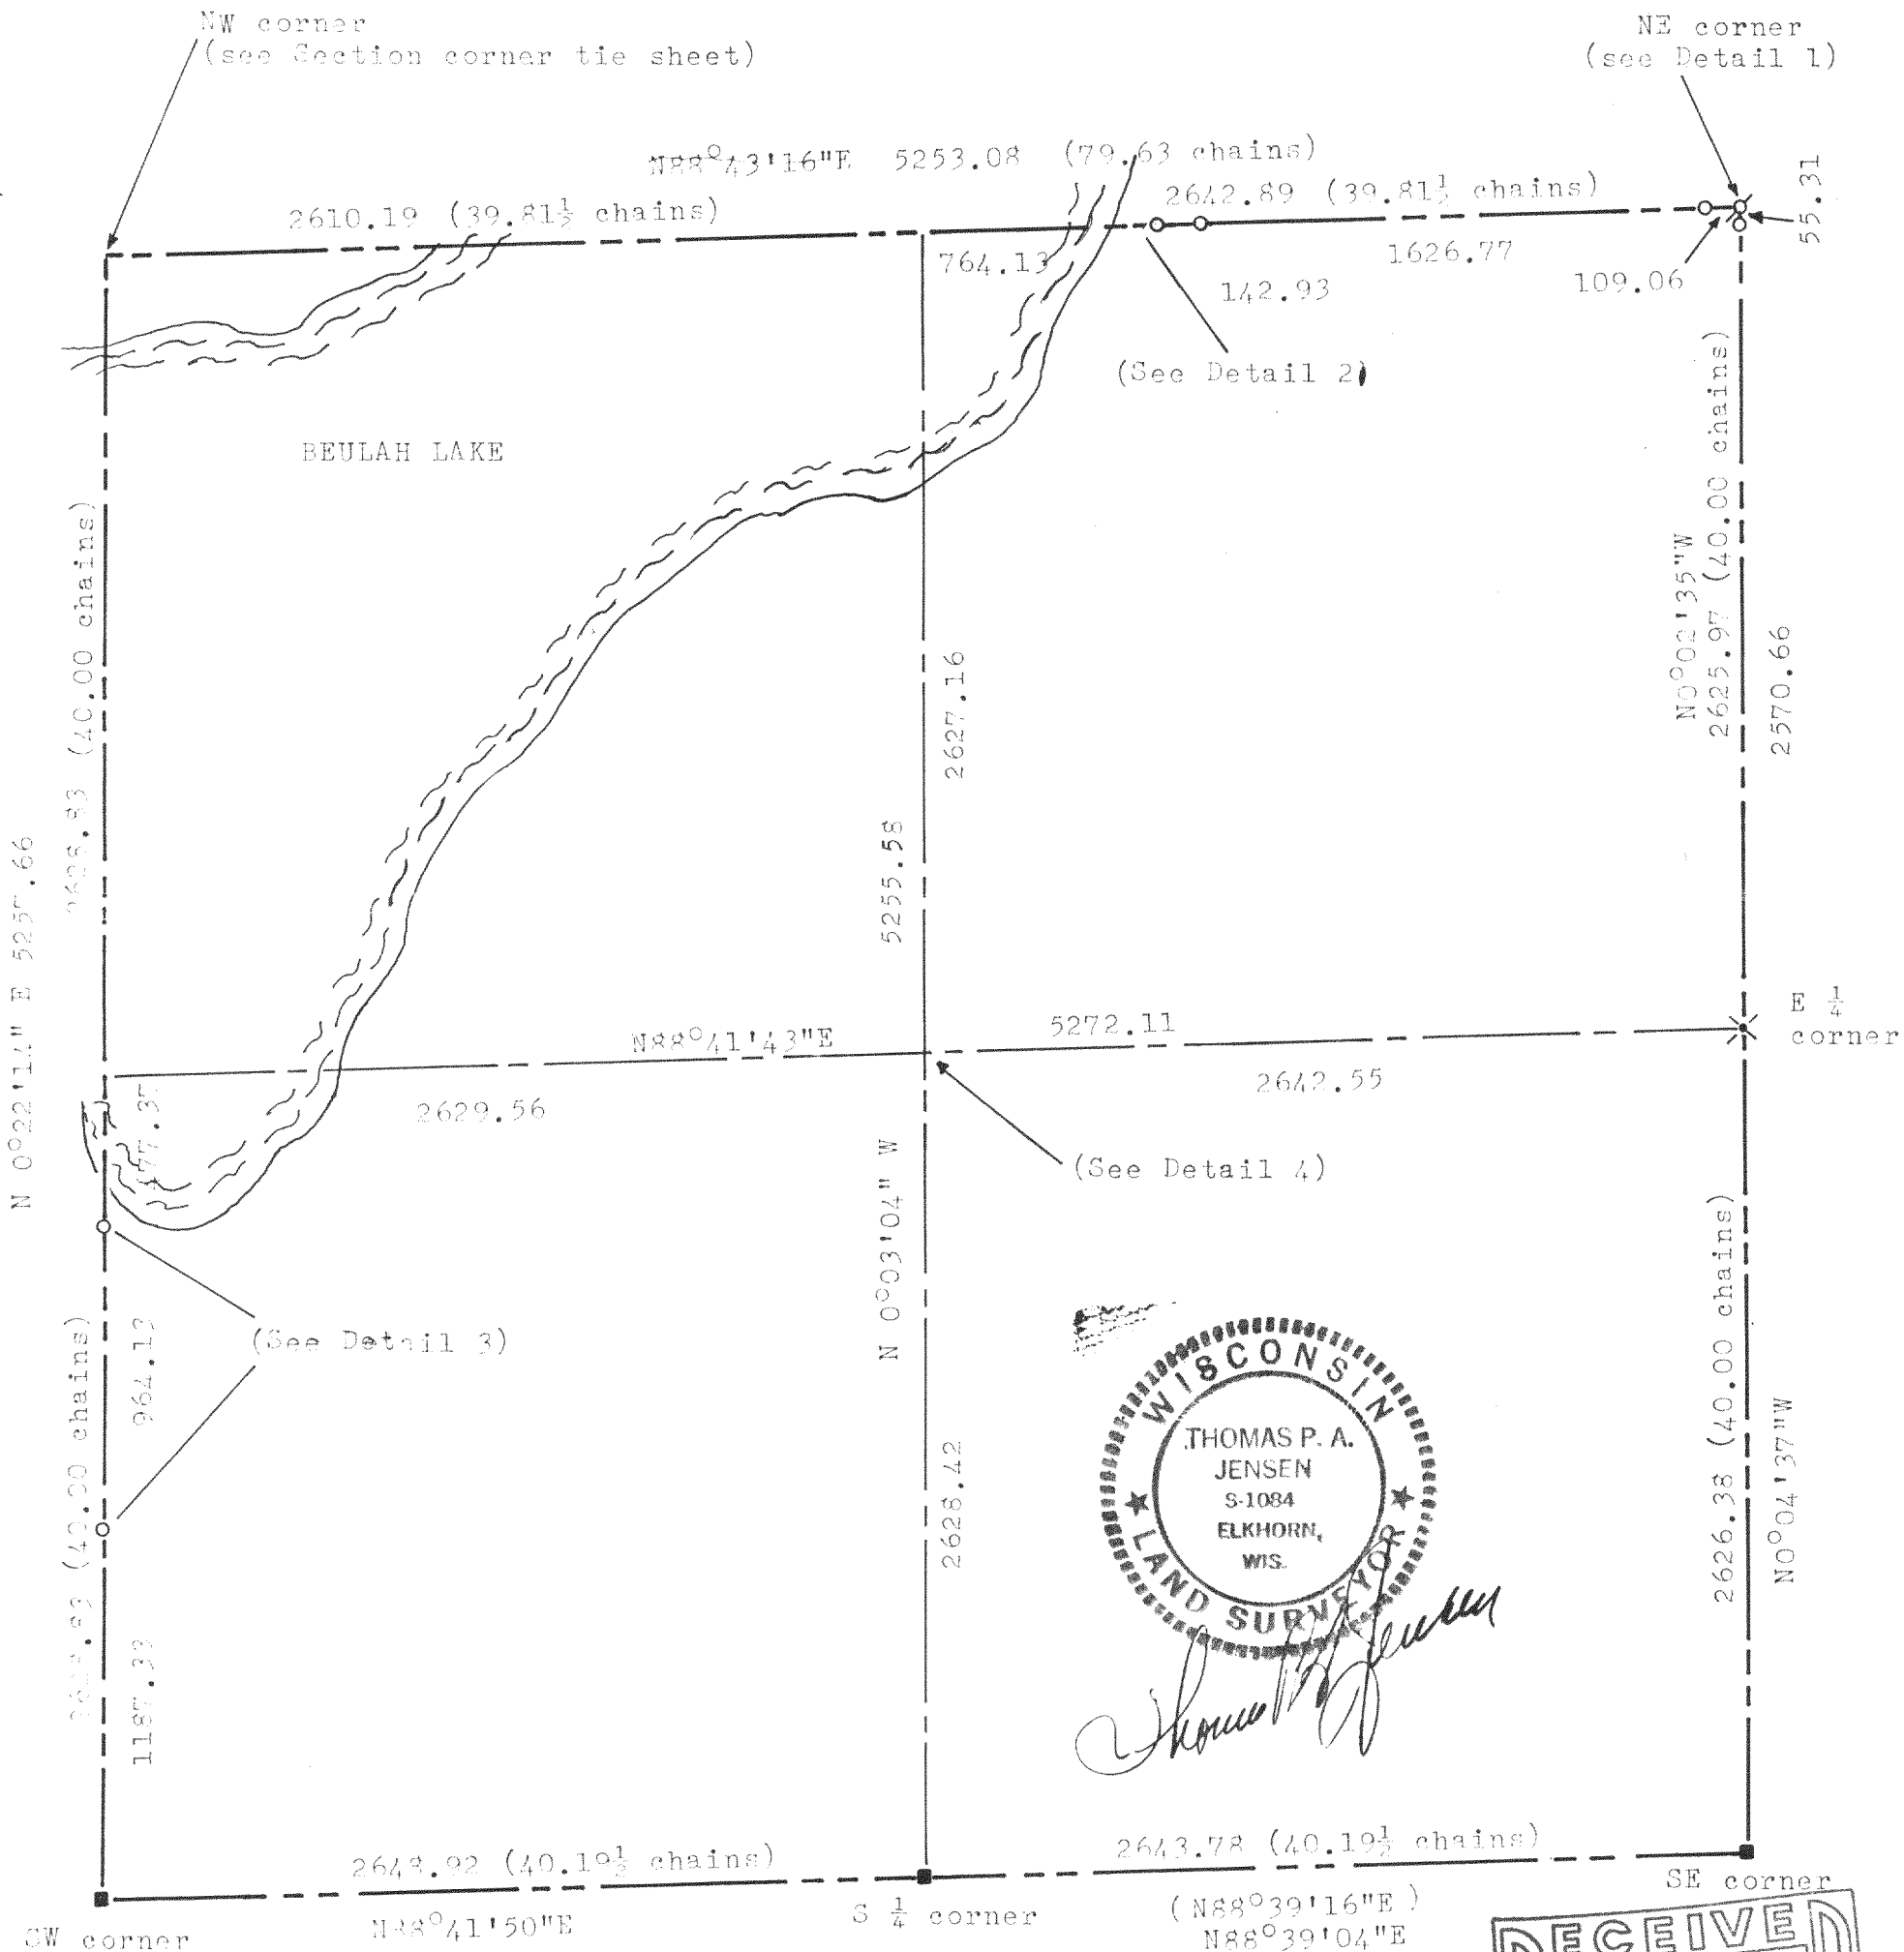

LEGEND

- Found County Section Corner Monument
- Proposed County Monument
- () Recorded dimension
- ⊕ Found iron pipe
- ✕ Spike or P-K nail