

PLAT OF SURVEY


LOTS 8 AND 9 OF BLOCK 10 OF MIRAMAR SUBDIVISION,
LOCATED IN THE NORTHEAST 1/4 OF SECTION 10, TOWN 4
NORTH, RANGE 18 EAST, WALWORTH COUNTY, WISCONSIN.

ORDERED BY: SCHAUDER BUILDERS
RT. 2 BOX 28-A
LAKE GENEVA, WI. 53147

OWNERS: MIKE AND BRIDGET CLARK
11094 W. FOREST HOME #6
HALES CORNERS, WI. 53130


MIRAMAR ADDITION NO. 1

BEARING BASIS FOR THIS PLAT ASSUMED TO BE AS SHOWN AS PLATTED ON MIRAMAR ADDITION NO. 1

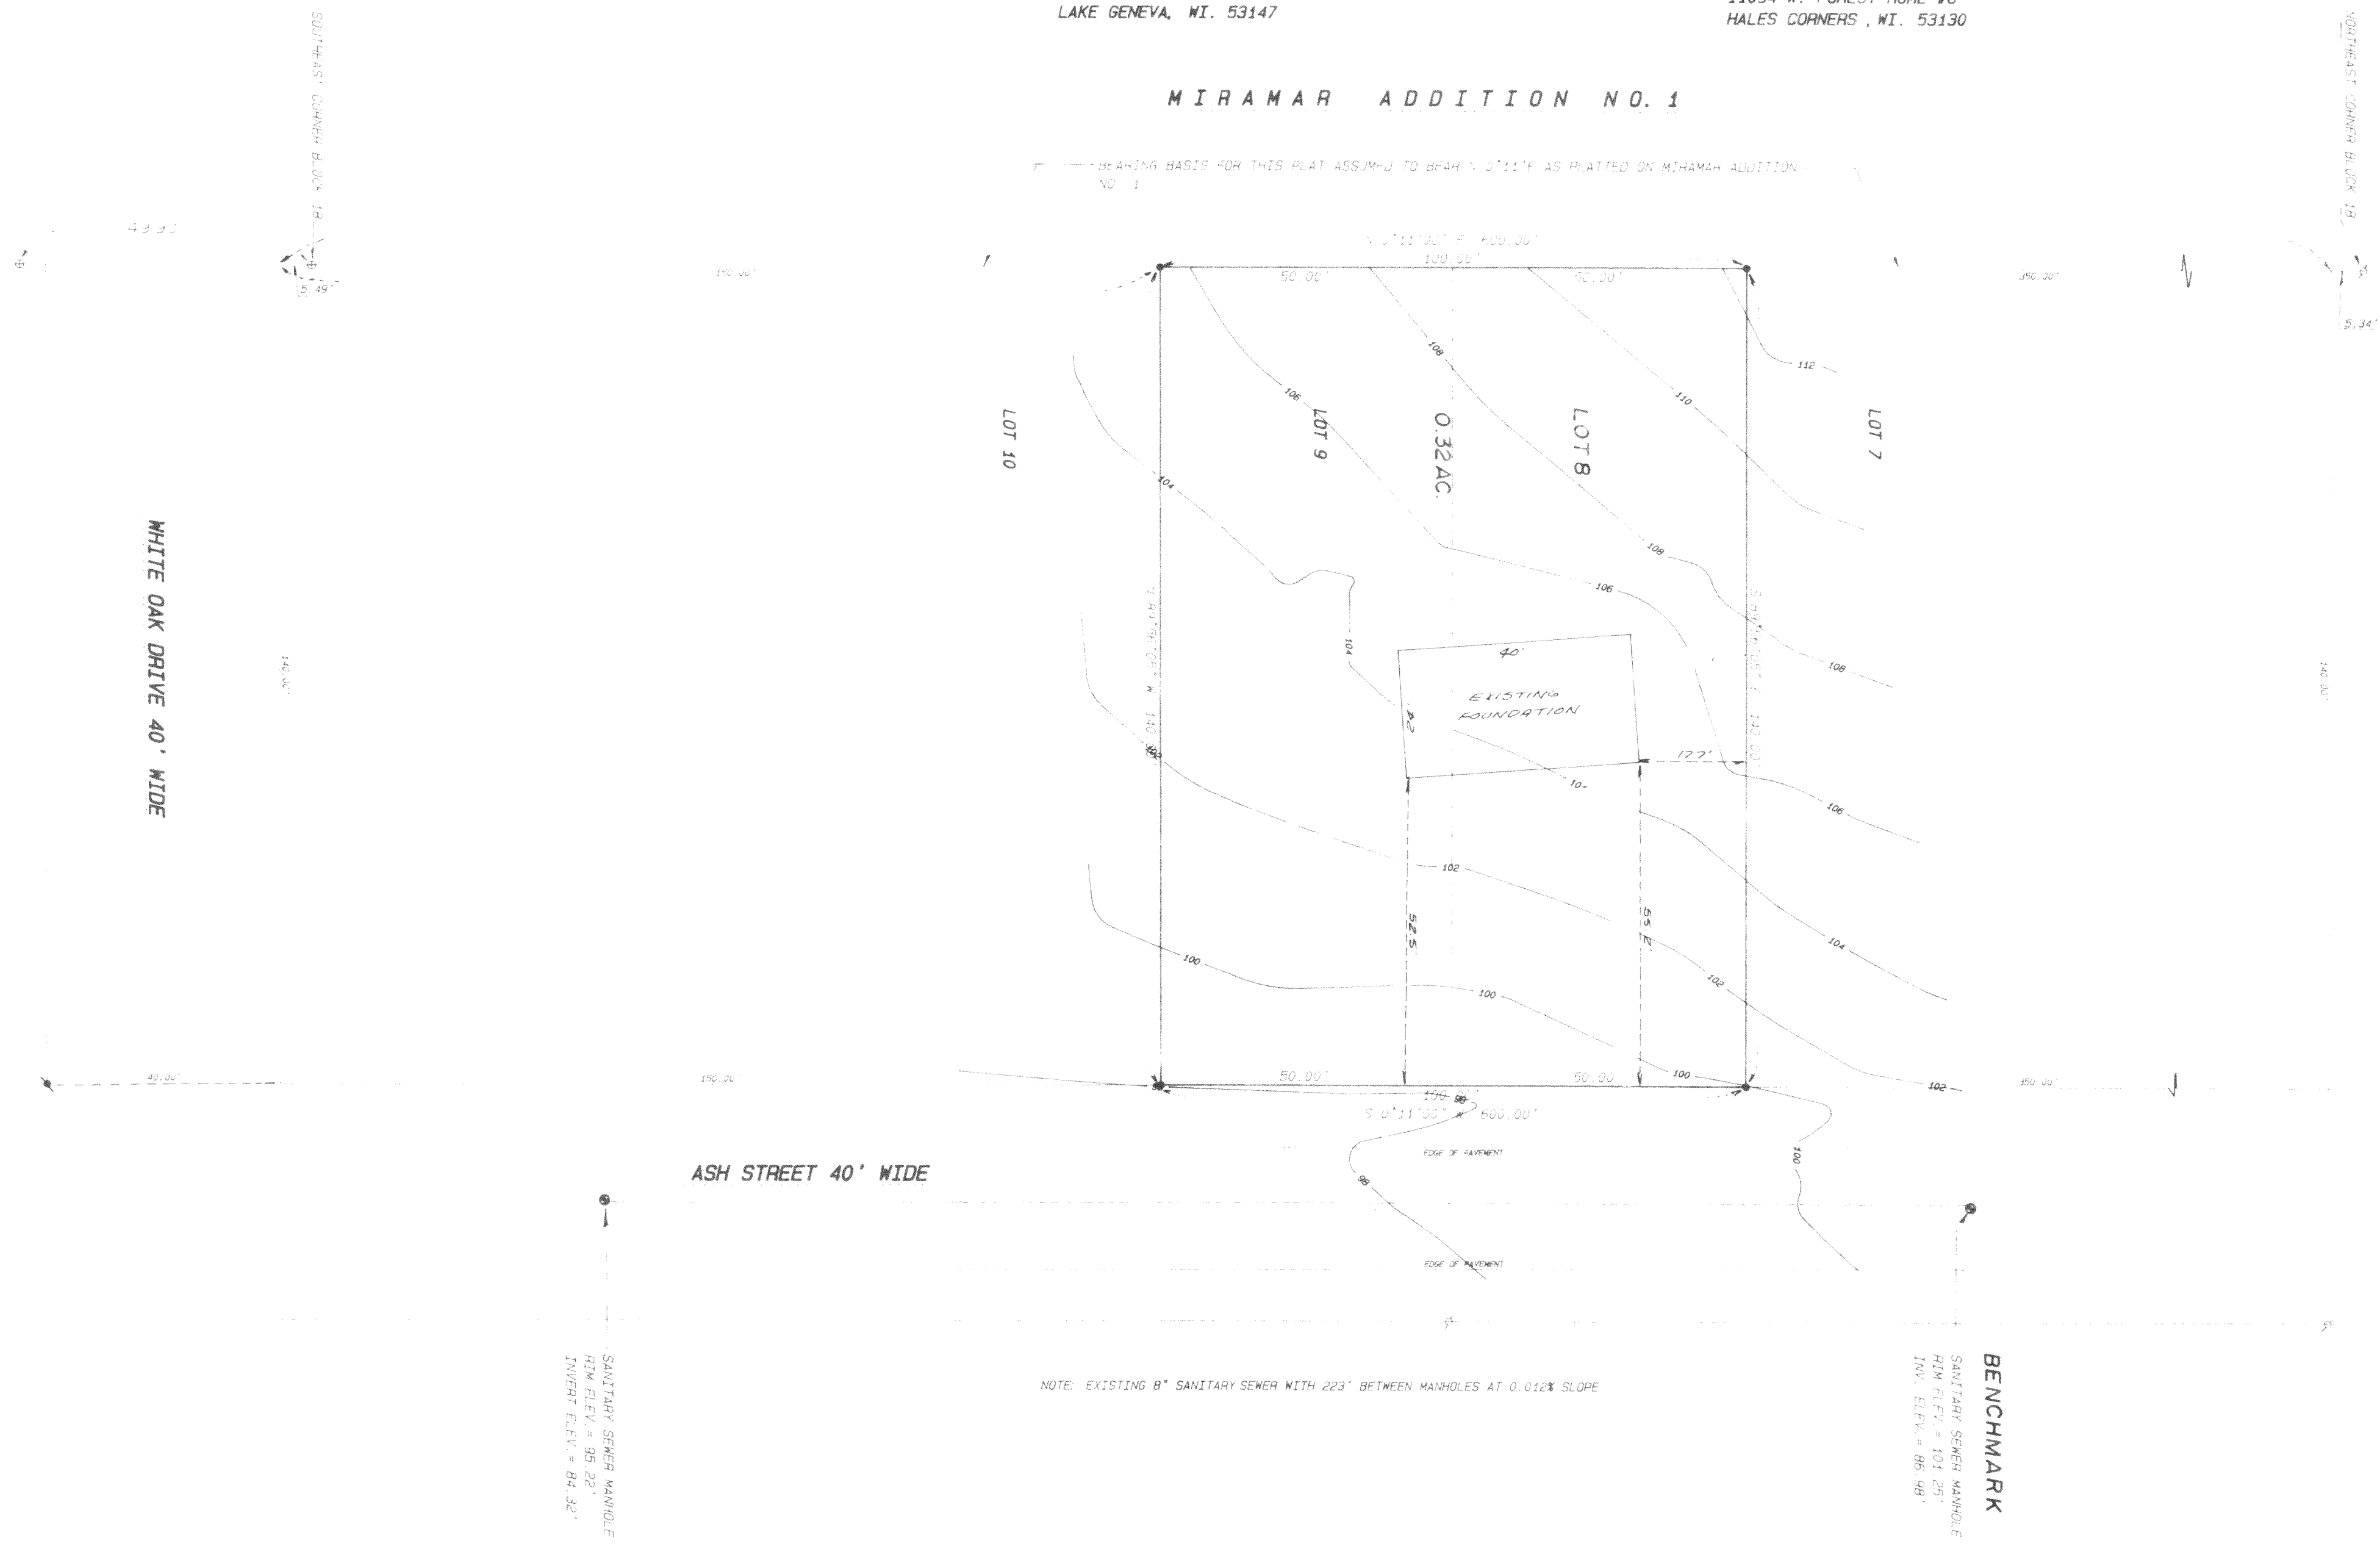

- Legend
- FOUND IRON PIPE
 - FOUND IRON ROD
 - FOUND BRASS CAPPED MONUMENT
 - FOUND CONCRETE MONUMENT
 - CHISEL CUT IN CONCRETE
 - SET IRON ROD, 24" LONG, WEIGHING 1.5 LBS. LINEAL FT., 3/4" DIA.
 - SET IRON ROD, 30" LONG, WEIGHING 4.5 LBS. LINEAL FT., 1-11/16" DIA.
 - RECORDED AS DIMENSION
 - EXISTING FENCE

RECEIVED
APR 9 1991
dg
SCALE: 1" = 20 FEET

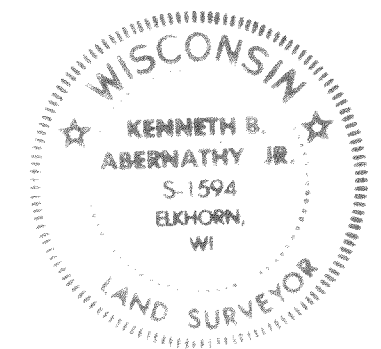

I hereby certify that I have surveyed the above described property and that the above map is a true representation thereof and shows the size and location of the property, its exterior boundaries, the location of all visible structures and dimensions of all principal buildings thereon, boundary fences, apparent easements, roadways and visible encroachments, if any.

This survey is made for the use of the present owners of the property, and also those who purchase, mortgage, or guarantee the title thereto within one year from date hereof.

Kenneth B. Abernathy Jr.
KENNETH B. ABERNATHY, JR.
WISCONSIN REGISTERED LAND SURVEYOR, S-1594
Date: 7/27/90 Job No. 70-907
REVISOR: 11/13/90 CONCRETE FOUNDATION