


N

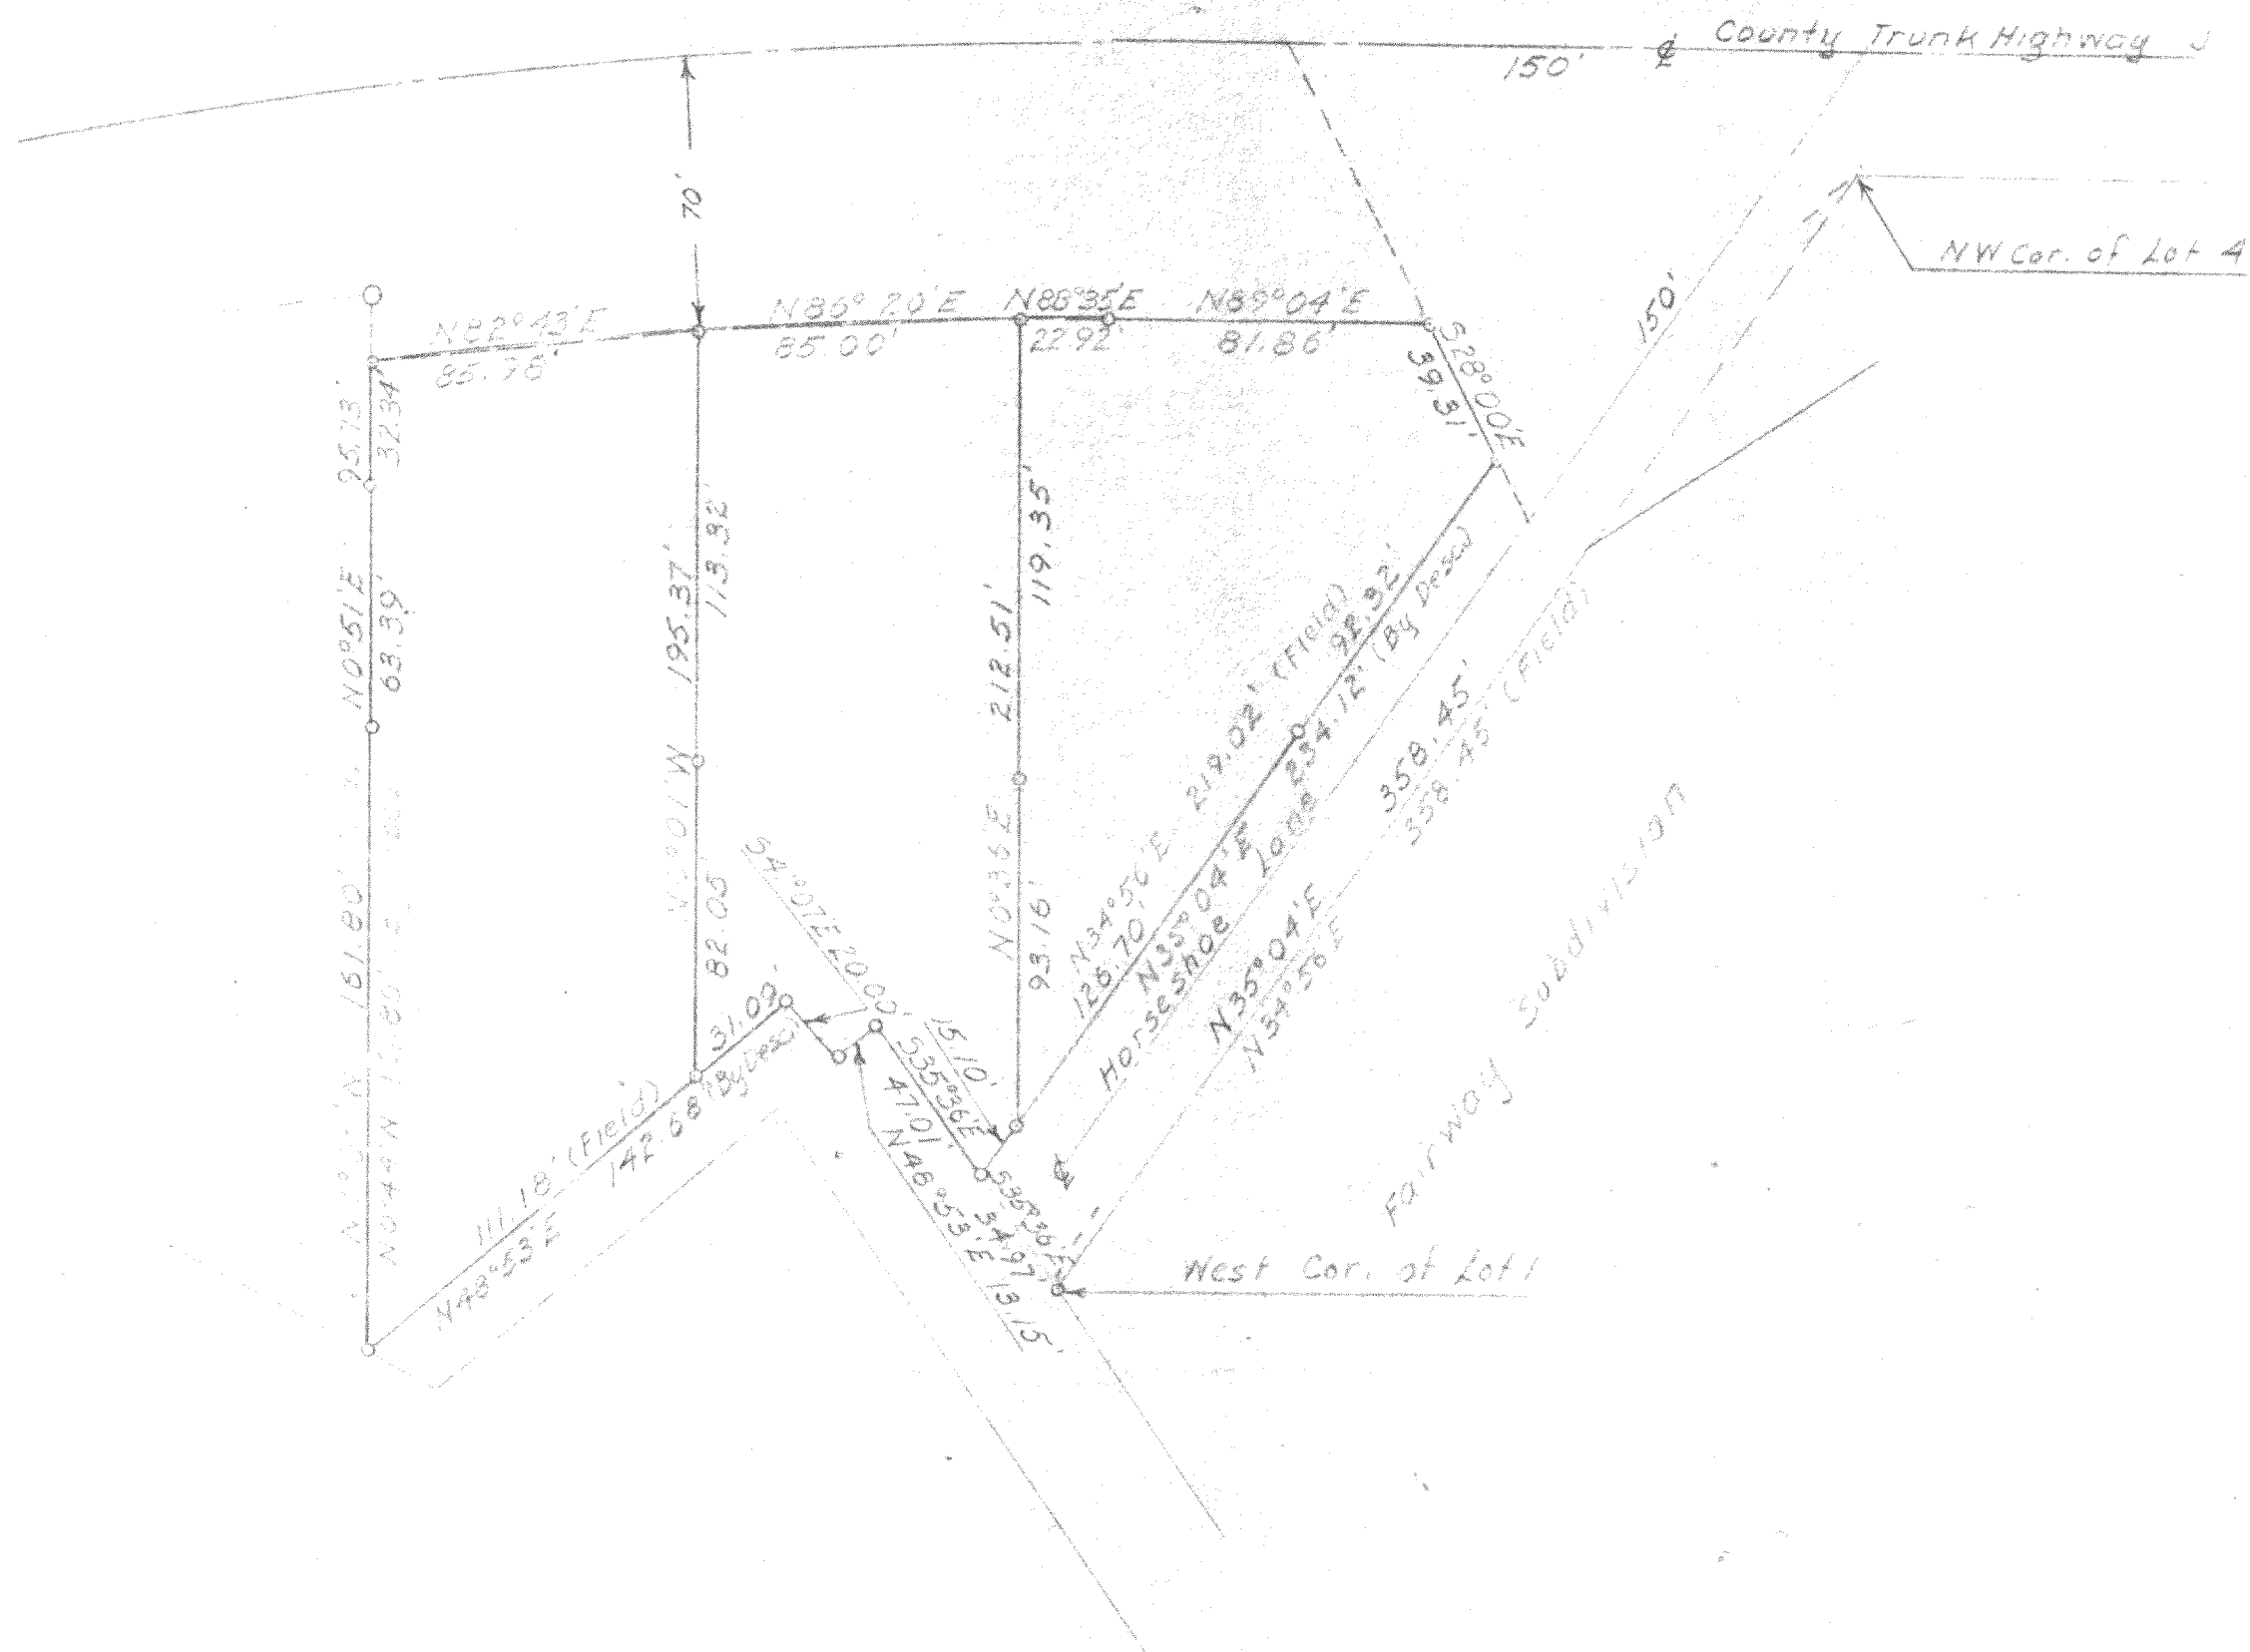

# PLAT OF SURVEY OF

Parcel of land located in the NW 1/4 of  
Section 4, T4N, R18E, Walworth  
County, Wisconsin.

*David L. Smith*  
SURVEYOR

SCALE 1" = 50'

DATE November 12

418-99J

15-A4 RVD  
" A5 "  
" A6 "