


PLAT OF SURVEY

DESCRIPTION:
ALL THAT PART OF LOT 8 AND THE EASTERLY
35 FEET OF LOT 9 IN LAKE BEULAH COUNTRY
PARK SUBDIVISION, TOWN OF EAST TROY,
WALWORTH COUNTY, WISCONSIN.

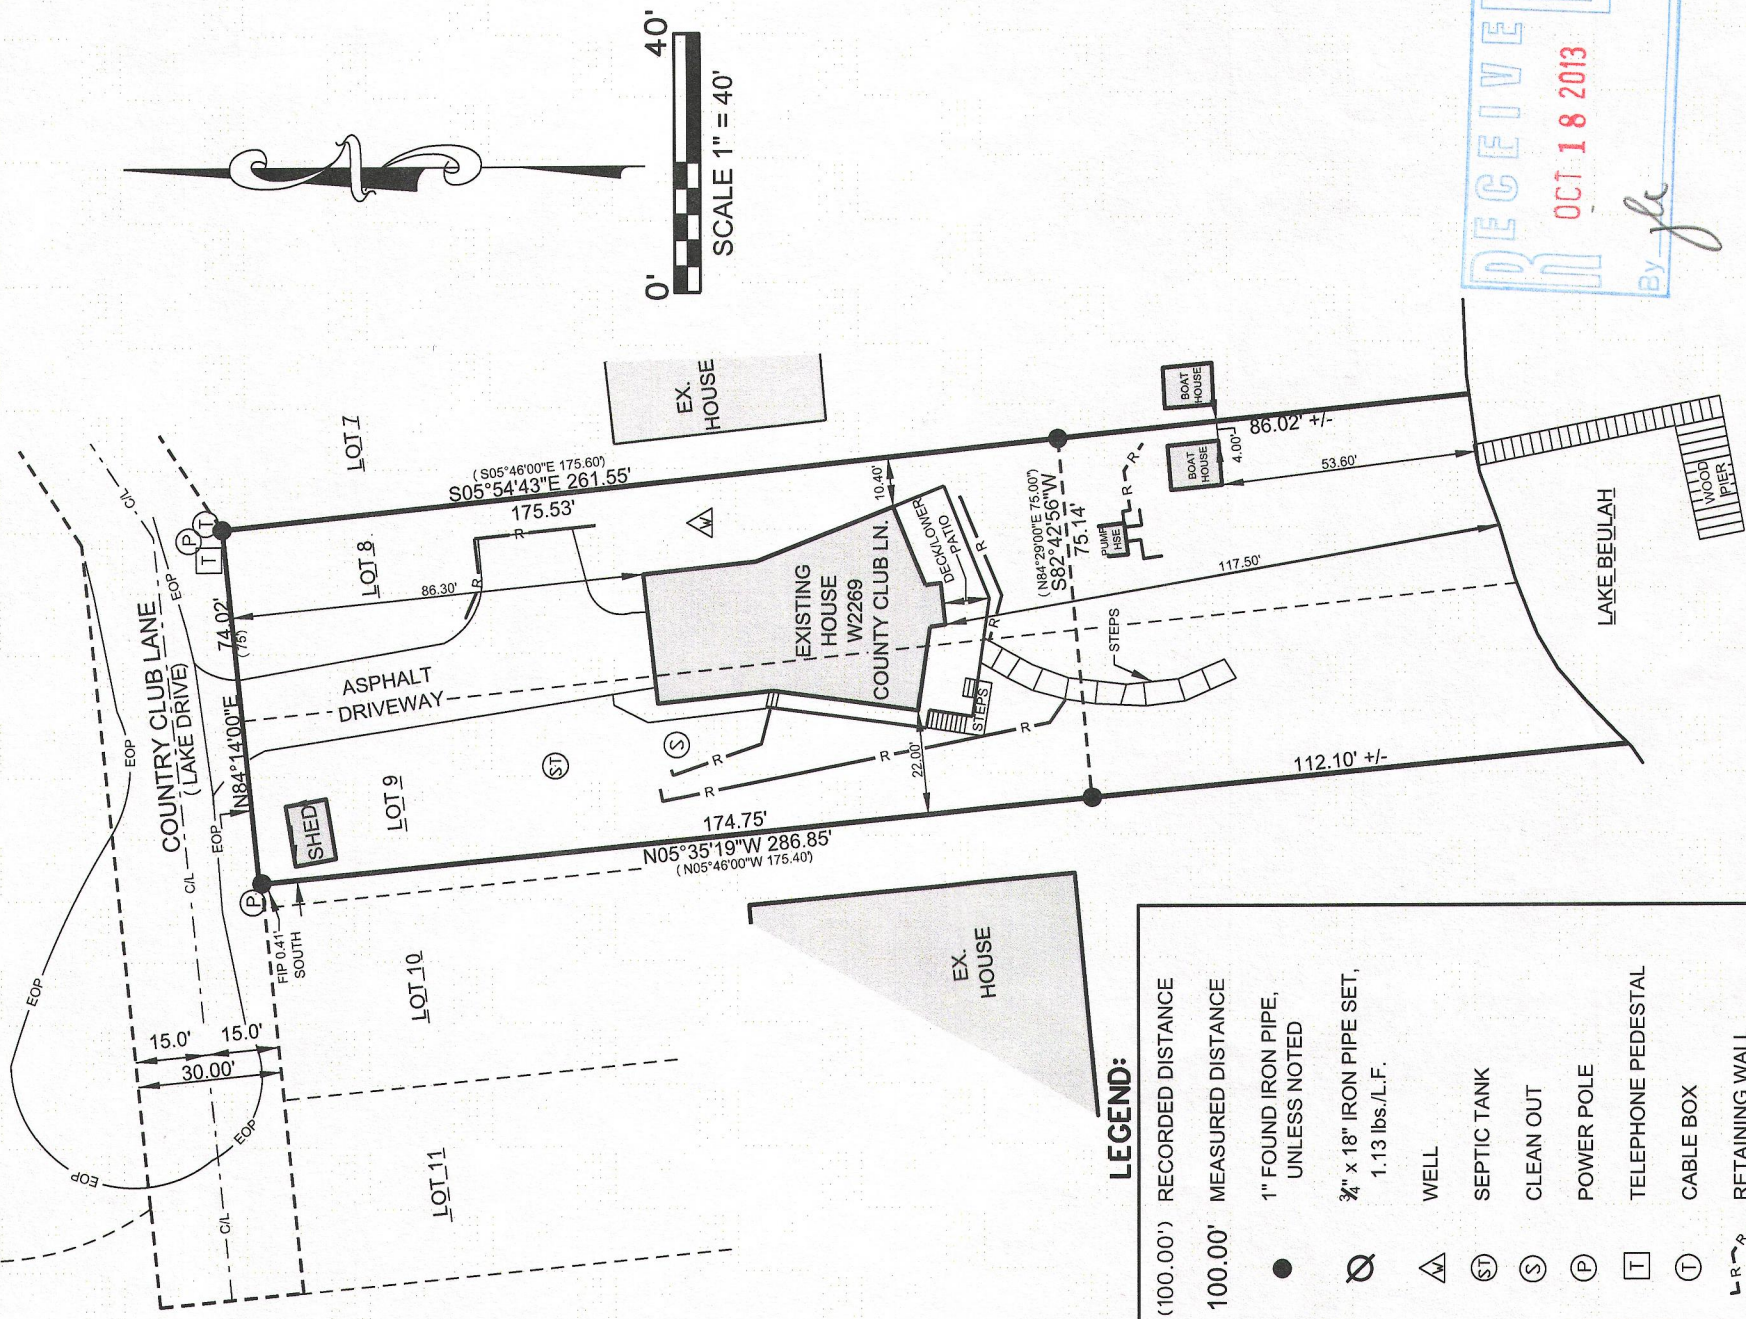

LEGEND:

(100.00')	RECORDED DISTANCE
100.00'	MEASURED DISTANCE
●	1" FOUND IRON PIPE, UNLESS NOTED
⊘	¾" x 18" IRON PIPE SET, 1.13 lbs./L.F.
△	WELL
⊙	SEPTIC TANK
⊙	CLEAN OUT
Ⓟ	POWER POLE
Ⓜ	TELEPHONE PEDESTAL
Ⓢ	CABLE BOX
⌒	RETAINING WALL

SURVEY DATE: 5/24/2013


SURVEY MADE FOR:

ANTHONY & CHRIS COSTELLO
3000 OAK BROOK HILLS RD.
OAK BROOK, IL 60523

V2G
SURVEYING, LLC
550 BAYVIEW ROAD SUITE B
MUKWONAGO, WI 53149
(262) 378-5097

THIS SURVEY IS MADE FOR THE USE OF THE
PRESENT OWNERS OF THE PROPERTY, AND
ALSO THOSE WHO PURCHASE, MORTGAGE OR
GUARANTEE TITLE TO WITHIN ONE (1) YEAR
FROM DATE HERETO.

I, MICHAEL A. GREESON R.L.S. #2770, HEREBY CERTIFY THAT
THIS SURVEY WAS MADE IN ACCORDANCE WITH
THE MINIMUM STANDARDS FOR PROPERTY SURVEYS
(CHAPTER A-E 7) FOR THE STATE OF WISCONSIN AND
HAS BEEN PREPARED UNDER MY DIRECTION AND
CONTROL AND IS CORRECT TO THE BEST OF MY
KNOWLEDGE AND BELIEF.

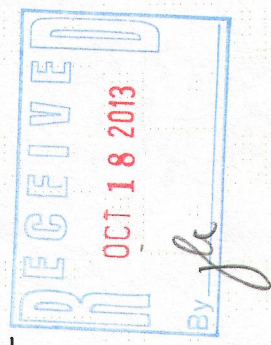

PLOT DATE: 5/54/2013

V2G JOB#:2013-031

PLB -7

418-2383