


KOLB LAND CONSULTING, INC.
LAND SURVEYING • SUBDIVIDING • LAND PLANNING


LAKE GENEVA, WISCONSIN 53147

414-248-3697

ORDERED BY: RICHARD & SUE FRICK X
5-STAR HOMES
90 E. GENEVA SQUARE P.O. BOX 127
LAKE GENEVA, WI. 53147

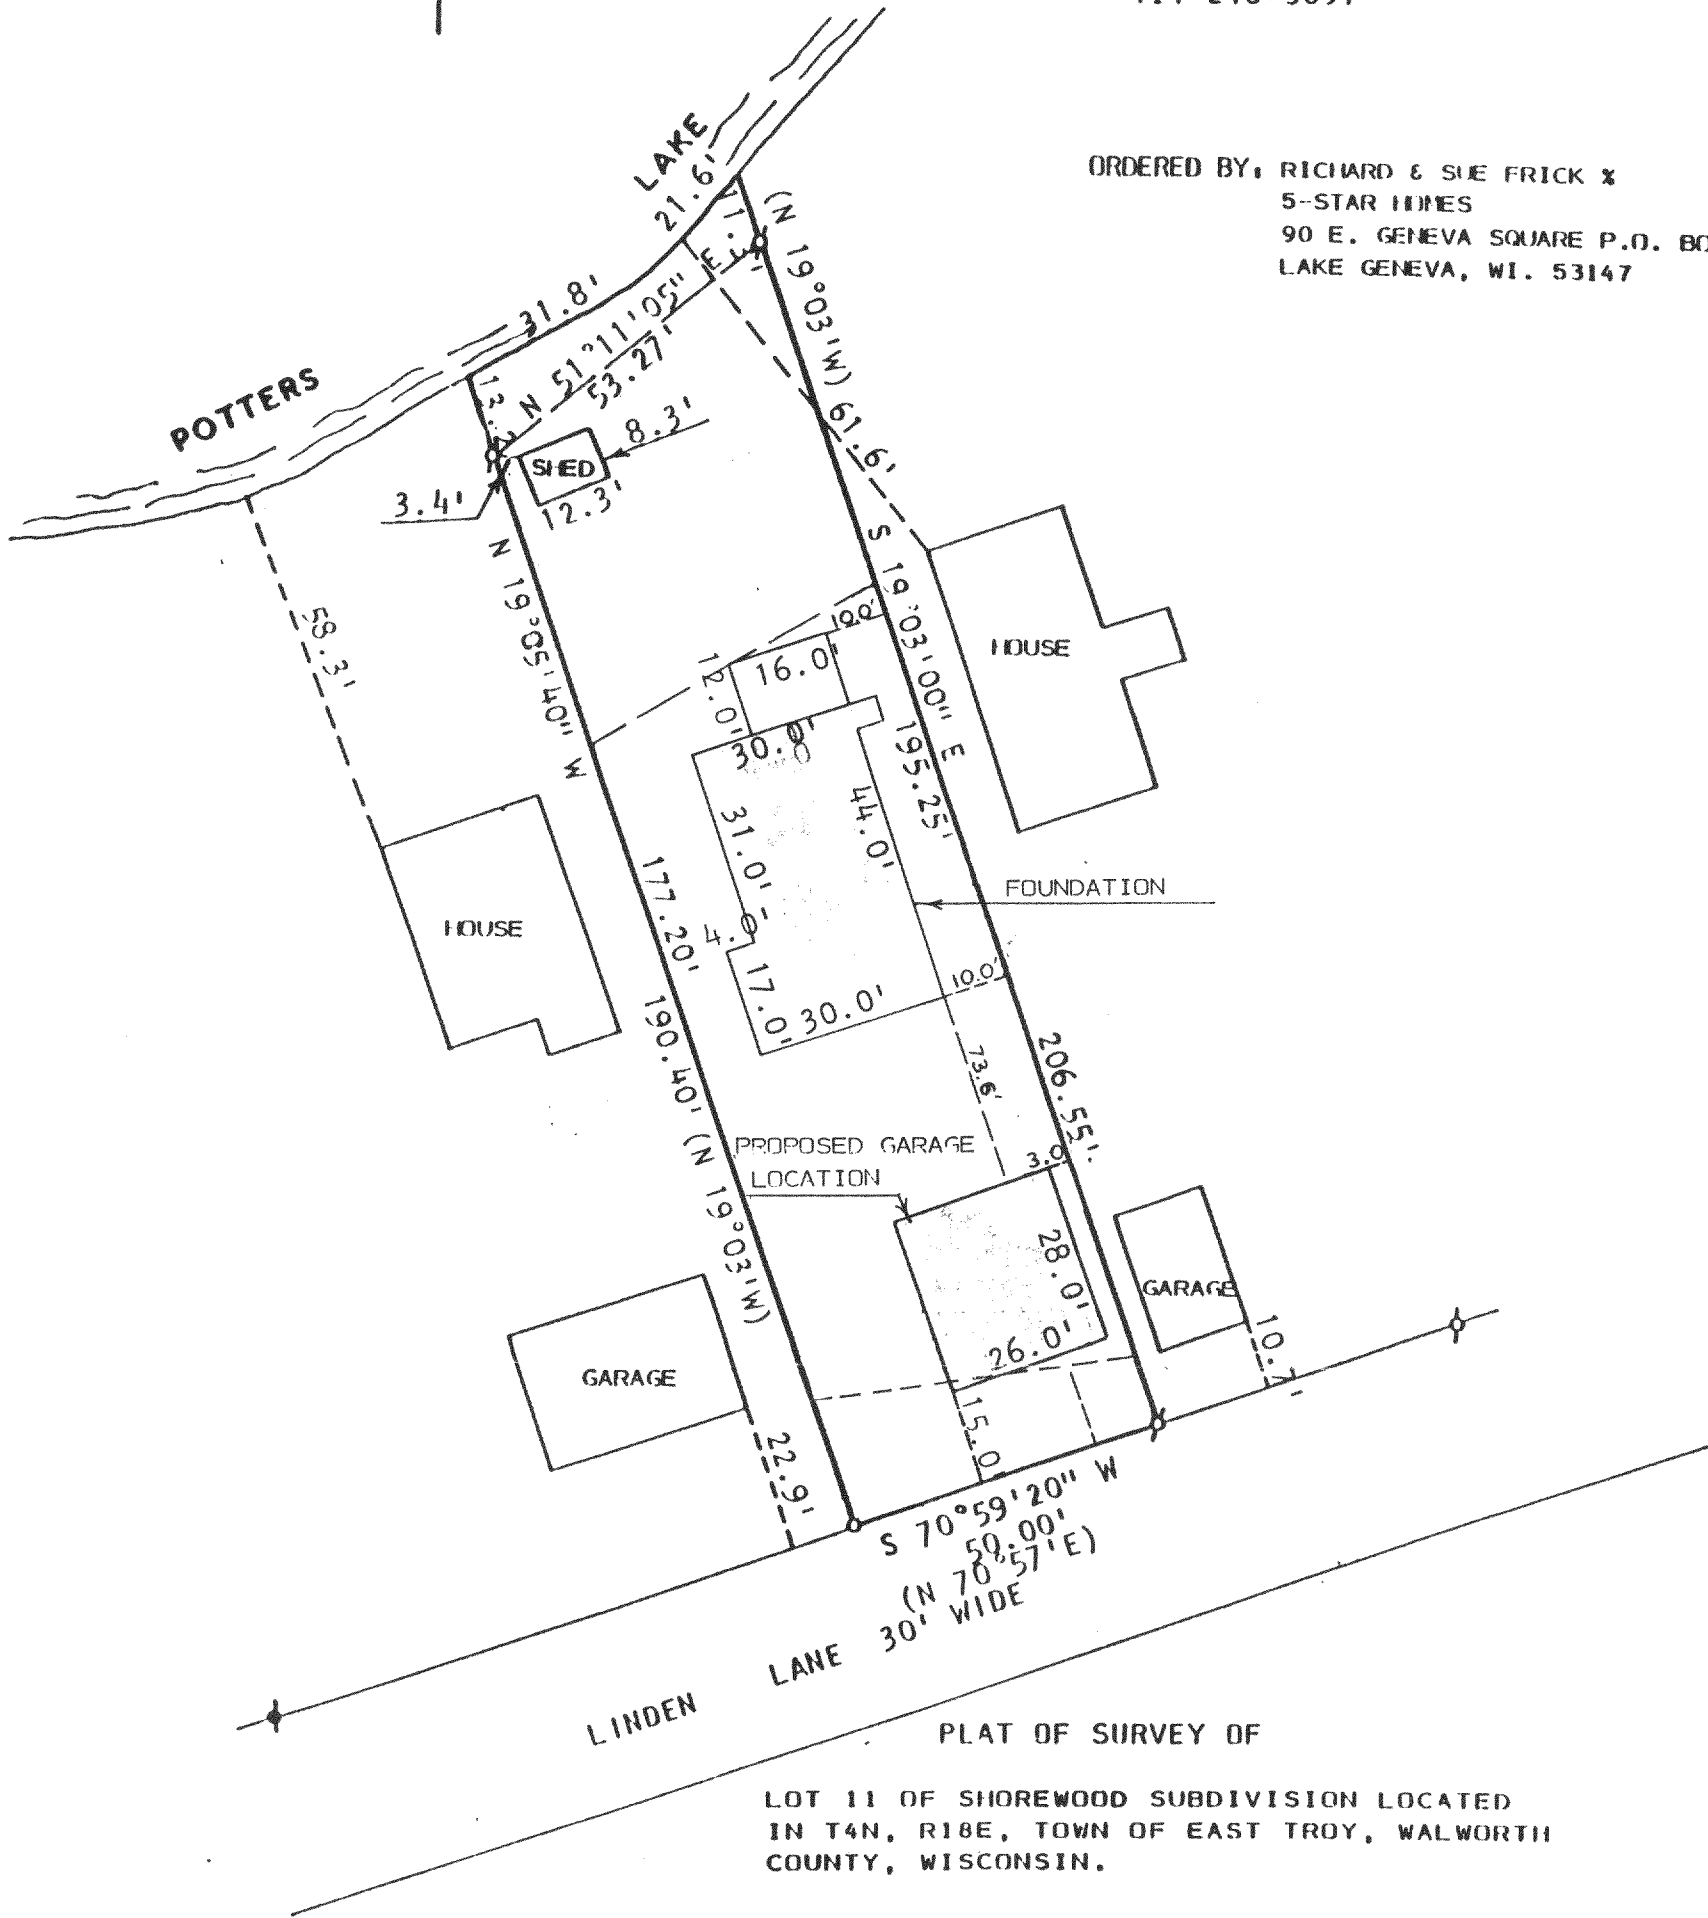

NOTE: BEARINGS ARE ASSUMED AS SHOWN
ON RECORDED SUBDIVISION PLAT.

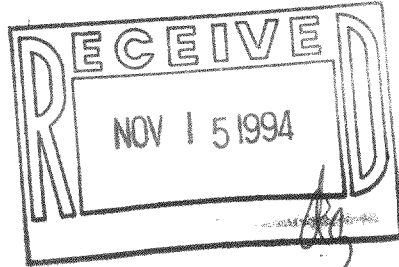

SCALE: 1" = 30'

LEGEND

- ⊕ - IRON PIPE FOUND
- - IRON PIPE SET
- ⚡ - AXEL ROD FOUND
- () - AS RECORDED

I, HAROLD H. KOLB, DO HEREBY CERTIFY
THAT I HAVE SURVEYED THE PROPERTY
HEREON DESCRIBED ACCORDING TO THE
OFFICIAL RECORDS AND THAT THE PLAT
HEREON IS A CORRECT REPRESENTATION
OF THE LOT LINES AND THE PRINCIPAL
LINES OF THE BUILDINGS, TO THE BEST
OF MY KNOWLEDGE AND BELIEF.
SURVEY NOT VALID UNLESS SURVEYOR'S SIGNATURE
IS IN RED.

HAROLD H. KOLB
WISCONSIN REGISTERED LAND SURVEYOR, S-187
DATE NOVEMBER 23, 1993
REVISED JANUARY 12, 1994
4-18-2

PS-11

418-1011