
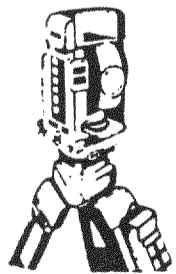
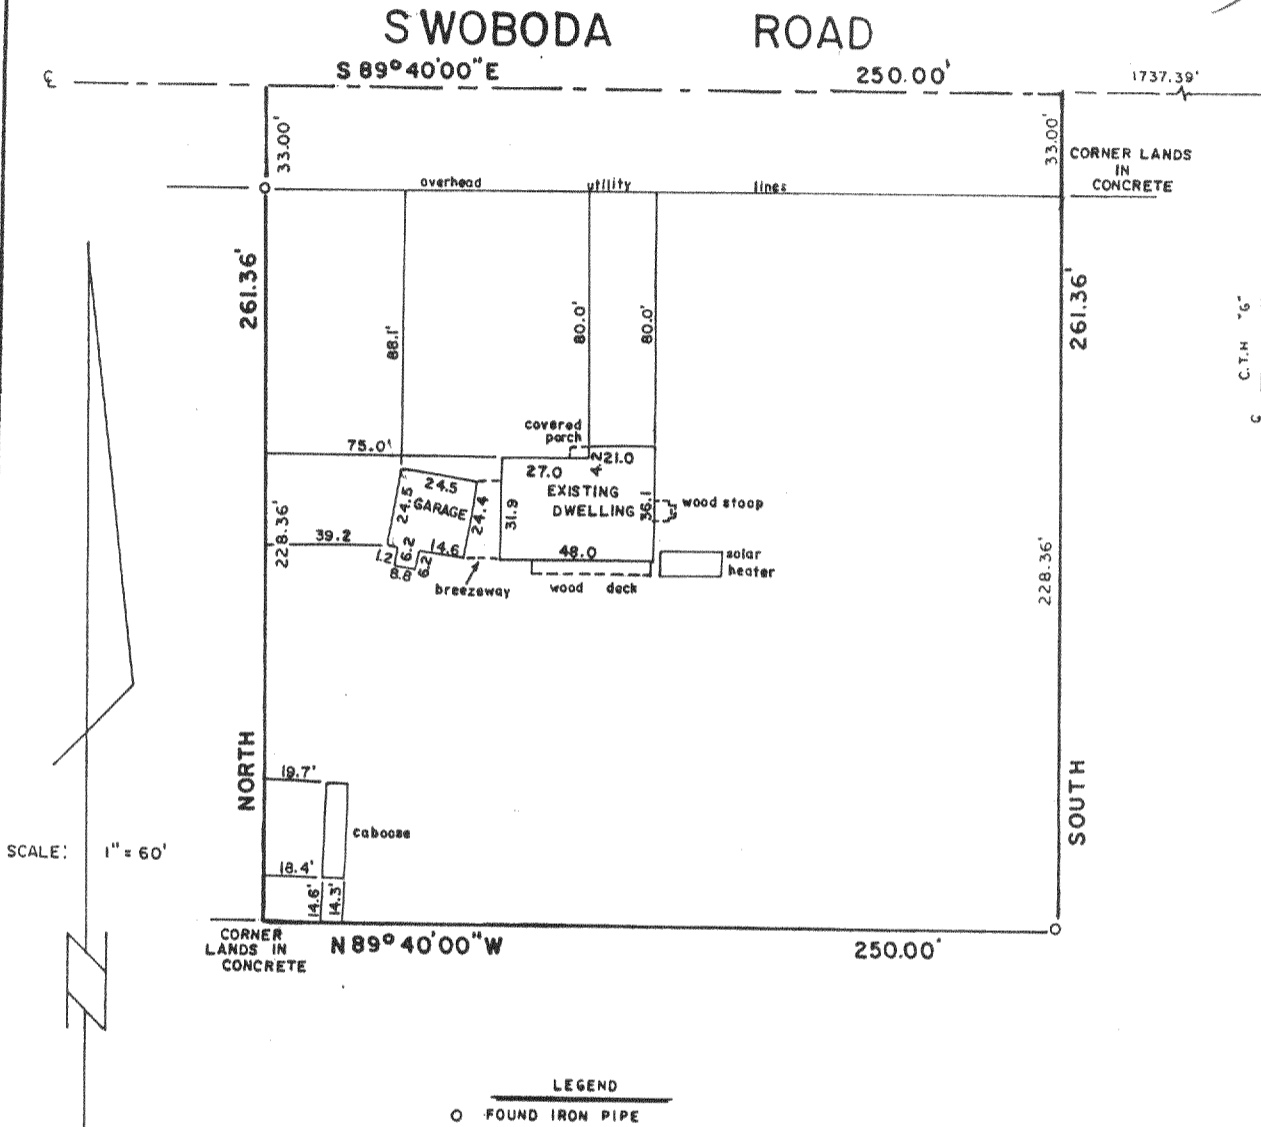



PLAT OF SURVEY
-OF-

LOT 4, CERTIFIED SURVEY MAP No. 37, located in the Southeast 1/4 and the Southwest 1/4 of Section 31, Township 4 North, Range 18 East in the Town of East Troy, Walworth County, Wisconsin.

Survey For: Caleb Lentzner
Survey Location: W2245 Swoboda Road

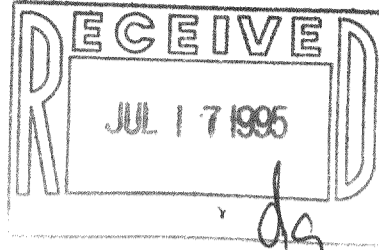

B.W. SURVEYING
Land Surveys
Mapping And Planning
35117 Academy Road
Burlington, Wisconsin 53105
(414) 534-4109

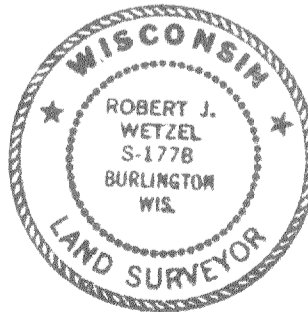

"I hereby certify that I have surveyed the above described property and that the above map is a true representation thereof and shows the size and location of the property, its exterior boundaries, the location of all visible structures and dimensions of all principal buildings thereon, boundary fences, apparent easements, roadways and encroachments, if any."

THIS IS NOT AN ORIGINAL PRINT
UNLESS THIS SEAL IS RED

Robert J. Wetzel
ROBERT J. WETZEL
REGISTERED LAND SURVEYOR - 1778

"This survey is made for the use of the present owners of the property, and those who purchase, mortgage, or guarantee the title thereto within one year from date hereof."

MAY 18, 1995
DATE

2065
JOB NUMBER
418-1044

PA-37-4