

# PLAT OF SURVEY

**RSV ENGINEERING, INC**  
ENGINEERS, PLANNERS, SURVEYORS  
CONSTRUCTION MANAGERS  
545 BAY VIEW ROAD, MUKWONAGO, WISCONSIN 53149 (414) 363-2004

FOR: ALVIN P. AND CAROLE V. FERNANDEZ

DATE: 7/17/95

DESCRIPTION: LOT 3 OF CERTIFIED SURVEY MAP NO. 1360 BEING LOCATED IN PART OF THE SOUTHWEST  $\frac{1}{4}$  OF SECTION 11, TOWNSHIP 4 NORTH, RANGE 18 EAST, TOWN OF EAST TROY, WALWORTH COUNTY, WISCONSIN.



## LEGEND

- FOUND 1" IRON PIPE

### C1 CURVE DATA

R = 60.00'  
 $\Delta = 75^{\circ}38'27''$   
L = 79.21'  
CHD. BRG. = N12°23'02"E  
CHD. L. = 73.59

SCALE 1" = 40'

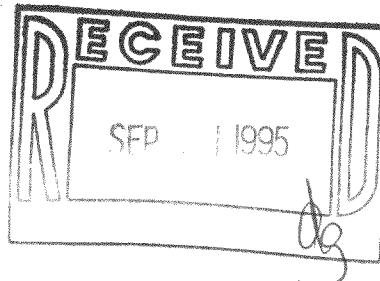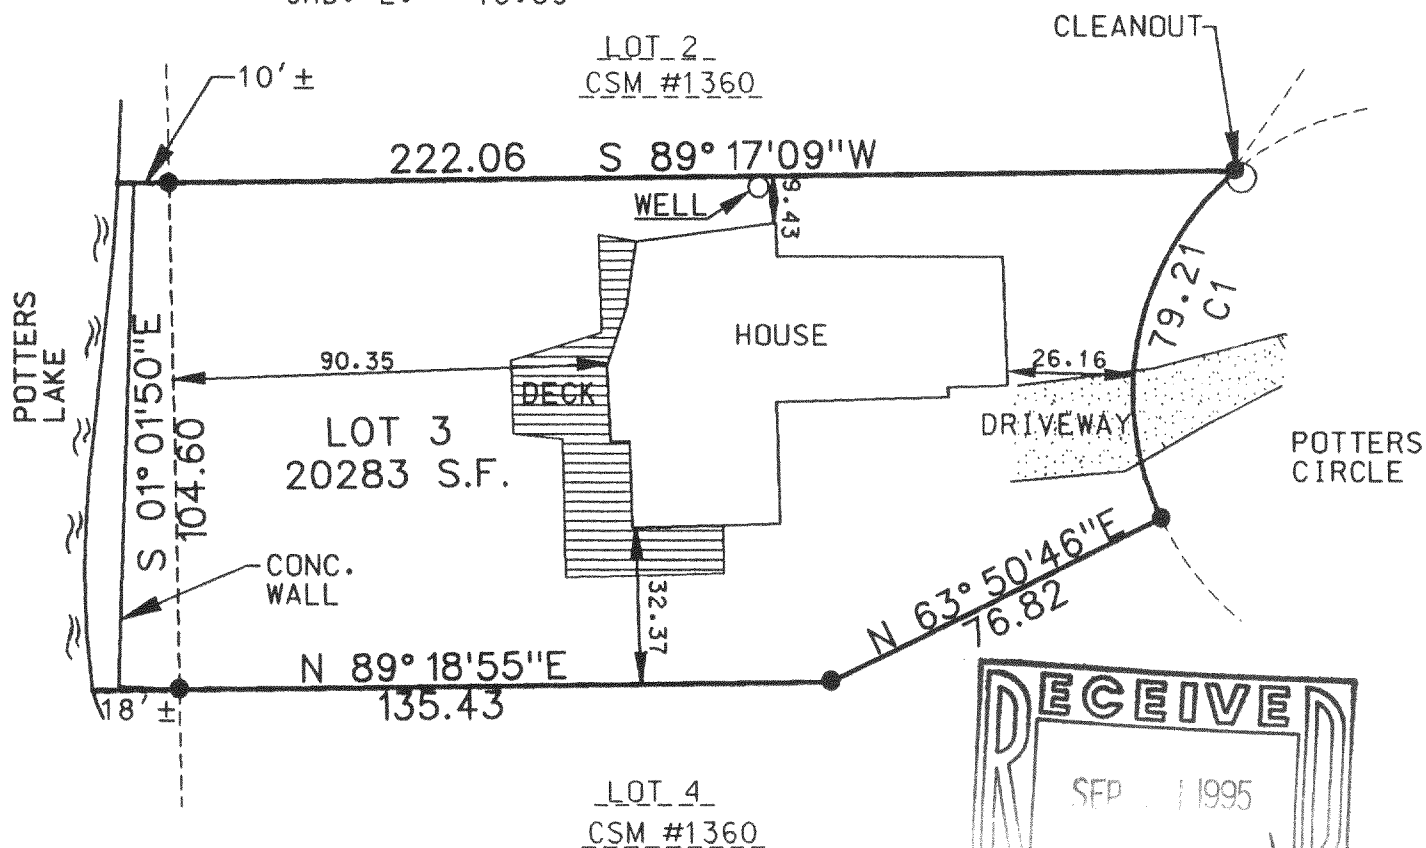

THE ABOVE MAP IS A TRUE REPRESENTATION THEREOF AND SHOWS THE SIZE AND LOCATION OF ALL THE PROPERTY, EXTERIOR BOUNDARIES, THE LOCATION OF ALL VISIBLE BOUNDARY FENCES, APPARENT EASEMENTS, ROADWAYS AND VISIBLE ENCROACHMENTS, IF ANY.

THIS SURVEY IS MADE FOR THE USE OF THE PRESENT OWNERS OF THE PROPERTY, AND ALSO THOSE WHO PURCHASE, MORTGAGE OR GUARANTEE TITLE THERETO WITHIN ONE (1) YEAR FROM DATE HERETO.

BRADFORD L. SPENCER, R.L.S. 2069  
RSV#95088

THIS IS ORIGINAL  
PRINT ONLY IF  
SEAL IS IMPRINTED  
IN RED



PA-1360-3

418-1060