


PLAT OF SURVEY

LOT 16 except commencing at the Northwestern corner of said Lot 16; thence South 22°53' East 78.75 feet along the Easterly line of a 33 feet wide road to an iron stake; thence North 76°23' East 174.6 feet to an iron stake; thence North 53°18' East 10.85 feet to an iron stake in the Westerly of the 50 feet wide road; thence North 36°30' West along the Westerly line of said road 103.8 feet to an iron post; thence South 72°17' West along the Northerly line of said Lot 16 157.75 feet to the place of beginning, in the subdivision of Lot 10, Plat of Beulah Lake Park in the Southeast 1/4 of Section 4, Township 4 North, Range 18 East, Town of East Troy, Walworth County, Wisconsin, ALSO a perpetual easement and right-of-way over said Lot 10 driveway and extensions thereof and the right to the use of Beulah Alley in said subdivision and the right to use as a right-of-way to the shore of Lake Beulah the North 20 feet of Lot 1 in Beulah Lake Park according to the recorded plat thereof in common with the owners of Lots 6,7,8,9,14,15, and 16 of said subdivision.


Surveyed for: Allan Webb

Survey address: N. 9328 Beulah Park Road

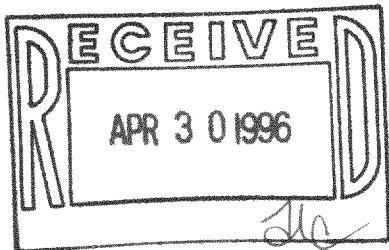

SCALE 1"=30'


- FOUND 1" IRON PIPE
- ⊙ FOUND 2" IRON PIPE
- SET 1" IRON PIPE
- ⦿ SET SPIKE
- () RECORDED AS

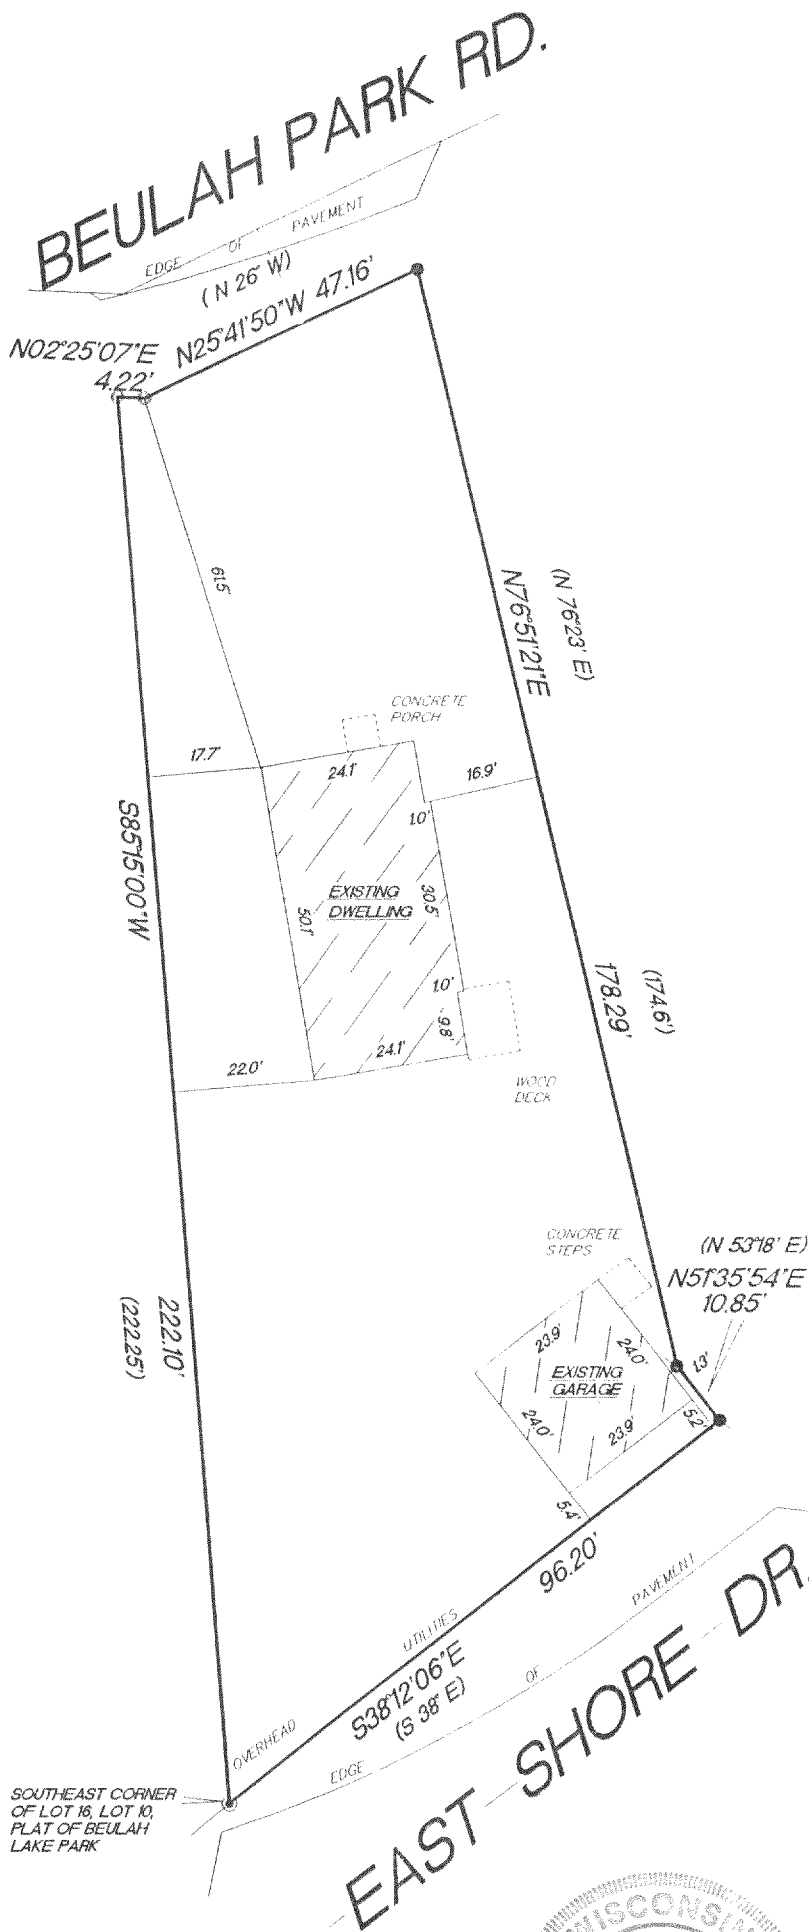

"I hereby certify that I have surveyed the above described property and that the above map is a true representation thereof and shows the size and location of the property, its exterior boundaries, the location of all visible structures and dimension of all principal buildings thereon, boundary fences, apparent easements, roadways and encroachments if any."

"This survey is made for the use of the present owners of the property, and also those who purchase, mortgage or guarantee the title thereto within one year from date hereof."

KETTLE MORaine SURVEYING
W362 S10227 Lewin Lane
Eagle Wisconsin 53119
(414) 594-3484
fax (414) 594-5904
Terrance E. Pisarek R.L.S.

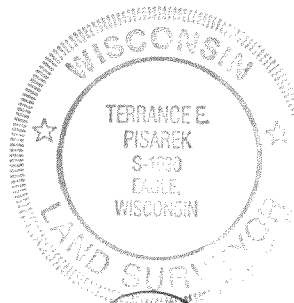

THIS IS NOT AN ORIGINAL SURVEY UNLESS THE SEAL IS RED.

4/22/94

DATE

TEP/DRF

FIELD WORK BY

TEP

DRAWN BY

96054

JOB NUMBER

PBLA-20