
ABERNATHY and ASSOCIATES Kenneth B. Abernathy Jr.

Wisconsin Registered Land Surveyor S-1594

Rt. 3, Box 273 Elkhorn, Wisconsin 53121 Phone: (414) 723-4260 (office) (414) 723-7209 (FAX)

PLAT OF SURVEY

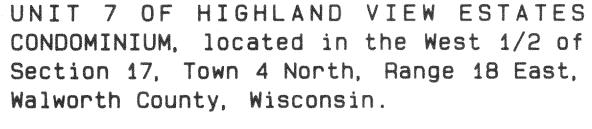


ordered by: DRUMMOND CONSTRUCTION N9367 BEULAH PARK RD. EAST TROY, WI. 53120

owners: ROBERT AND JOAN FARRELL W173 N9170 ST. FRANCIS MENOMONEE FALLS, WI. 53057

DETAIL OF EXISTING RESIDENCE

UNDER CONSTRUCTION - FOUNDATION COMPLETE

SCALE 1" = 10 FEET

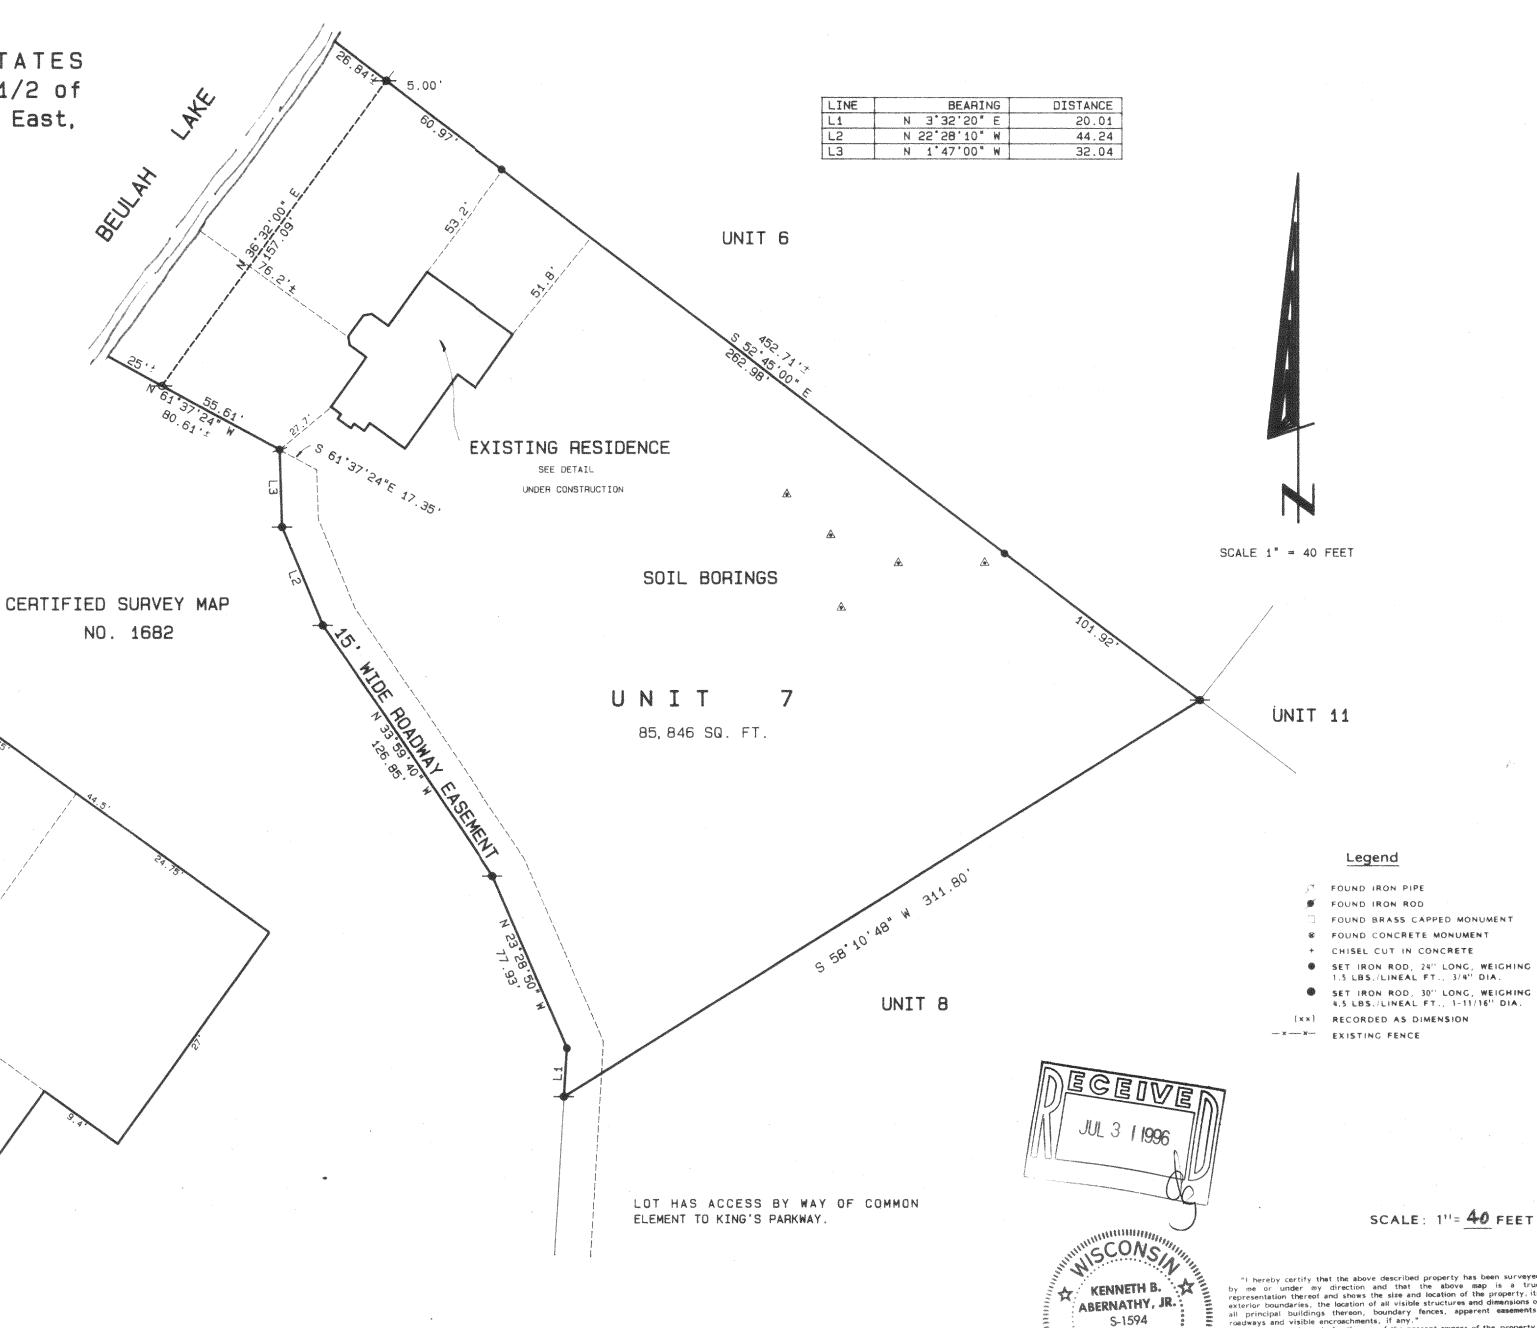

PLAT REVISED TO SHOW AS BUILT LOCATION 7/11/96

PLAT REVISED 5/15/96 TO SHOW REVISED

RESIDENCE

"I hereby certify that the above described property has been surveyed by me or under my direction and that the above map is a true representation thereof and shows the size and location of the property, its exterior boundaries, the location of all visible structures and dimensions of all principal buildings thereon, boundary fences, apparent easements, roadways and visible encroachments, if any."

"This survey is made for the use of the present owners of the property, and also those who purchase, mortgage, or guarantee the title thereto within one year from date hereof."

KENNETH B. ABERNATHY, JR. WISCONSIN REGISTERED LAND SURVEYOR,

Date: 06T. 5, 1995

ELKHORN,

_ Job No. 95.905