


PLAT OF SURVEY

-OF-



LOTS 3, 4, 5 and 24, FAIRWAY SUBDIVISION, being a resubdivision of part of Williams Park Subdivision located in the Southwest 1/4, Northeast 1/4 and the Southeast 1/4 and the Northwest 1/4 of Section 4, Township 4 North, Range 18 East in the Town of East Troy, Walworth County, Wisconsin.

Survey For: Michael Bohmann
Survey Location: W1535 Cty Road "J"

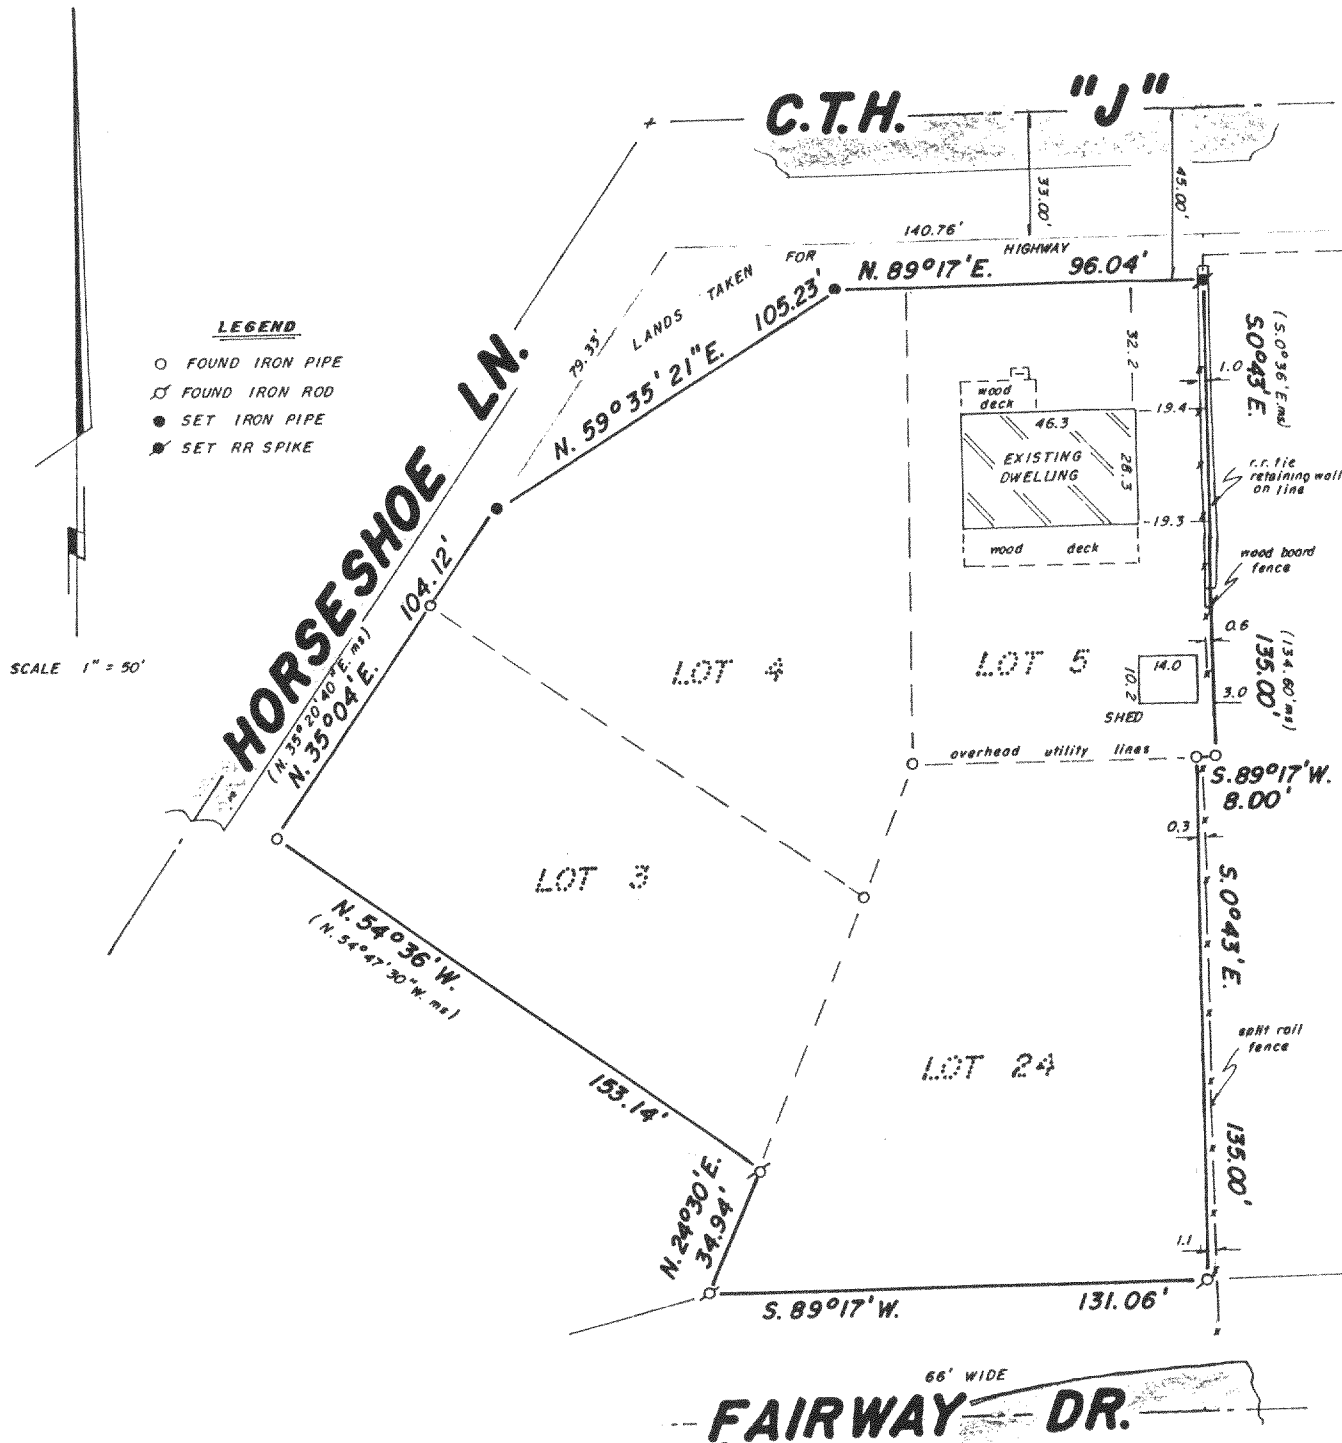

B.W. SURVEYING

Land Surveys
Mapping And Planning
425 Milwaukee Avenue
Burlington, WI 53105
(414) 767-0225

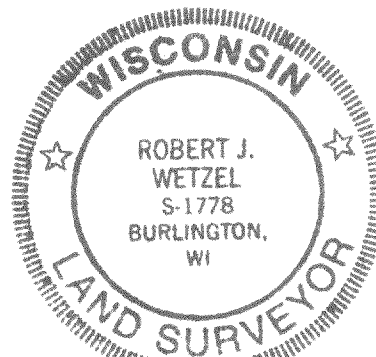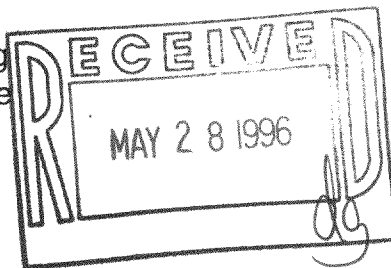

THIS IS NOT AN ORIGINAL PRINT
UNLESS THIS SEAL IS RED

Robert J. Wetzel
ROBERT J. WETZEL
REGISTERED LAND SURVEYOR - 1778

"This survey is made for the use of the present owners of the property, and those who purchase, mortgage, or guarantee the title thereto within one year from the date hereof."

8-24-95
DATE

2192
JOB NUMBER

PF-3
PF-3B
PF-3A

"I hereby certify that I have surveyed the above described property and that the above map is a true representation thereof and shows the size and location of the property, its exterior boundaries, the location of all visible structures and dimensions of all principal buildings thereon, boundary fences, apparent easements, roadways and encroachments, if any."

418-1112