


# PLAT OF SURVEY

**RSV ENGINEERING, INC**  
ENGINEERS, PLANNERS, SURVEYORS  
CONSTRUCTION MANAGERS  
646 BAY VIEW ROAD, MUKWONAGO, WISCONSIN 53149 (414) 363-2004

FOR: CHRIS STROLENY

DATE: 2/28/96


DESCRIPTION: LOT 23 OF SHOREWOOD BEING A SUBDIVISION IN THE SE<sup>1</sup>/<sub>4</sub> OF SECTION 10, THE SW<sup>1</sup>/<sub>4</sub> OF SECTION 11, THE NW<sup>1</sup>/<sub>4</sub> OF SECTION 14 AND THE NE<sup>1</sup>/<sub>4</sub> OF SECTION 15, ALL IN TOWN 4 NORTH, RANGE 18 EAST, TOWN OF EAST TROY, WALWORTH COUNTY, WISCONSIN.

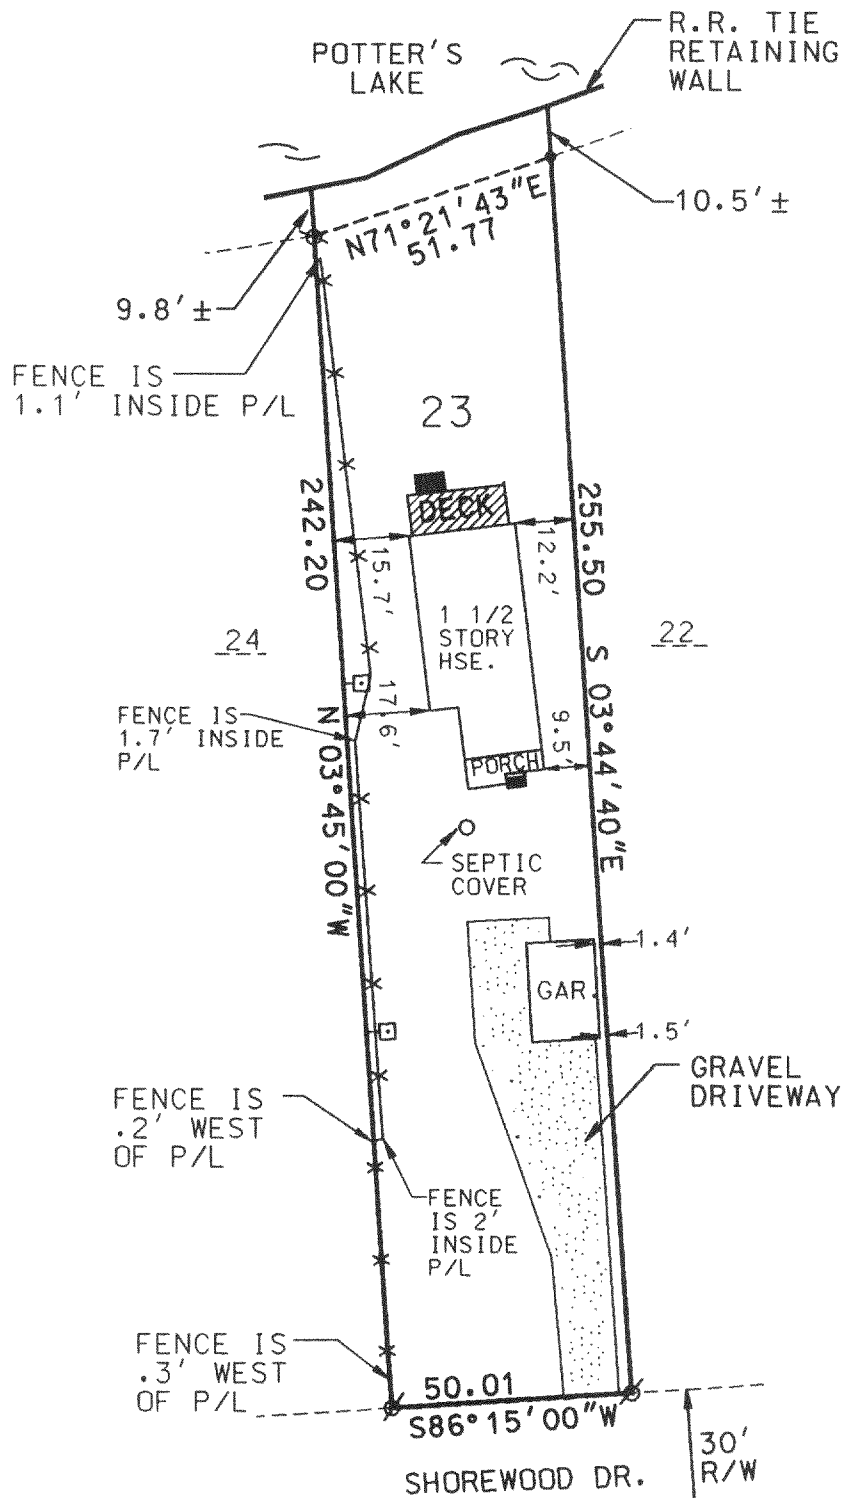

SCALE 1" = 40'

## LEGEND

- POWER POLE
- IRON PIPE FOUND
- ⊘ 1" IRON PIPE SET
- x—x— FENCE

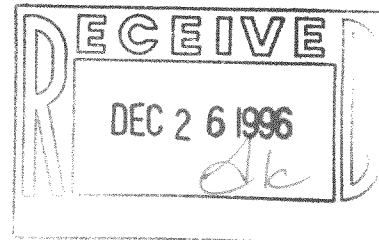


THE ABOVE MAP IS A TRUE REPRESENTATION THEREOF AND SHOWS THE SIZE AND LOCATION OF ALL THE PROPERTY, EXTERIOR BOUNDARIES, THE LOCATION OF ALL VISIBLE BOUNDARY FENCES, APPARENT EASEMENTS, ROADWAYS AND VISIBLE ENCROACHMENTS, IF ANY.

THIS SURVEY IS MADE FOR THE USE OF THE PRESENT OWNERS OF THE PROPERTY, AND ALSO THOSE WHO PURCHASE, MORTGAGE OR GUARANTEE TITLE THERETO WITHIN ONE (1) YEAR FROM DATE HERETO.

BRADFORD L. SPENCER, R.L.S. 2069  
RSV#96028.DGN

THIS IS ORIGINAL  
PRINT ONLY IF  
SEAL IS IMPRINTED  
IN RED

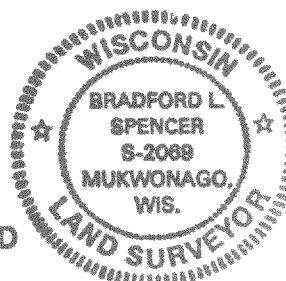

PS-23

418-1131