


PLAT OF SURVEY
 LOT 5 OF BLOCK 1 OF
 CLEARVIEW
 A SUBDIVISION LOCATED IN
 SEC. 18, T4N, R18E
 WALWORTH COUNTY, WISCONSIN

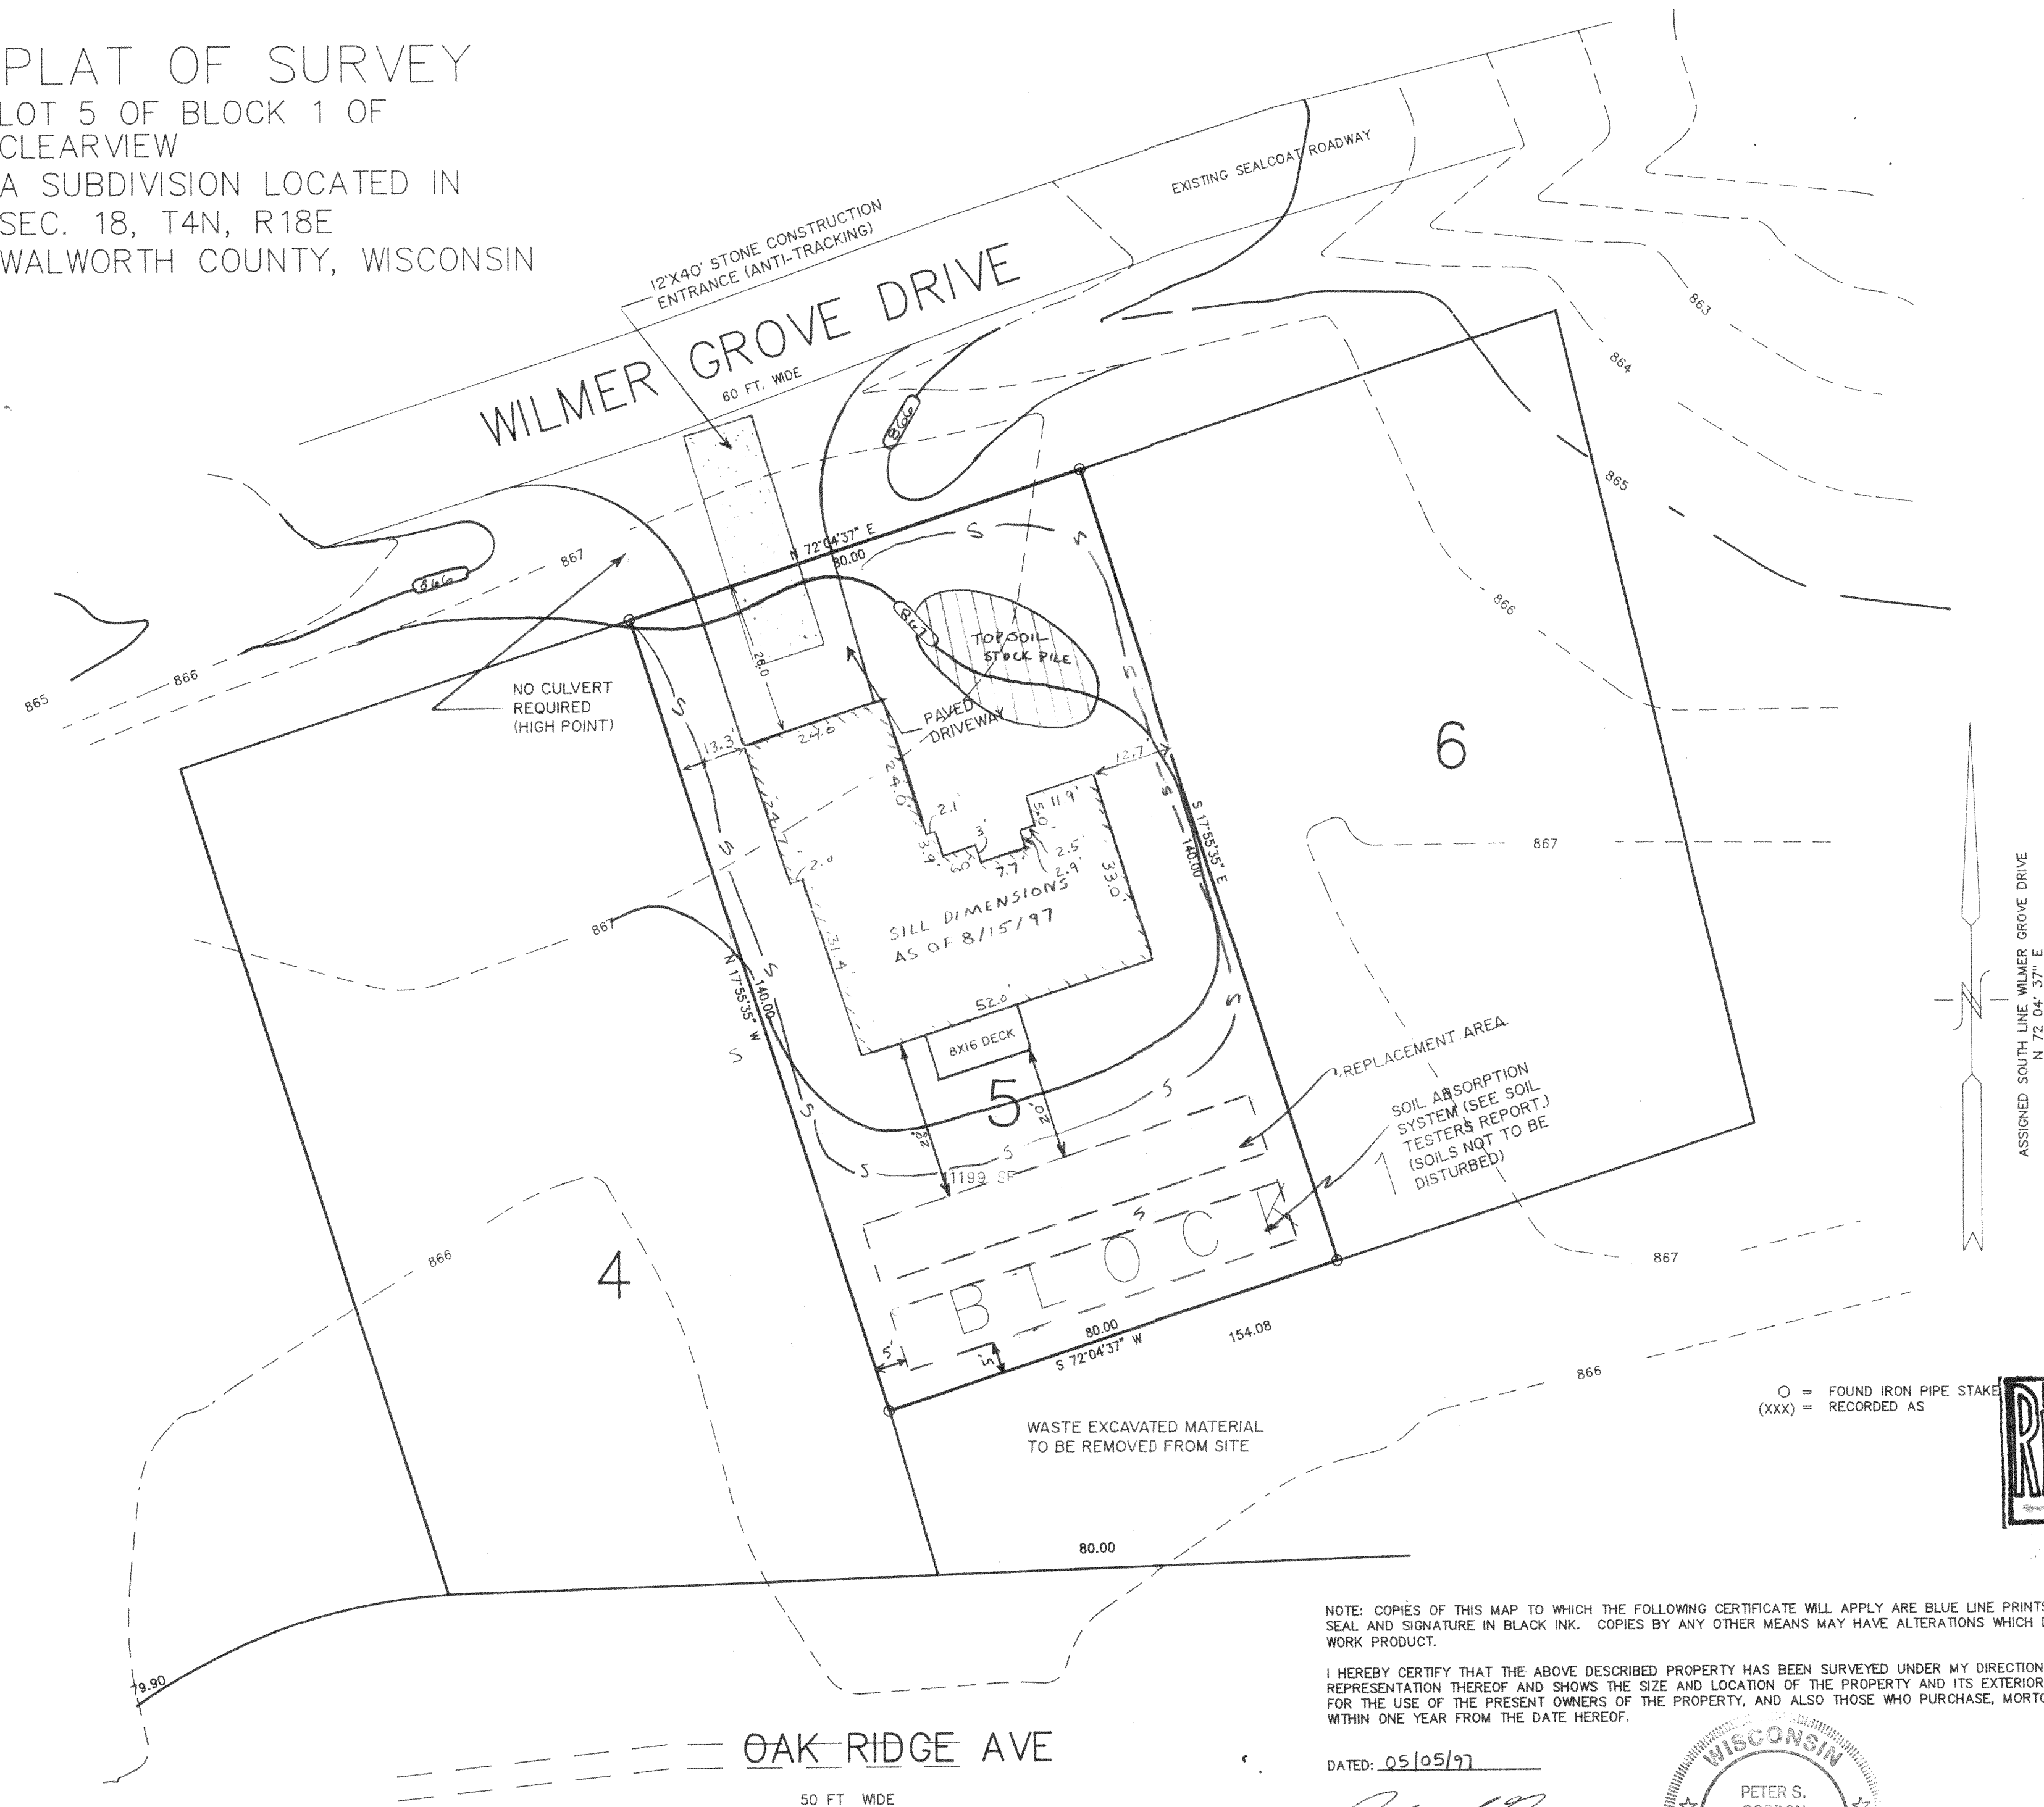



O = FOUND IRON PIPE STAKE
 (XXX) = RECORDED AS

RECEIVED
 OCT 3 1997

NOTE: COPIES OF THIS MAP TO WHICH THE FOLLOWING CERTIFICATE WILL APPLY ARE BLUE LINE PRINTS SHOWING SURVEYOR'S ORIGINAL SEAL AND SIGNATURE IN BLACK INK. COPIES BY ANY OTHER MEANS MAY HAVE ALTERATIONS WHICH DO NOT REPRESENT THE SURVEYOR'S WORK PRODUCT.

I HEREBY CERTIFY THAT THE ABOVE DESCRIBED PROPERTY HAS BEEN SURVEYED UNDER MY DIRECTION AND THAT THE ABOVE MAP IS A TRUE REPRESENTATION THEREOF AND SHOWS THE SIZE AND LOCATION OF THE PROPERTY AND ITS EXTERIOR BOUNDARIES. THIS SURVEY IS MADE FOR THE USE OF THE PRESENT OWNERS OF THE PROPERTY, AND ALSO THOSE WHO PURCHASE, MORTGAGE, OR GUARANTEE THE TITLE THERETO WITHIN ONE YEAR FROM THE DATE HEREOF.

DATED: 05/05/97
 PETER S. GORDON R.L.S. 2101
 REV. 5-7-97
 REV. 5-14-97
 REV. 8-15-97

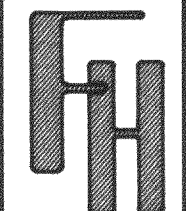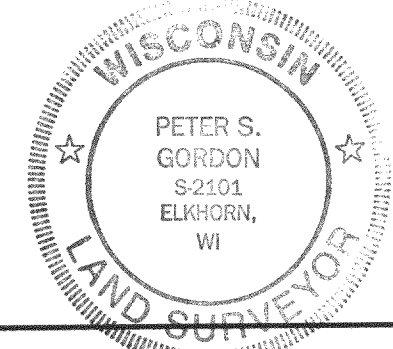

SITE GRADING & EROSION
 CONTROL PLAN
 TOWN OF EAST TROY
 WALWORTH COUNTY, WI.

WORK ORDERED BY: JOHN THEISEN
 PO BOX 1385
 WAUKESHA, WI. 53187

FARRIS, HANSEN & ASSOCIATES, INC.
 Engineering, Architecture, Surveying
 7 Ridgway Court P.O. Box 437
 ELKHORN, WISCONSIN 53121
 Office: (414) 723-2098
 Fax: (414) 723-5886

REVISIONS
 REV. NOTES
 SILT FENCE
 DECK
 SOIL ABOR.
 05/14/97 BLD

PROJECT NO.
 4121
 DATE:
 5-02-97
 SHEET NO.
 1 OF 1

PCU-5 418-1186

4/21.05.01