



PLAT OF SURVEY
-OF-

LOT 1, CERTIFIED SURVEY MAP NO. 1050, being a part of Block 1, Frees Park Subdivision, located in the South 1/2 of Section 4, Township 4 North, Range 18 East in the Town of East Troy, County of Walworth and State of Wisconsin.

Survey For: Dave Bitter
Survey Location: N9467 E. Shore Road

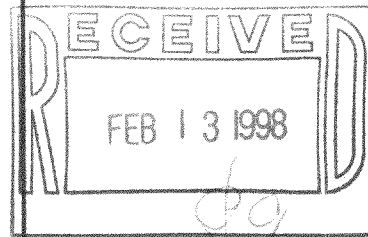

MILL LAKE

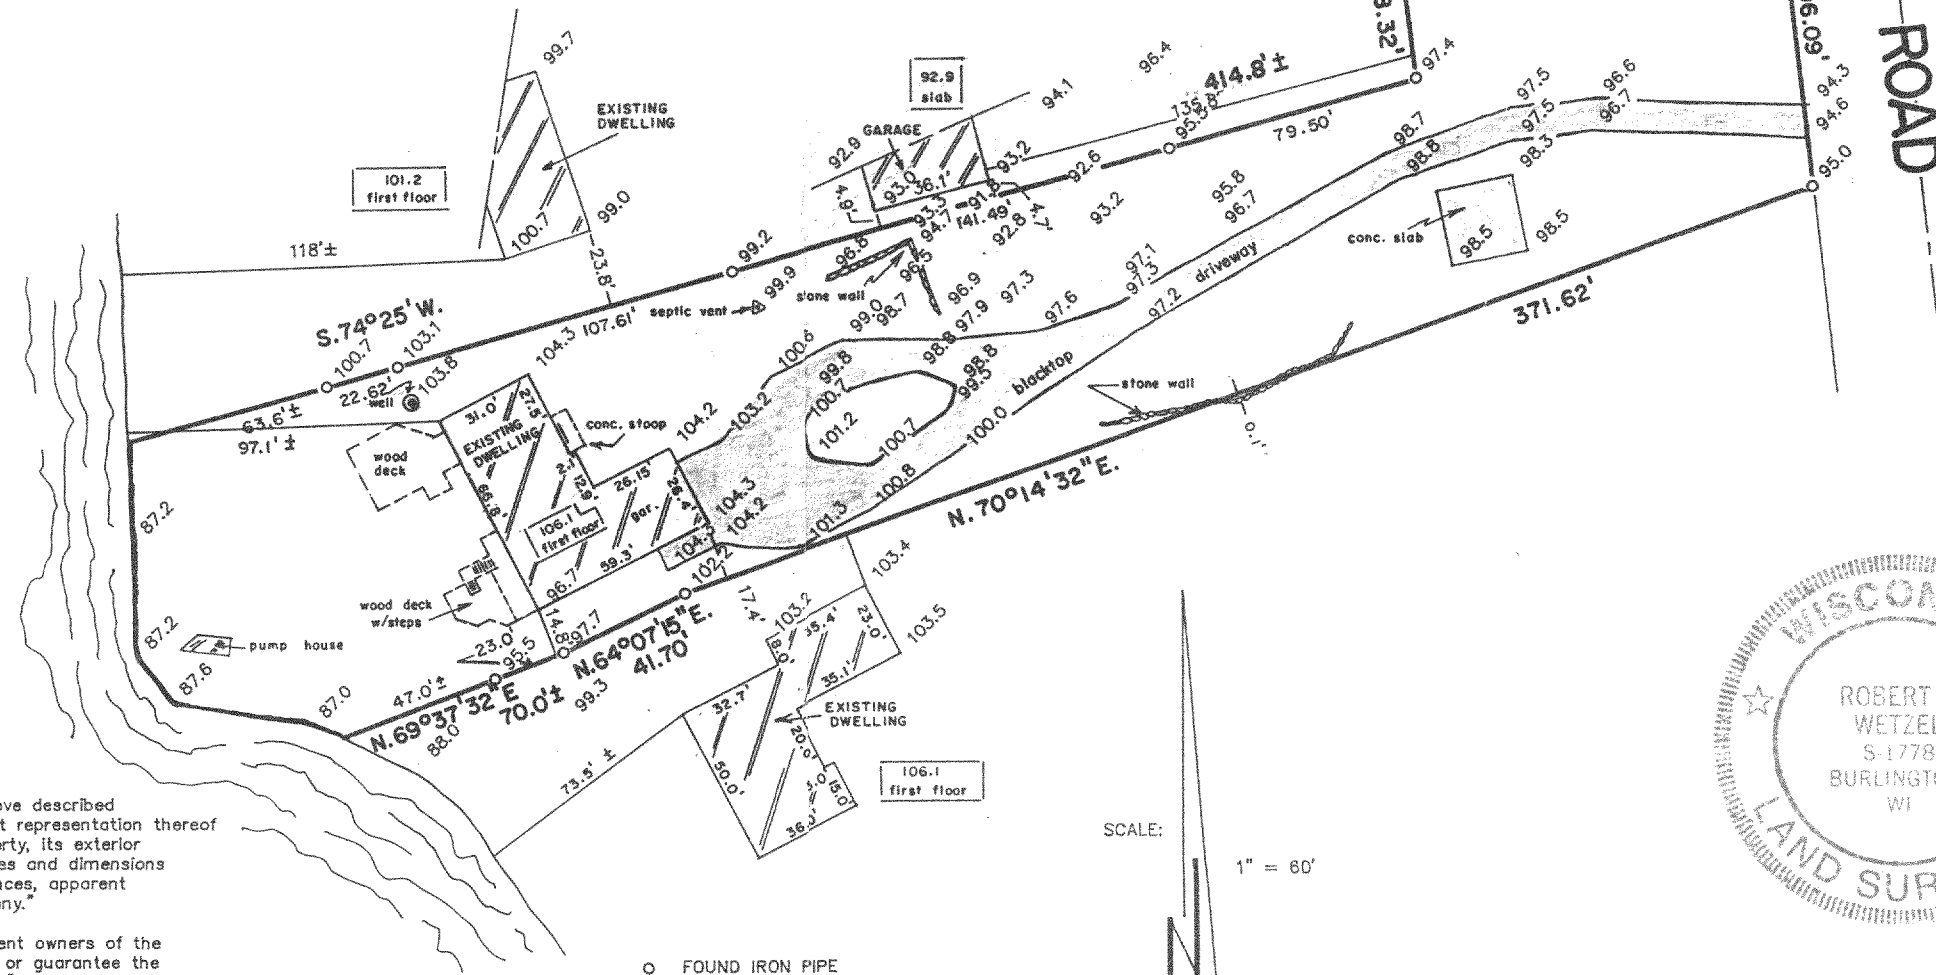


"I hereby certify that I have surveyed the above described property and that the above map is a correct representation thereof and shows the size and location of the property, its exterior boundaries, the location of all visible structures and dimensions of all principal buildings thereon, boundary fences, apparent easements, roadways and encroachments, if any."

"This survey is made for the use of the present owners of the property, and those who purchase, mortgage, or guarantee the title thereto within one year from date hereof."

- FOUND IRON PIPE
- SET IRON PIPE
- 100.0 EXISTING ELEVATION

SCALE: 1" = 60'

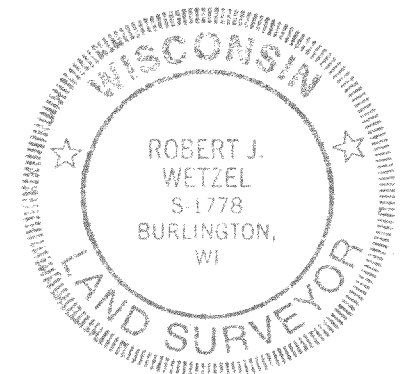


THIS IS NOT AN ORIGINAL PRINT
UNLESS THIS SEAL IS RED.

Robert J. Wetzel
ROBERT J. WETZEL S-1778

APRIL 9, 1997
DATE

2933
JOB NUMBER

PA-1050-1
418-1194

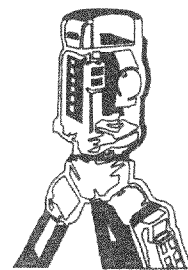

B.W. SURVEYING
LAND SURVEYS
MAPPING AND PLANNING
412 N. PINE STREET
BURLINGTON, WI 53105
(414)-767-0225