

PLAT OF SURVEY

FOUNDATION RECERTIFICATION

FOR: SECURITY HOMES

DATE: 6-30-97



DESCRIPTION:

LOT 6, BLOCK 21, OF MIRAMAR ADDITION NO. 1. A SUBDIVISION OF PART OF THE NW 1/4 AND PART OF THE SW 1/4 OF THE NE1/4 OF SECTION 10, TOWN 4 NORTH, RANGE 18 EAST, TOWN OF EAST TROY, WALWORTH COUNTY, WISCONSIN.

LEGEND

● IRON PIPE FOUND

SCALE 1"=30'

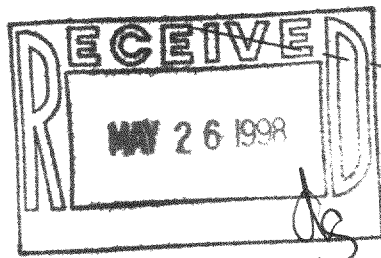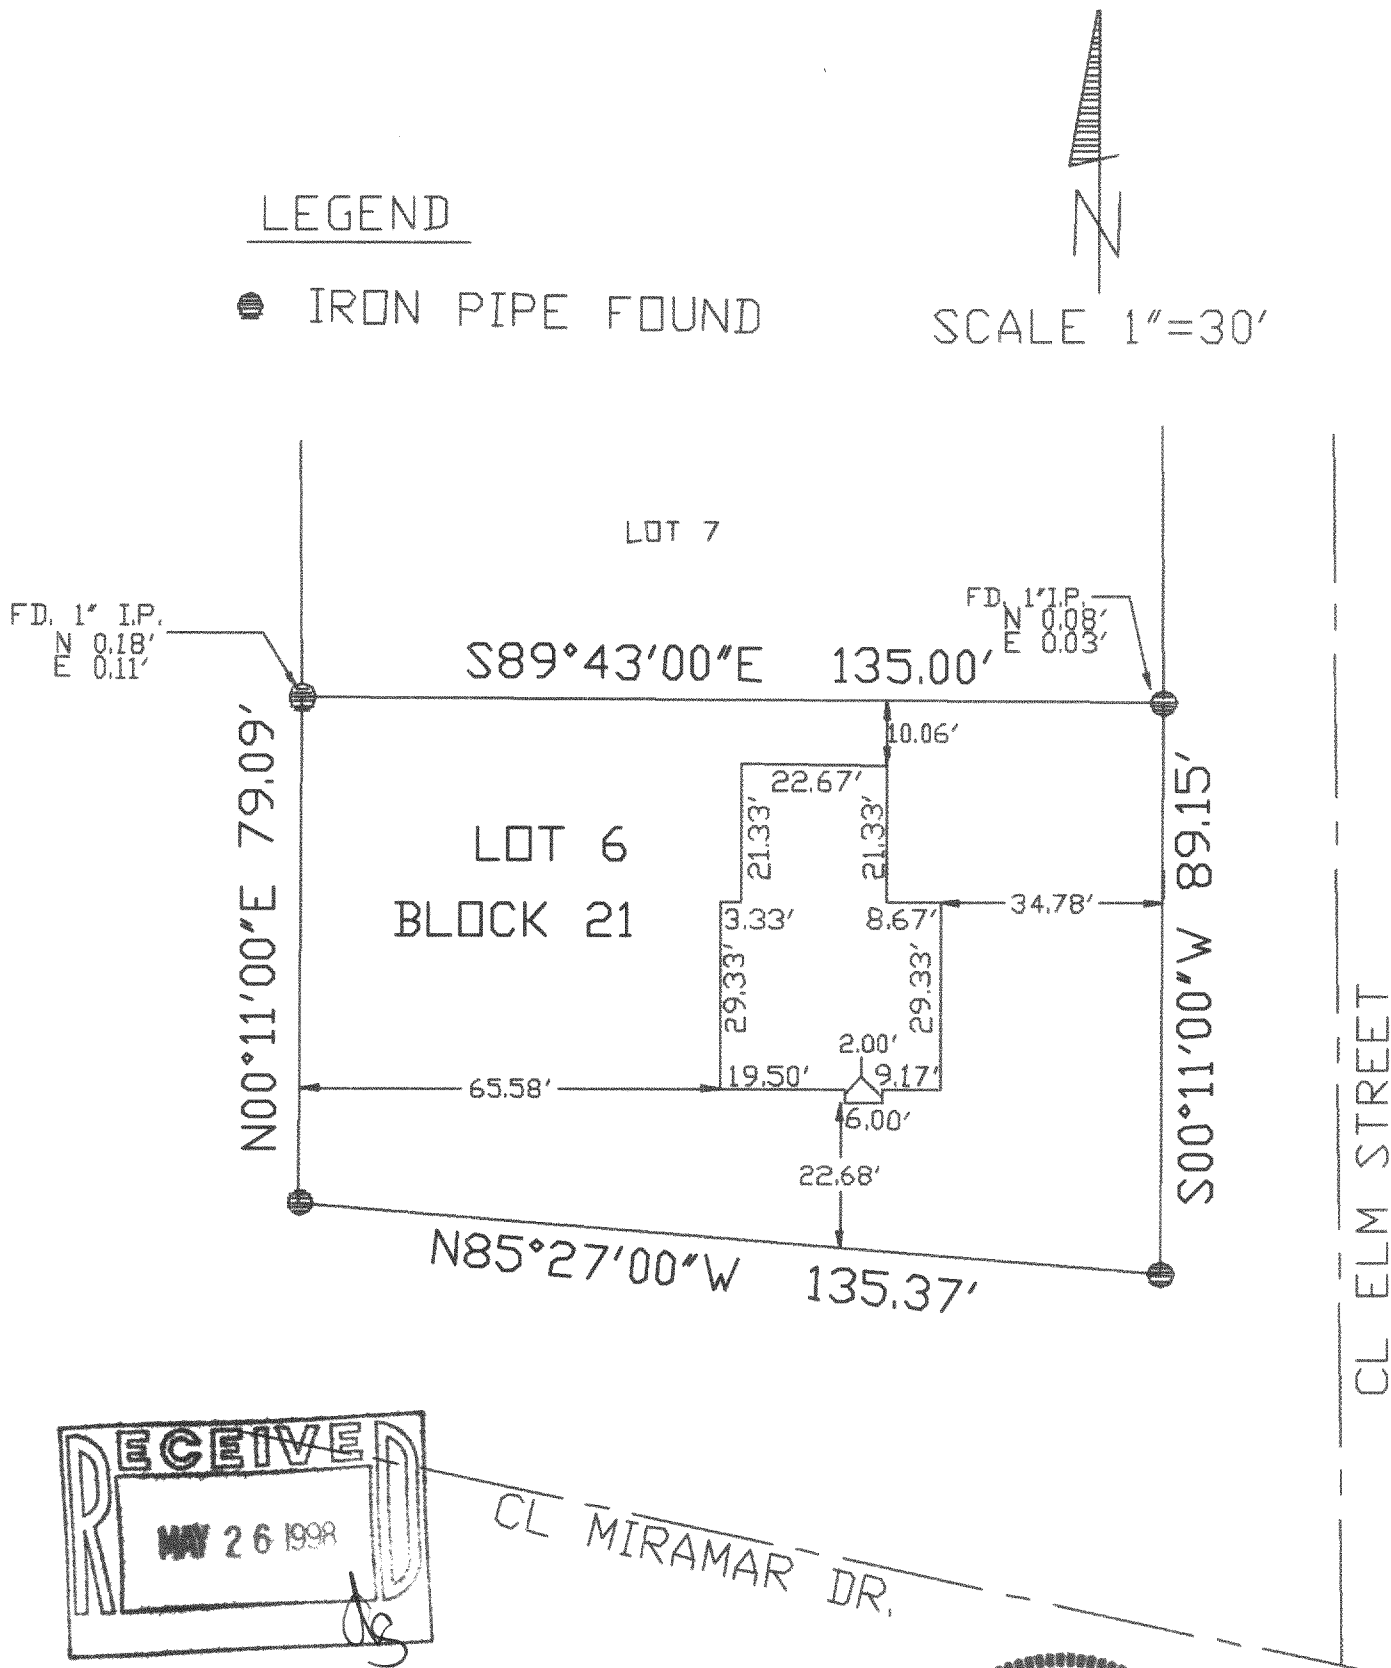


SURVEYOR'S CERTIFICATE

THE ABOVE MAP IS A TRUE REPRESENTATION OF THE PROPERTY SURVEYED AND SHOWS THE EXTERIOR BOUNDARIES, IMPROVEMENTS APPARENT EASEMENTS, ROADWAYS, AND VISABLE ENCROACHMENTS, IF ANY.

THIS SURVEY IS MADE FOR THE EXCLUSIVE RIGHTS OF THE PRESENT OWNERS OF THE PROPERTY AND THOSE WHO PURCHASE, MORTGAGE OR GUARANTEE TITLE THERETO WITHIN ONE (1) YEAR FROM THIS DATE.

DRAFTED BY TERRENCE J. McNULTY R.L.S. 2339

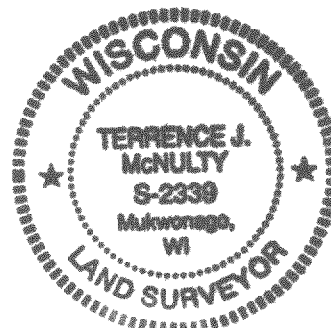

PMR1-42

418-1203