




PLAT OF SURVEY


DESCRIPTION:
 LOT THIRTY-SIX (36) IN BLOCK ONE (1) IN MIRAMAR SUBDIVISION BEING A SUBDIVISION LOCATED IN SECTIONS TEN (10) AND ELEVEN (11), IN TOWNSHIP FOUR (4) NORTH, RANGE EIGHTEEN (18) EAST, IN THE TOWN OF EAST TROY, WALWORTH COUNTY, WISCONSIN.

C.L. MIRAMAR DRIVE (66' WIDE)

LOT 36 LOT 35

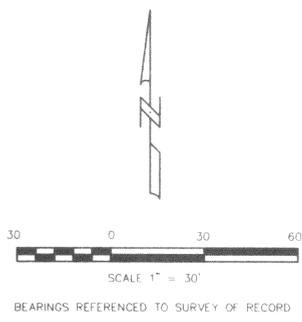

- LEGEND**
- FOUND IRON PIPE
 - FOUND IRON ROD
 - SET 1 IN. IRON PIPE
 - WATER WELL

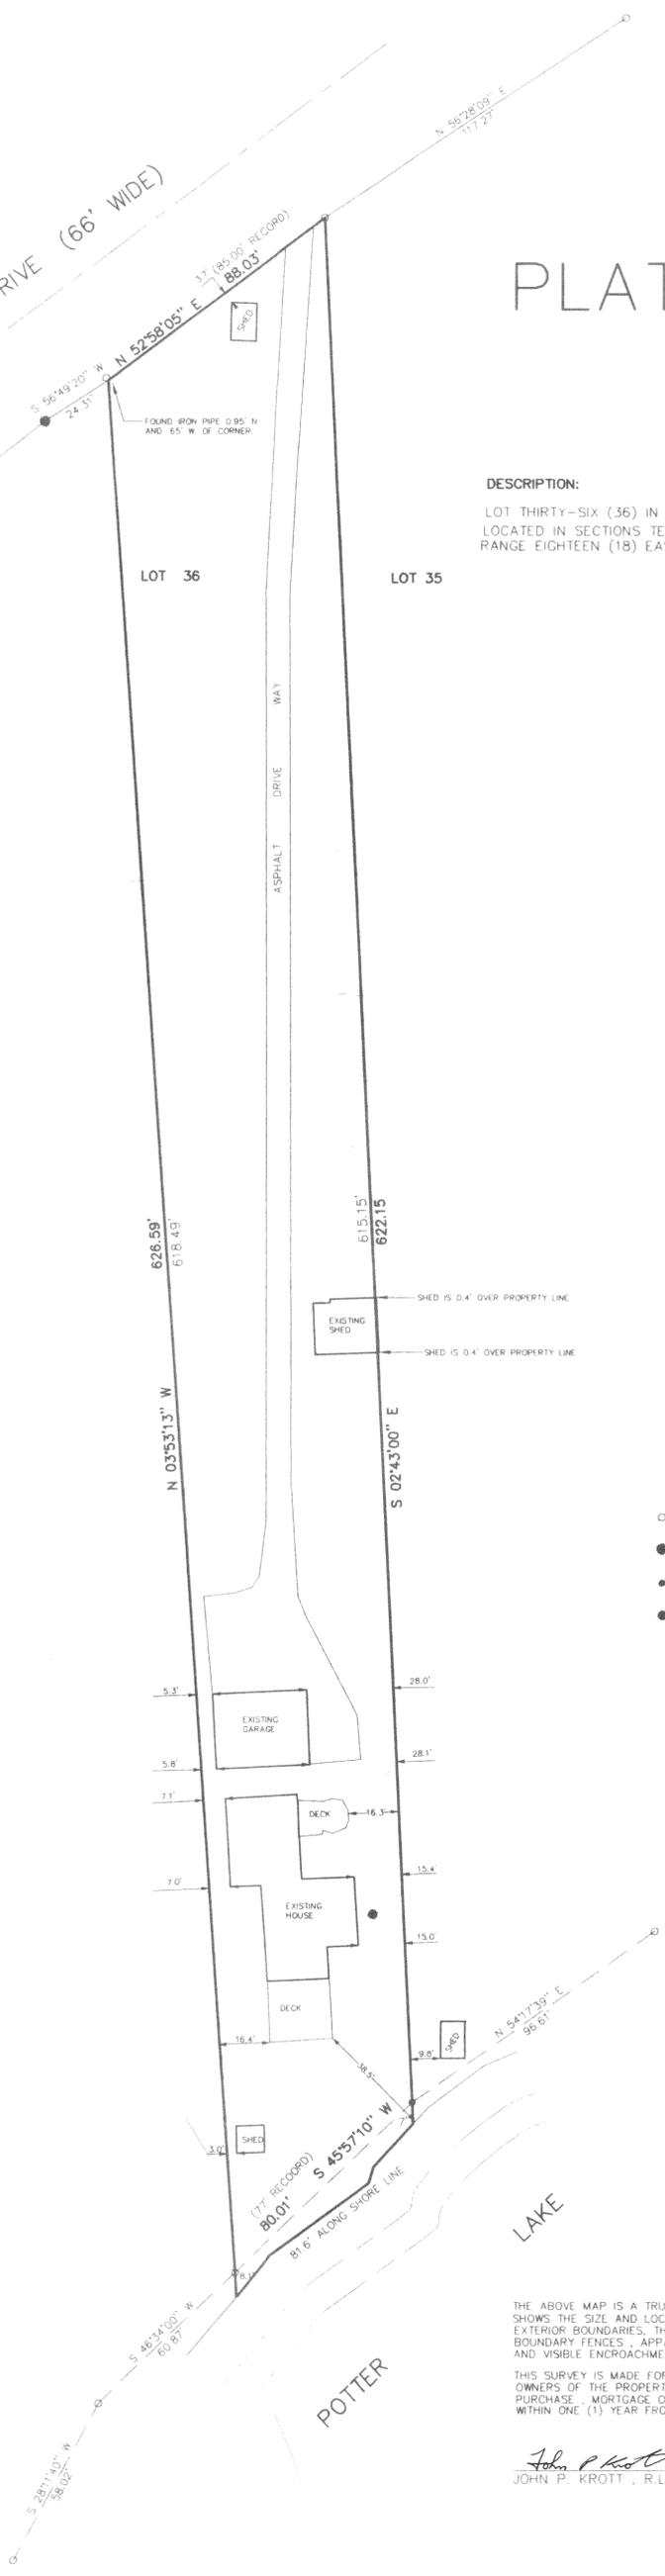

OWNER: SAMSON J. AND MARCIA E. BEAVER

PATHFINDER SURVEYING
 FORMERLY KOLB LAND CONSULTING, INC.
 920 WILLIAMS STREET, LAKE GENEVA WISCONSIN 53147
 414-248-3697

THE ABOVE MAP IS A TRUE REPRESENTATION THEREOF AND SHOWS THE SIZE AND LOCATION OF ALL THE PROPERTY, EXTERIOR BOUNDARIES, THE LOCATION OF ALL VISIBLE BOUNDARY FENCES, APPARENT EASEMENTS, ROADWAYS AND VISIBLE ENCROACHMENTS, IF ANY.

THIS SURVEY IS MADE FOR THE USE OF THE PRESENT OWNERS OF THE PROPERTY, AND ALSO THOSE WHO PURCHASE, MORTGAGE OR GUARANTEE TITLE THERETO WITHIN ONE (1) YEAR FROM DATE HERETO.

John P. Krott
 JOHN P. KROTT, R.L.S. 2258



DATE: 11-30-1997
 NOTE: THIS IS NOT A CERTIFIED COPY UNLESS SEAL IS IN RED

PMR-26 418-1215