
PLAT OF SURVEY

RSV ENGINEERING, INC ENGINEERS PLANNERS SURVEY CONSTRUCTION MANAGERS, ENVRIONMENTAL SCIENTISTS

FOR: THOMAS JENDERS

REVISION: 8-14-97 DATE: 7-8-97

DESCRIPTION: LOT 6, LAKE BEULAH ESTATES, BEING A DIVISION OF LOTS 4, 5, AND PART OF 3 OF STEVENS SUBDIVISION IN GOVERNMENT LOT 1, NORTH-EAST 1/4, SECTION 8, TOWNSHIP 4 NORTH, RANGE 18 EAST, IN THE TOWN OF EAST TROY, WALWORTH COUNTY, WISCONSIN.

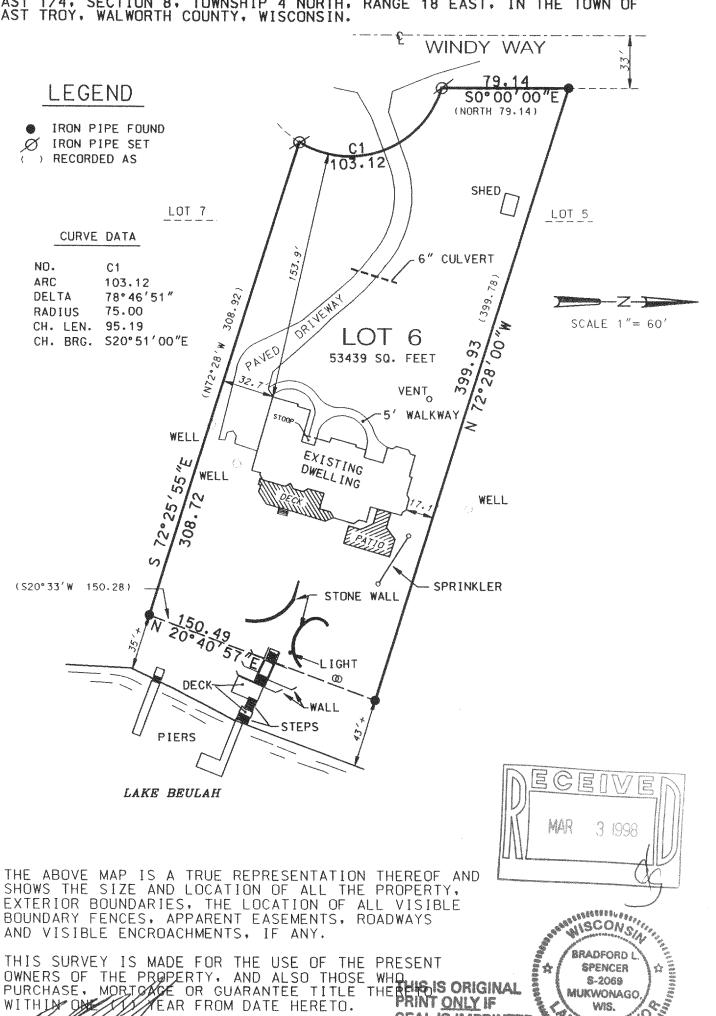

BRADFORD L. SPENCER, R.L.S. 2069 RSV#97157.DGN

SEAL IS IMPRINTED

IN RED

\$-2069 MUKWONAGO

SURVE

SURVENI