
## SURVEY PLAT

ENGINEERING, INC ENGINEERA PLANNERS, SUR VE-CONSTRUCTION MANAGERA, ENVIRONMENTAL SCIENTISTS 801 MAIN STREET. MIKWO AOO. WESCONSIN 53149 (414) 363-20

FOR: CLAIR TIEDE

DATE: 12-10-97

DESCRIPTION: LOTS 6, 7, 8 AND PART OF 9 OF DAKWOOD PARK, A SUBDIVISION LOCATED IN PART OF GOVERNMENT LOT 2 IN THE NE' OF SECTION 8, TOWN 4 NORTH, RANGE 18 EAST, TOWN OF EAST TROY, WALWORTH COUNTY, WISCONSIN, MORE PARTICULARLY DESCRIBED AS FOLLOWS: BEGINNING AT THE NORTHEAST CORNER OF SAID LOT 6, THENCE \$49°34'52"E, A DISTANCE OF 169.13'; THENCE \$00°00'32"W, A DISTANCE OF 231.32' TO A POINT MEANDERING THE SHORE OF LAKE BEULAH; THENCE WITH THE FOLLOWING BEARINGS AND DISTANCES ALONG A MEANDER LINE: \$67°18'31"W, 52.74'; THENCE N51°04'34"W, 25.26'; THENCE N50°52'25"W, 77.88' TO A MEANDER POINT ON THE WEST LINE OF SAID LOT 6; THENCE N00°00'00"E, 296.31' TO THE POINT OF BEGINNING, ALSO INCLUDING LANDS BETWEEN THE MEANDER LINE AND THE HIGH WATER LINE OF LAKE BEULAH. SAID PARCEL CONTAINING 0.835 ACRES, MORE OR LESS.

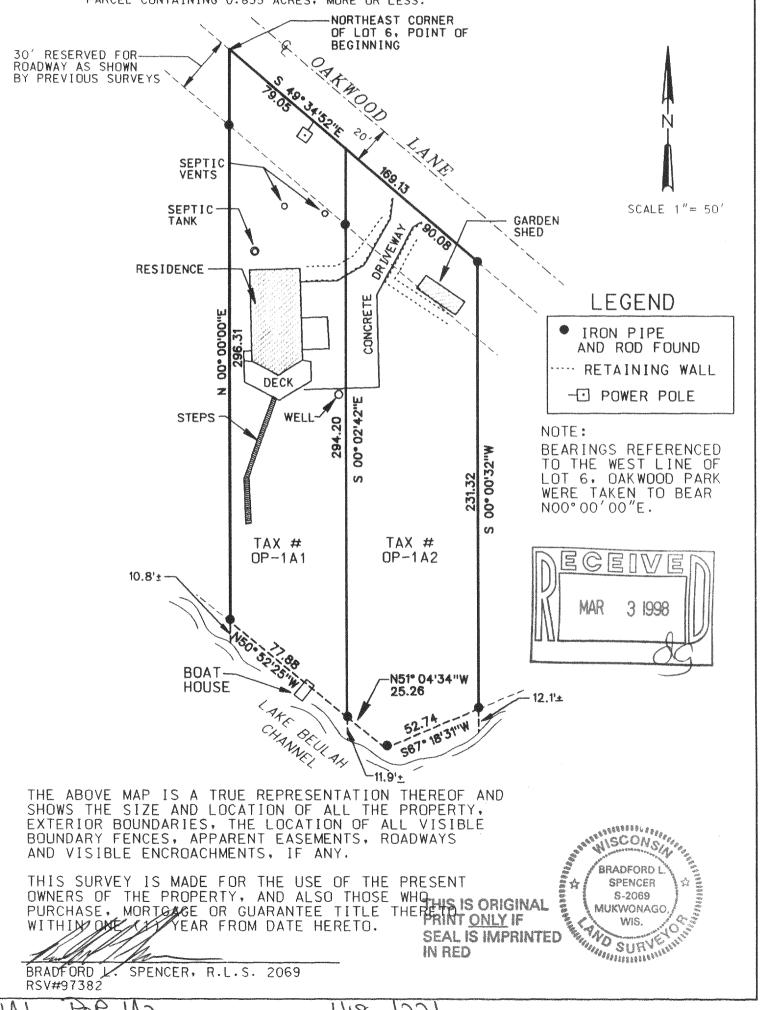

BRADFORD 1.

RSV#97382

SPENCER, R.L.S. 2069

IN RED