


PLAT OF SURVEY

LOT 13, IN THE SUBDIVISION OF LOT 10, IN BEULAH LAKE PARK, all on Section 4, Township 4 North, Range 18 East, Walworth County, Wisconsin, including all rights in the alley way.

Surveyed for: Arthur L. Ebert

Survey address: 9350 Beulah Park Road

- SET 1" IRON PIPE
- FOUND 1" IRON PIPE
- ( ) RECORDED AS DIMENSIONS

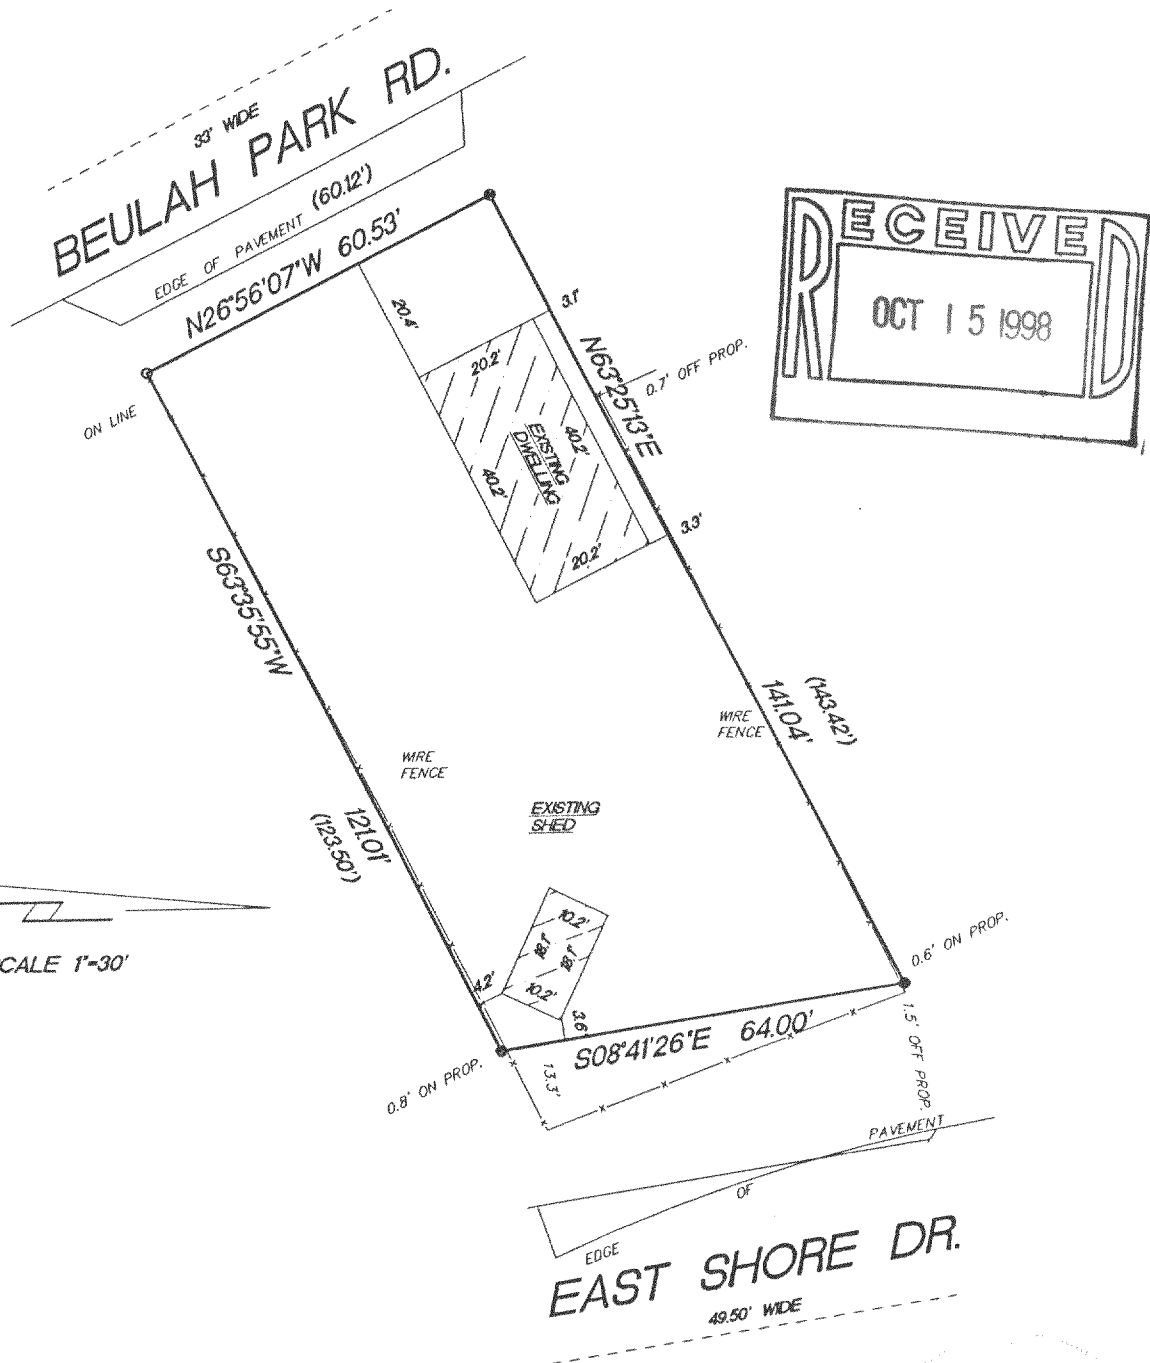

"I hereby certify that I have surveyed the above described property and that the above map is a true representation thereof and shows the size and location of the property, its exterior boundaries, the location of all visible structures and dimension of all principal buildings thereon, boundary fences, apparent easements, roadways and encroachments if any."

"This survey is made for the use of the present owners of the property, and also those who purchase, mortgage or guarantee the title thereto within one year from date hereof."



W362 S10227 Lewin Lane  
Eagle, Wisconsin 53119  
Terrance E. Pisarek R.L.S.

(414) 594-3484  
fax (414) 594-5904

THIS IS NOT AN ORIGINAL SURVEY UNLESS THE SEAL IS RED.

8/26/98  
DATE

TEP/PG  
FIELD WORK BY

TEP  
DRAWN BY

98184  
JOB NUMBER

PBLA-16

418-1248