

DEGEN, FOAT SURVEYING ASSOCIATES



100 SOUTH SECOND STREET
WATERFORD, WISCONSIN
(414)534-5404 (FAX)534-2022

982430
982430S1.DWG

PLAT OF SURVEY

LOT 2 AND 3, BLOCK 3, MIRAMAR SUBDIVISION, BEING A SUBDIVISION OF LOCATED IN SECTIONS 10 AND 11, TOWN 4 NORTH, RANGE 18 EAST, COUNTY OF WALWORTH, STATE OF WISCONSIN.

SURVEY PREPARED FOR: JAMES KRUEGER
N 9144 PINE AVENUE
EAST TROY, WI 53120

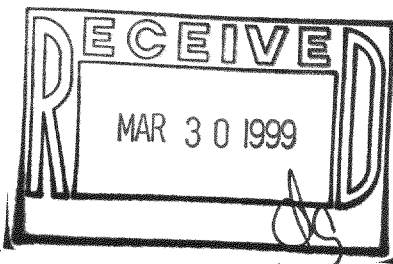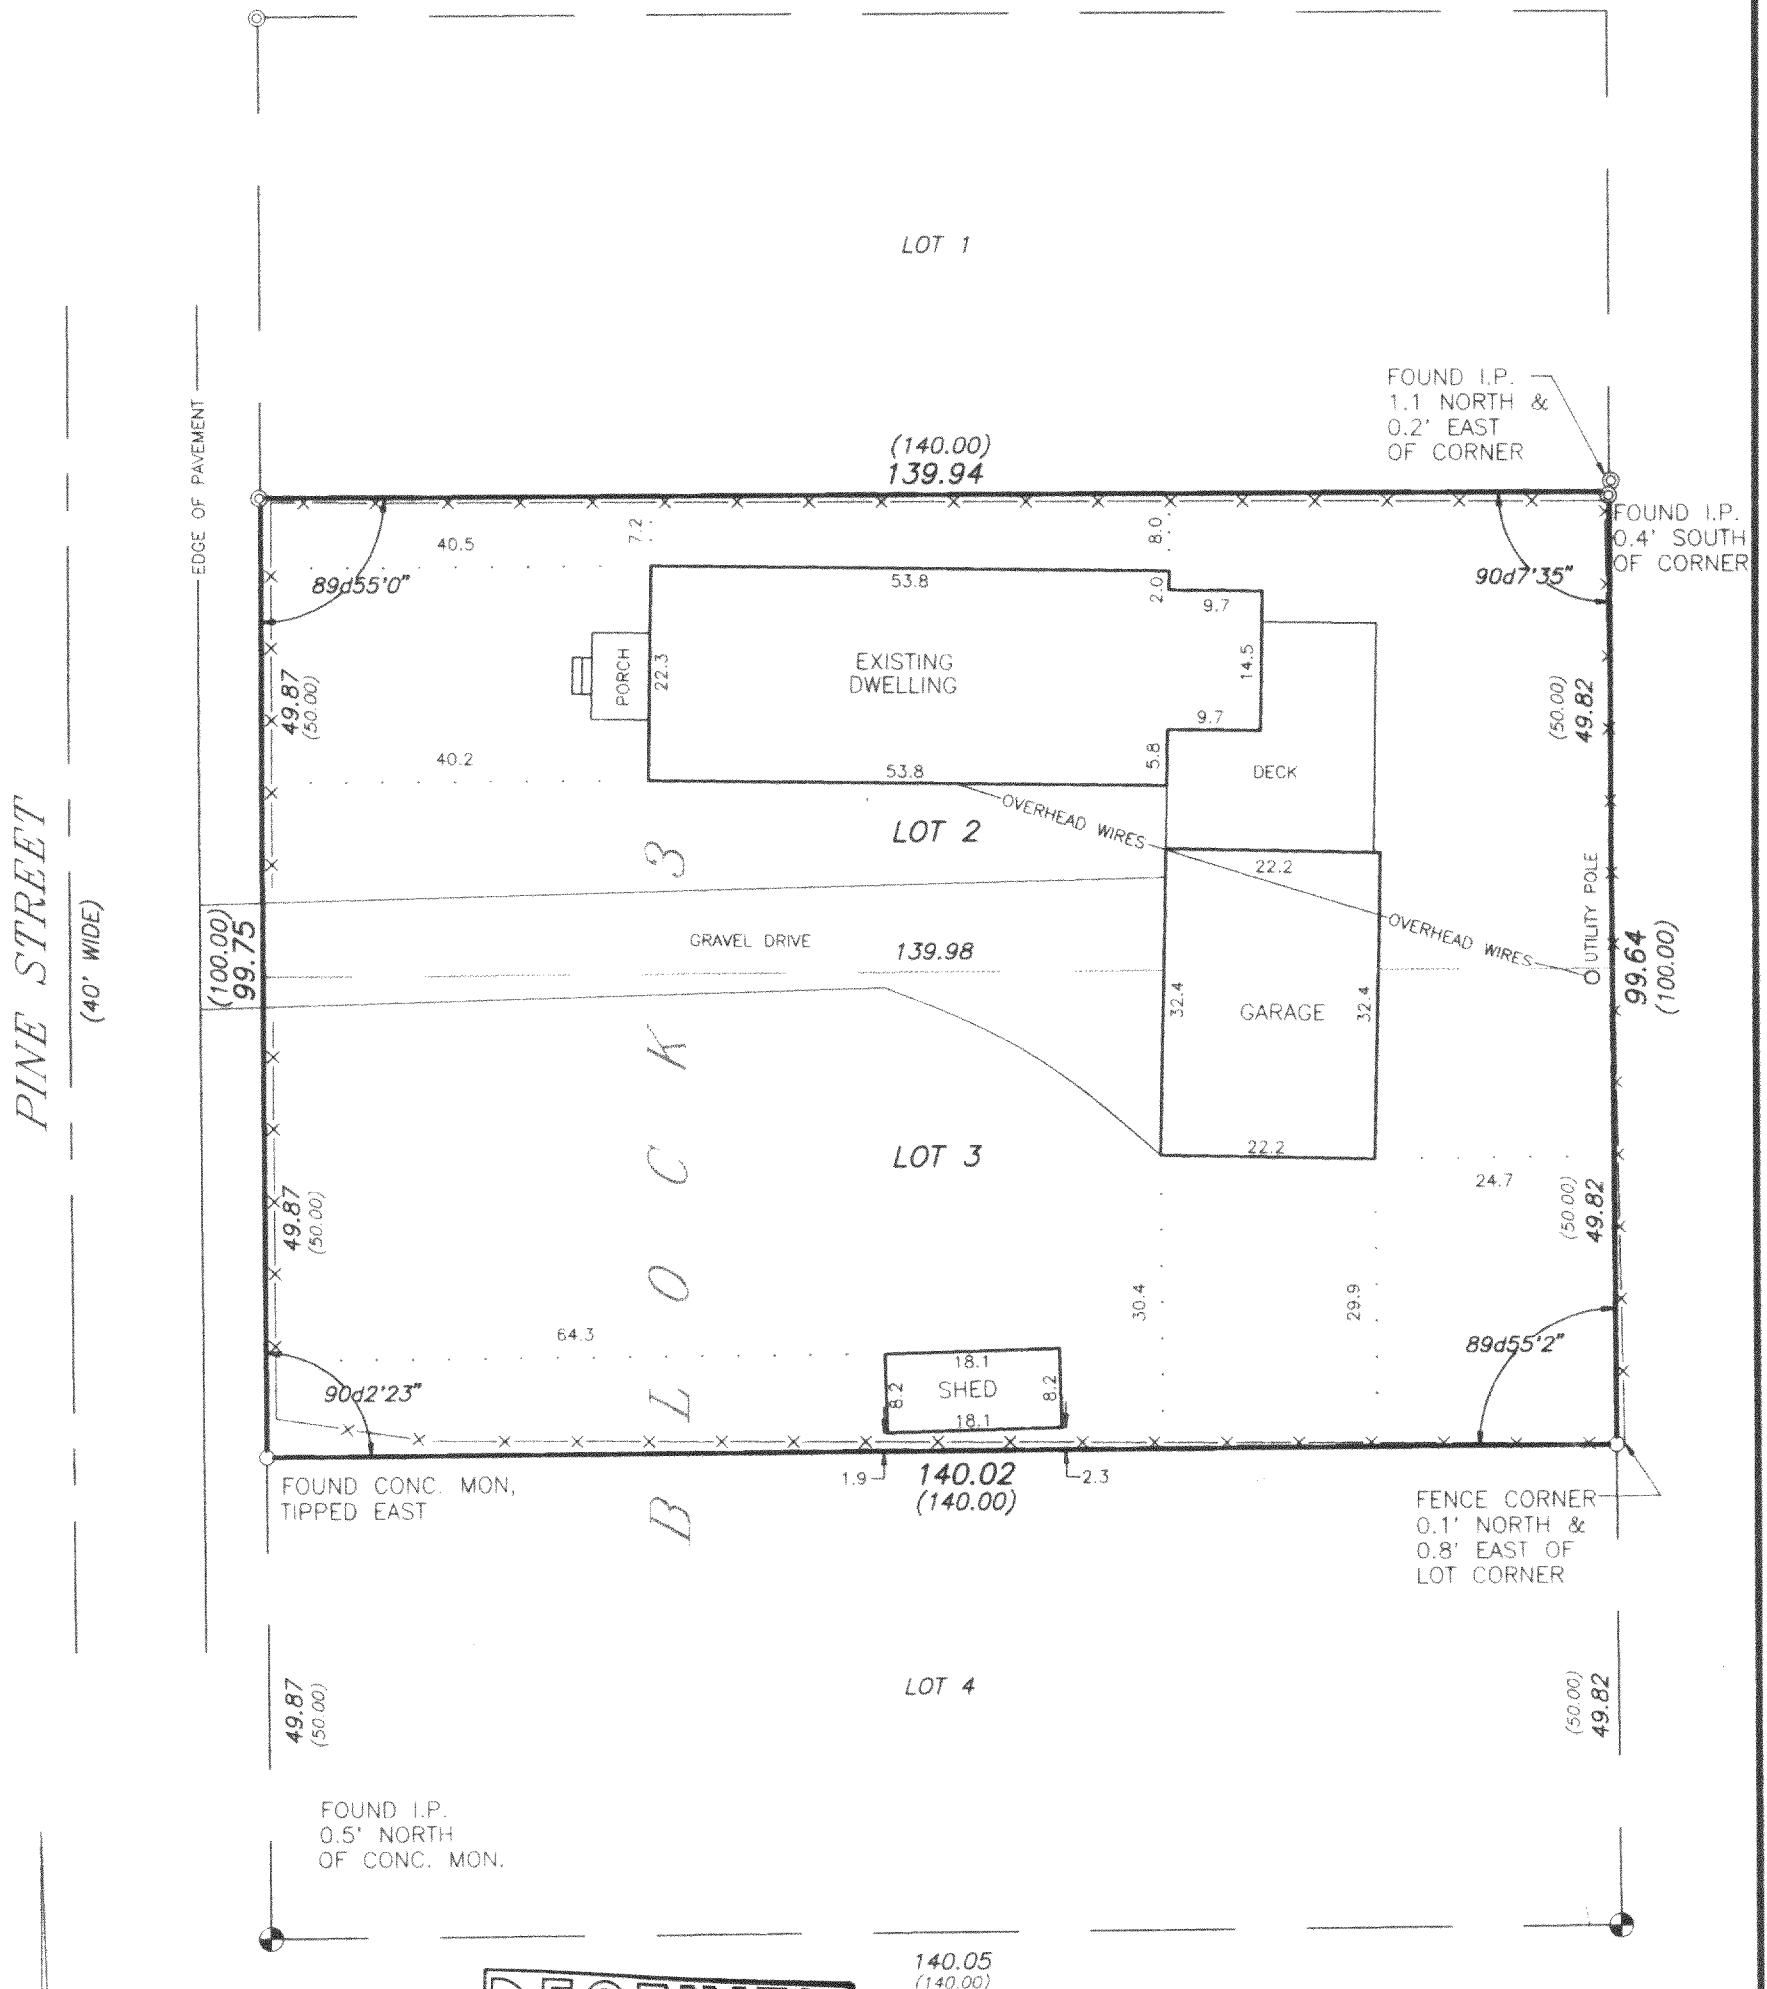

LEGEND

- ⊕ - FOUND CONCRETE MONUMENT
- ⊙ - FOUND IRON PIPE
- - SET IRON PIPE
- x--- - CHAIN LINK FENCE
- () - RECORDED AS

I HEREBY CERTIFY THAT I HAVE SURVEYED THE ABOVE DESCRIBED PROPERTY AND THE ABOVE MAP IS A TRUE REPRESENTATION THEREOF AND SHOWS THE SIZE AND LOCATION OF THE PROPERTY, THE LOCATION OF ALL VISIBLE STRUCTURES AND DIMENSIONS OF ALL PRINCIPAL BUILDINGS THEREON, BOUNDARY FENCES, APPARENT EASEMENTS, ROADWAY AND VISIBLE ENCROACHMENTS, IF ANY.

THIS SURVEY IS MADE FOR THE PRESENT OWNERS OF THE PROPERTY, AND ALSO THOSE WHO PURCHASE, OR GUARANTEE THE TITLE THERETO WITHIN (1) YEAR FROM THE DATE HEREOF.

DATED AT WATERFORD, WI THIS 30th DAY OF NOVEMBER 1998

RECERTIFIED

Greg Deft

SCALE: 1" = 20'

PMR-41

418-1272