


FARRIS, HANSEN & ASSOCIATES, INC.


ENGINEERING, ARCHITECTURE, SURVEYING
 7 RIDGWAY COURT - P.O. BOX 437, ELKHORN, WISCONSIN, 53121
 PHONE: (414) 723-2098 FAX: (414) 723-5886

PLAT OF SURVEY LOT 3 OF C.S.M. 1241


- WORK ORDERED BY -
 JOHN SONDEREGGER
 W.2032 KINGS PARKWAY
 EAST TROY, WI. 53120

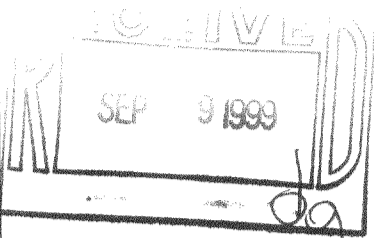

LOCATED IN THE NW 1/4 & SW 1/4 OF SECTION 17,
 T. 4 N., R. 18 E., WALWORTH COUNTY, WISCONSIN

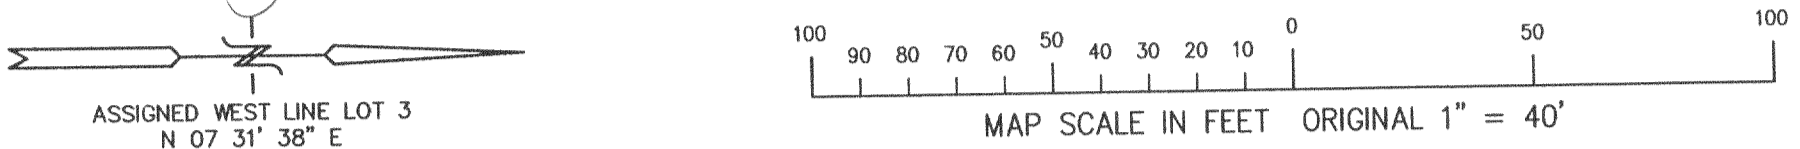

ASSIGNED WEST LINE LOT 3
 N 07° 31' 38" E

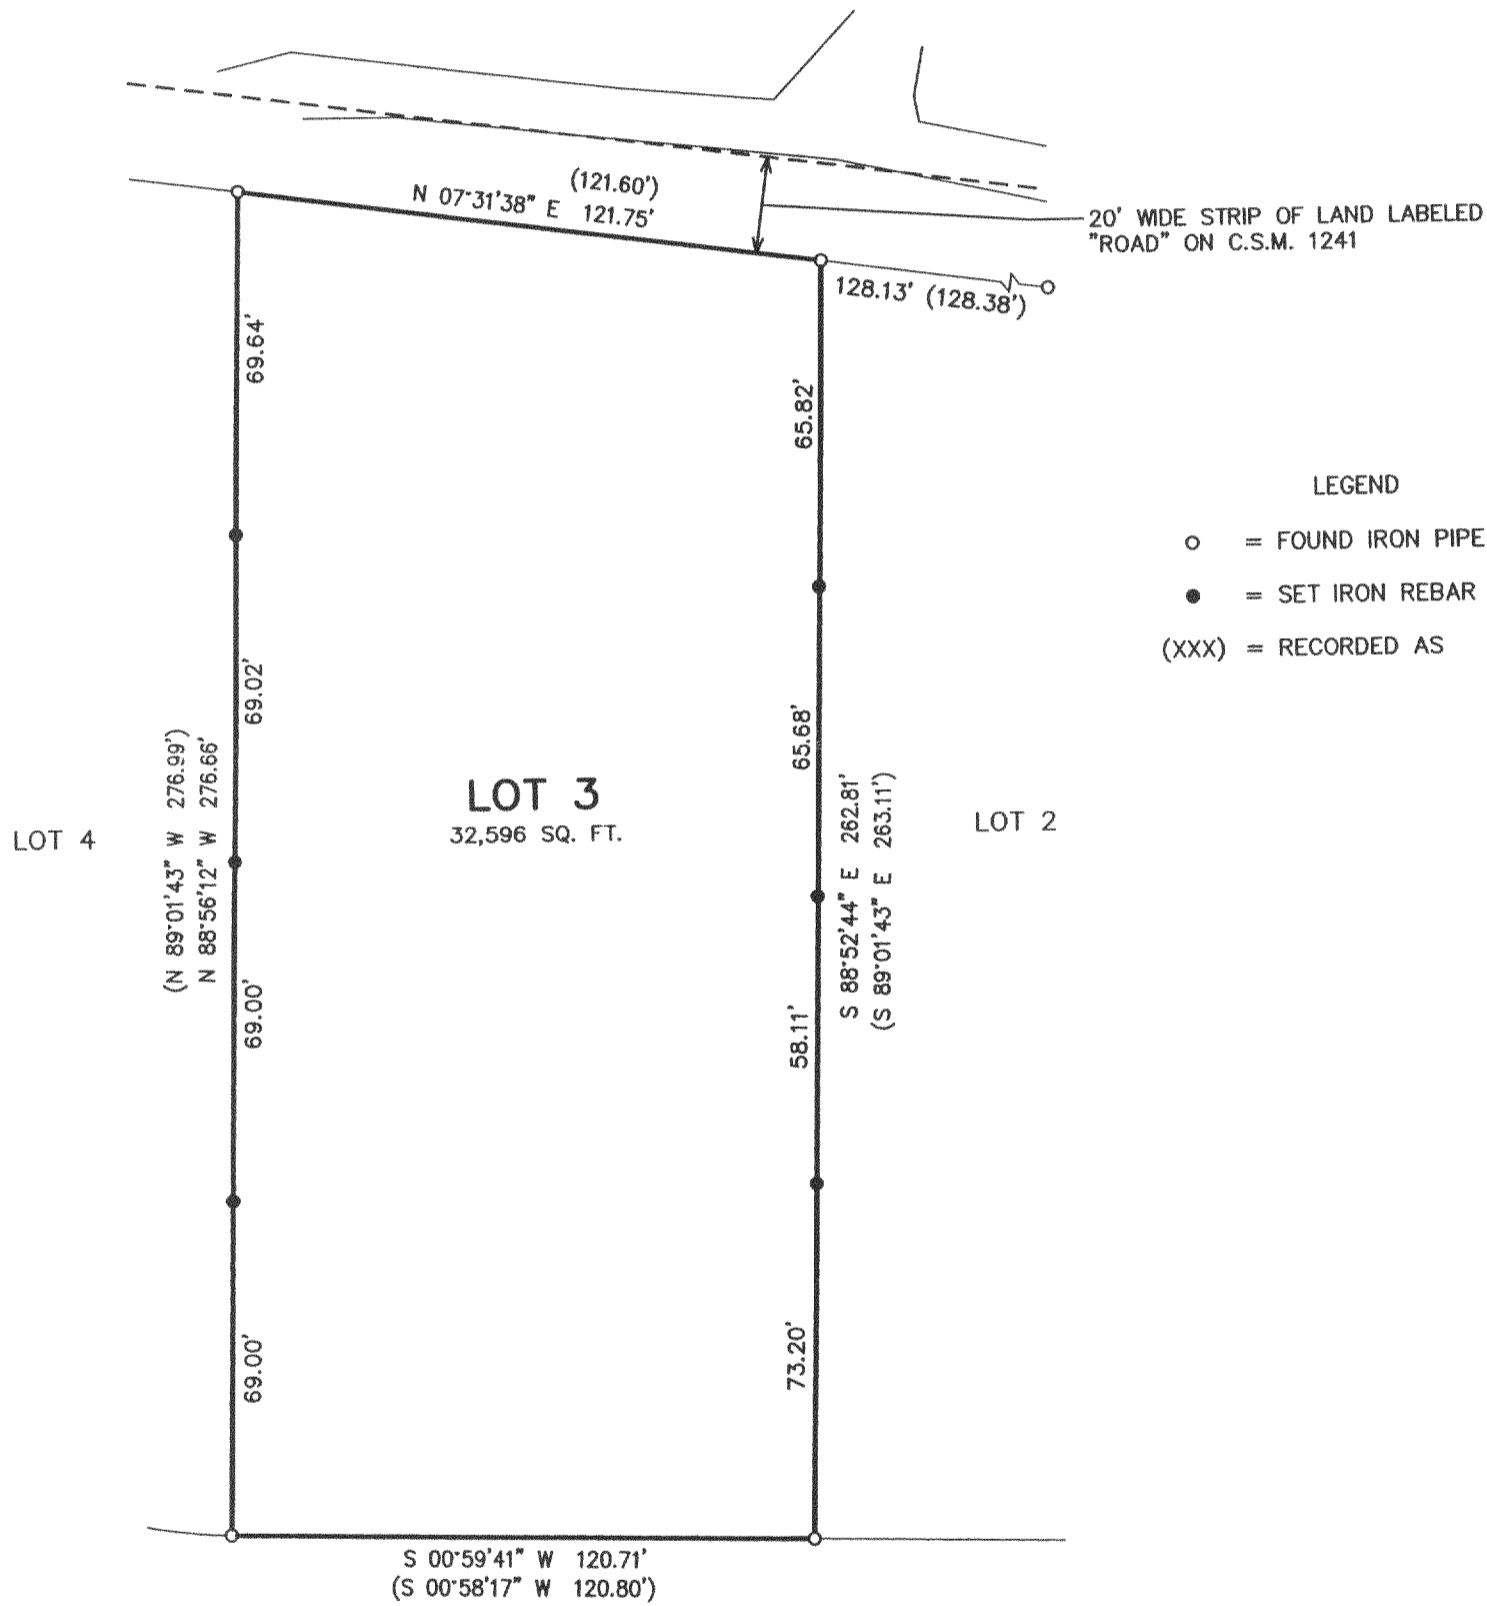

LEGEND

- = FOUND IRON PIPE STAKE
- = SET IRON REBAR STAKE
- (XXX) = RECORDED AS

NOTE: COPIES OF THIS MAP TO WHICH THE FOLLOWING CERTIFICATE WILL APPLY SHOW THE SURVEYOR'S ORIGINAL SEAL AND SIGNATURE IN RED INK. COPIES BY ANY OTHER MEANS MAY HAVE ALTERATIONS WHICH DO NOT REPRESENT THE SURVEYOR'S WORK PRODUCT.

I HEREBY CERTIFY THAT THE ABOVE DESCRIBED PROPERTY HAS BEEN SURVEYED UNDER MY DIRECTION AND THAT THE ABOVE MAP IS A TRUE REPRESENTATION THEREOF AND SHOWS THE SIZE AND LOCATION OF THE PROPERTY AND ITS EXTERIOR BOUNDARIES. THIS SURVEY IS MADE FOR THE USE OF THE PRESENT OWNERS OF THE PROPERTY, AND ALSO THOSE WHO PURCHASE, MORTGAGE, OR GUARANTEE THE TITLE THERETO WITHIN ONE YEAR FROM THE DATE HEREOF.

DATED: 9/2/99

PETER S. GERDON R.L.S. 2101



PROJECT: 5335
 DATE: 08/05/99
 SHEET 1 OF 1

PA-1241-3
 418-1319