
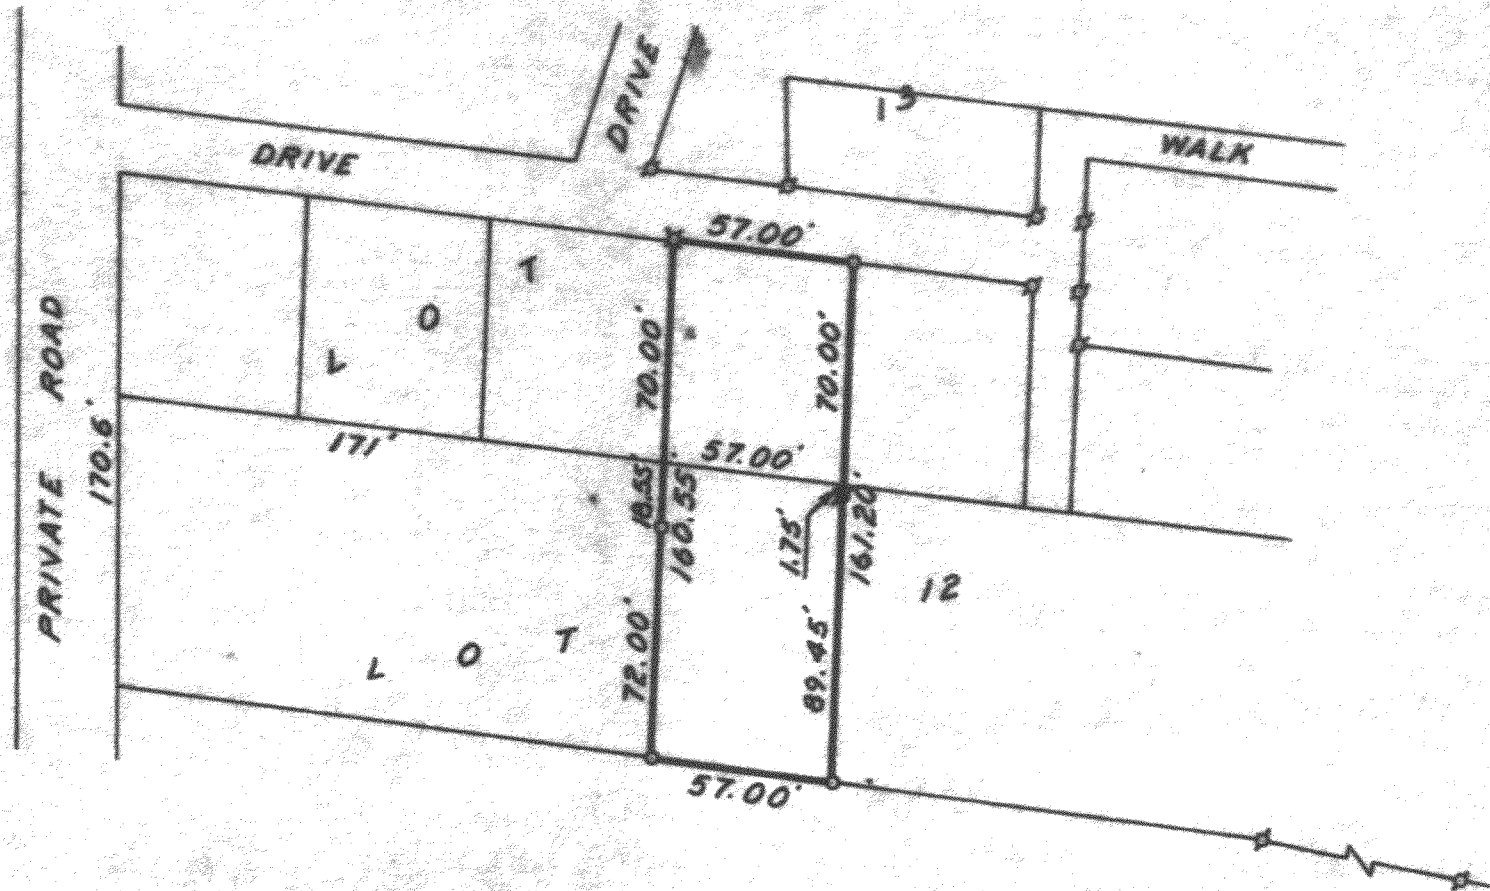


HAROLD H. KOLB
 REGISTERED PROFESSIONAL LAND SURVEYOR
 LAKE GENEVA, WISCONSIN

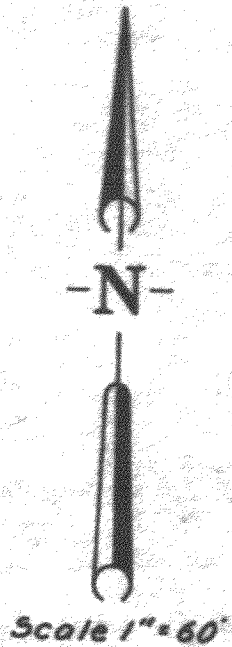

PLAT OF SURVEY OF
 Part of Lots 12 and 13, Romadka Park, a subdivision located
 in Walworth County, Wisconsin.

Harold H. Kolb
 Harold H. Kolb, Wisconsin Surveyor, S-187
 DATE: July 13, 1964.

- ⊠ Mark Found - Iron Pipe Placed
- Iron Pipe Found
- Iron Rod Found
- Iron Pipe Placed

PRP-13.160

418-134